

LEGEND

FINISHED GRADE LINE

FINISHED FLOOR LINE

1/2 X

ROOF PITCH LABEL (RISE/RUN)

PPM

PRECISION PROPERTY MEASUREMENTS

3626 E. PACIFIC COAST HIGHWAY | 2ND FLOOR
 LONG BEACH CA | 90804
 T 562.621.9100
 F 888.698.2966
 WWW.PPMCO.NET



PREPARED FOR

CLIENT NAME

PROJECT TYPE

EXTERIOR ELEVATIONS

PROJECT NAME

COUNTRY CLUB

PROJECT ADDRESS

STREET
 CITY, ST 00000

All plans created by Precision Property Measurements, LLC ("PPM") are made exclusively for landscaping purposes. CA, Title, & Post Code 90727. All data plans created by PPM do not include the determination of any property line, and as such do not constitute legal advice. CA, Title, & Post Code 90727. In addition, PPM services are not intended to constitute an engineering CA, Title, & Post Code 90727. All data plans created by PPM are intended to be used as a reference for design and construction and should not be considered a substitute for the services of a licensed structural engineer or licensed architect. PPM makes every reasonable effort to ensure the accuracy of the information located on our plans. However, some inaccuracies may exist. PPM's liability is limited to the amount of the fee paid to PPM.


SCALE
 3/16" = 1'-0"

PROJECT
 0000_ZZ

APPROVED BY
 XX

DATE
 00/00/2023

SHEET
 11 of 15

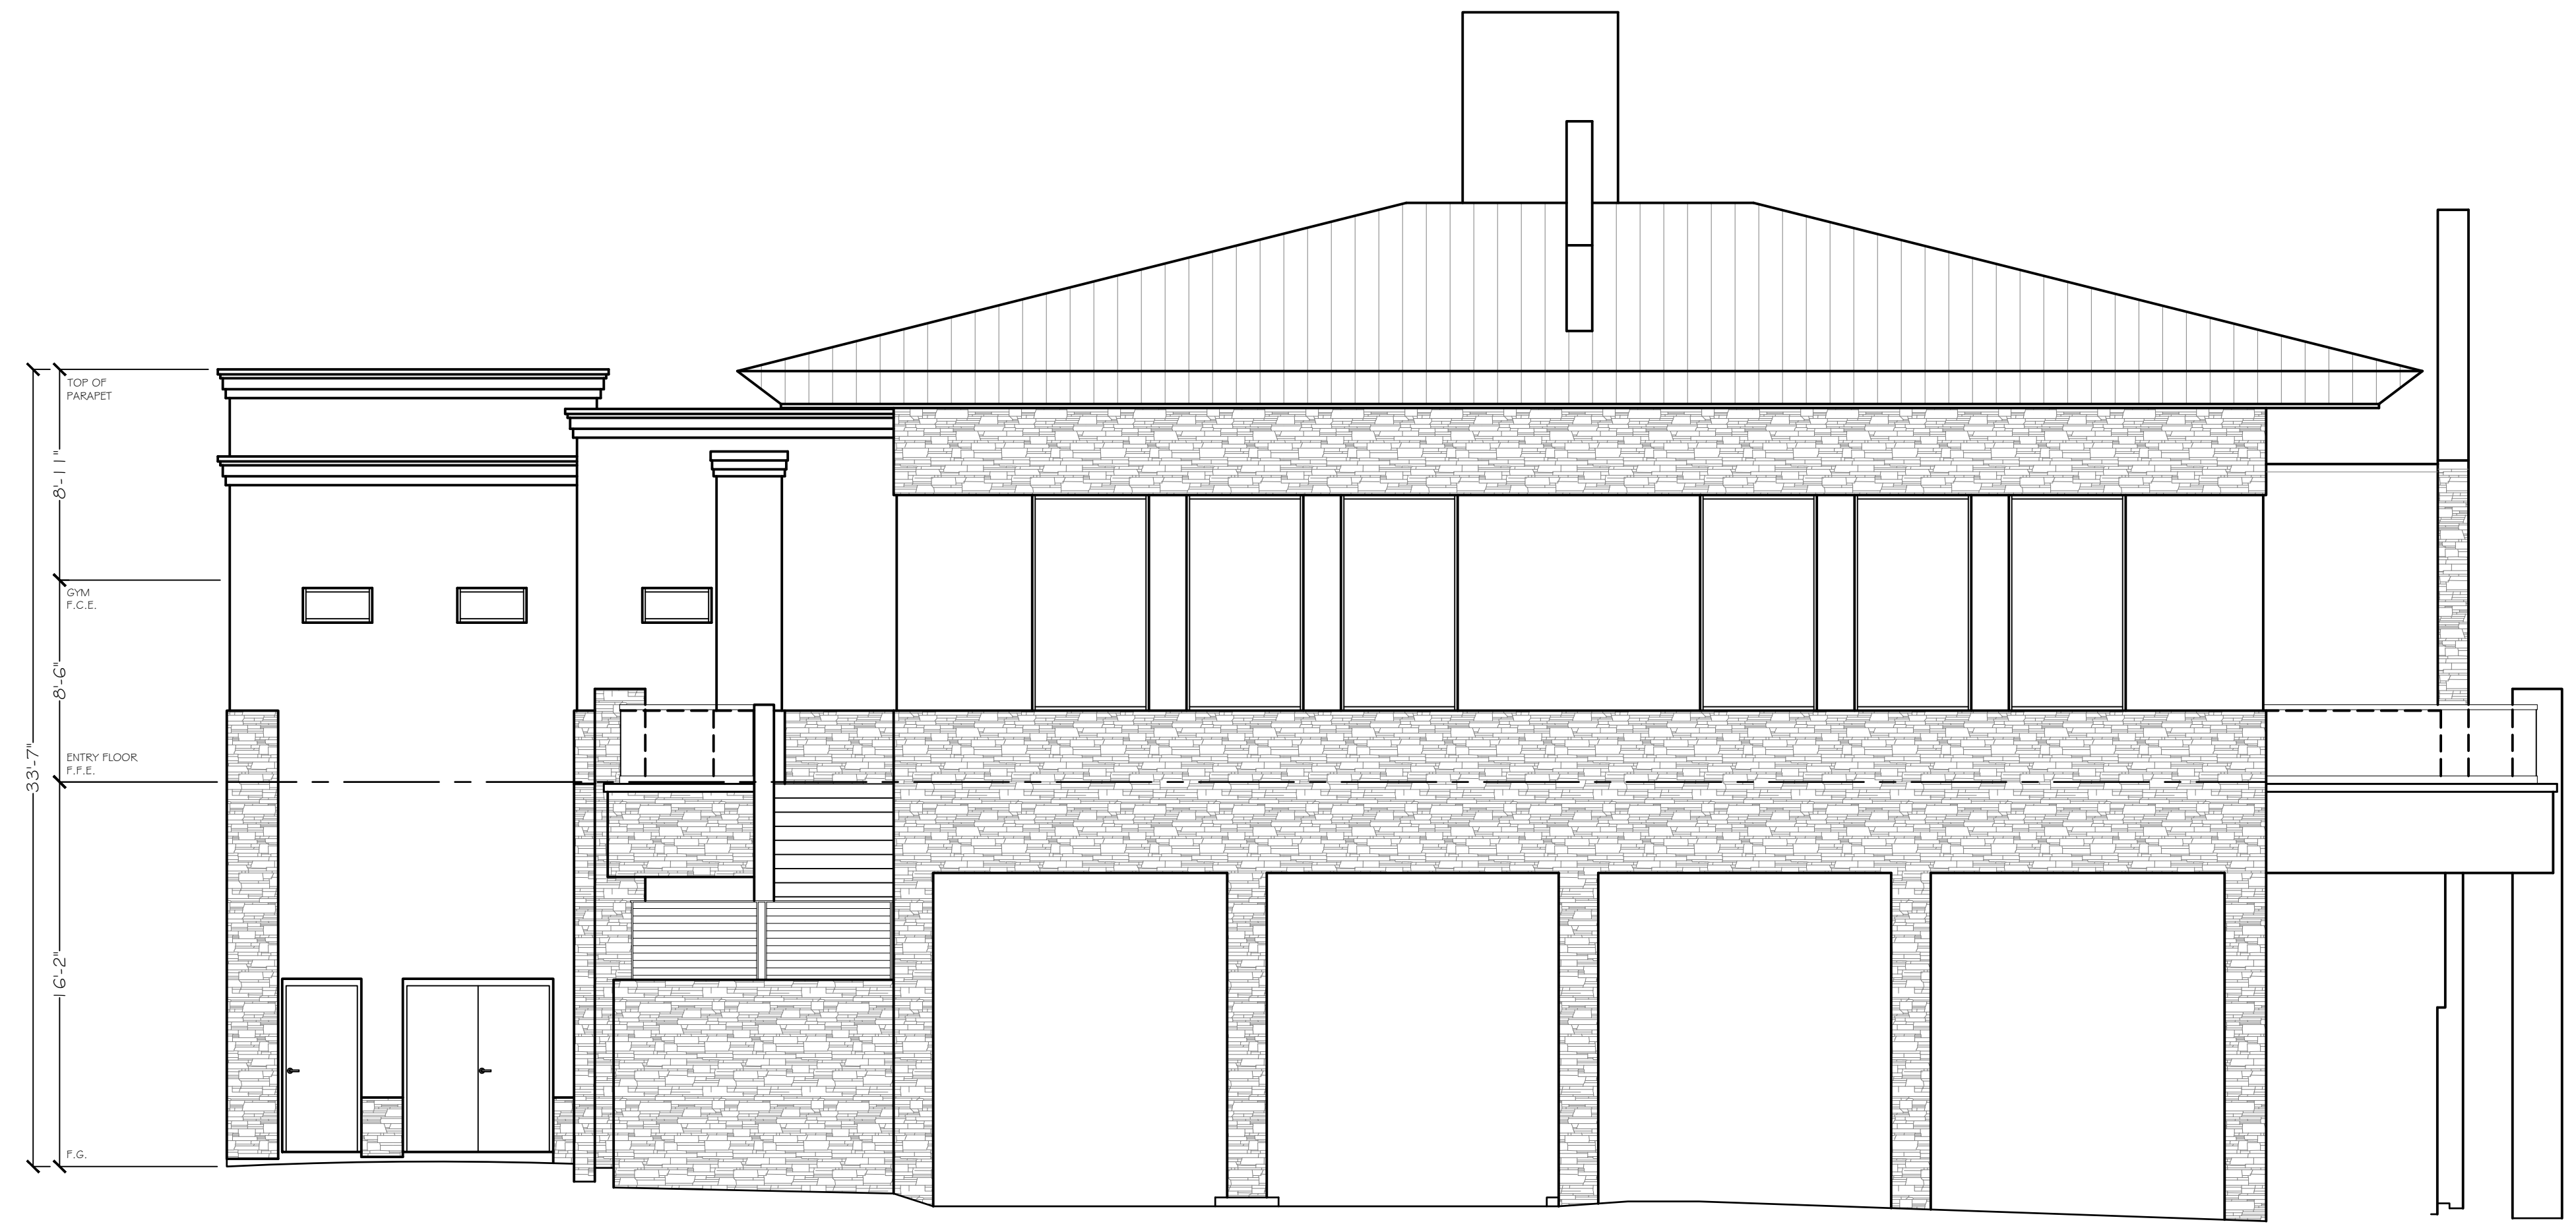


ELEVATION - A



ELEVATION - B



ELEVATION - C

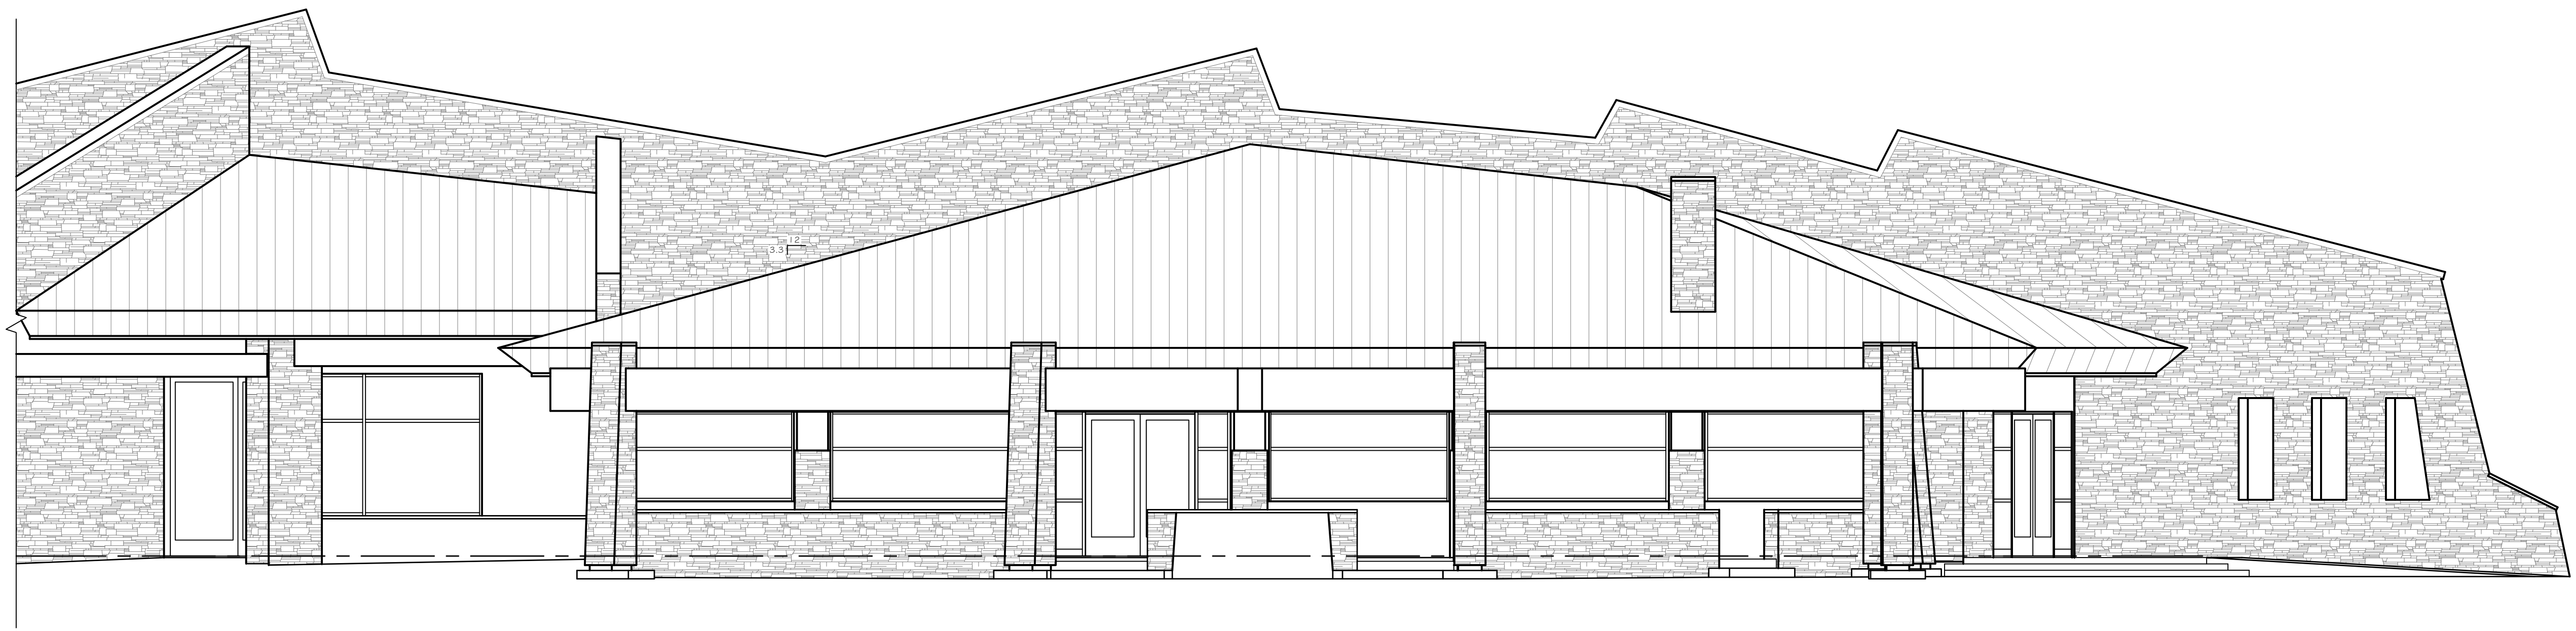

ELEVATION - D

LEGEND

FINISHED GRADE LINE
 FINISHED FLOOR LINE
 1/2" X
 ROOF PITCH LABEL (RISE/RUN)

PPM
PRECISION PROPERTY MEASUREMENTS
 3626 E. PACIFIC COAST HIGHWAY | 2ND FLOOR
 LONG BEACH CA | 90804
 T 562.621.9100
 F 888.698.2966
 WWW.PPMCO.NET



PREPARED FOR

CLIENT NAME

PROJECT TYPE

EXTERIOR ELEVATIONS

PROJECT NAME

COUNTRY CLUB

PROJECT ADDRESS

STREET
 CITY, ST 00000

All plans created by Precision Property Measurements, LLC (PPM) are made exclusively for landscaping purposes (i.e., this is not a Professional Engineer (P.E.) or Professional Architect (P.A.) drawing). All site plans created by PPM do not include the determination of any property line, and as such do not constitute legal advice.
 (i.e., this is not a Final Code (FC) or Final Code (FC) drawing). In addition, PPM services and plans do not constitute an engineering (i.e., this is not a Professional Engineer (P.E.) or Professional Architect (P.A.) drawing) and this should not be used for any studies or activities defined as civil engineering (i.e., this is not a Professional Engineer (P.E.) or Professional Architect (P.A.) drawing). All floor plans created by PPM are intended to be used as a reference for design and construction and should not be considered a substitute for the services of a licensed structural engineer or licensed architect. PPM makes every reasonable effort to ensure the accuracy of the information located on or attached to these plans. However, some errors may occur due to human error or other factors. PPM is not responsible for any errors or omissions. It is the duty of the architect, contractor, designer or other licensed professional, as a consultant to the property owner, to determine the suitability of the As-Built plans prior to construction. Measurements should be field confirmed before commencing construction. In the event that an error is found on a plan, PPM's liability is limited to the amount of the fee paid to PPM.

SCALE
 3/16" = 1'-0"

PROJECT
 0000_ZZ

APPROVED BY
 XX


DATE
 00/00/2023

SHEET


13 of 15




ELEVATION - E

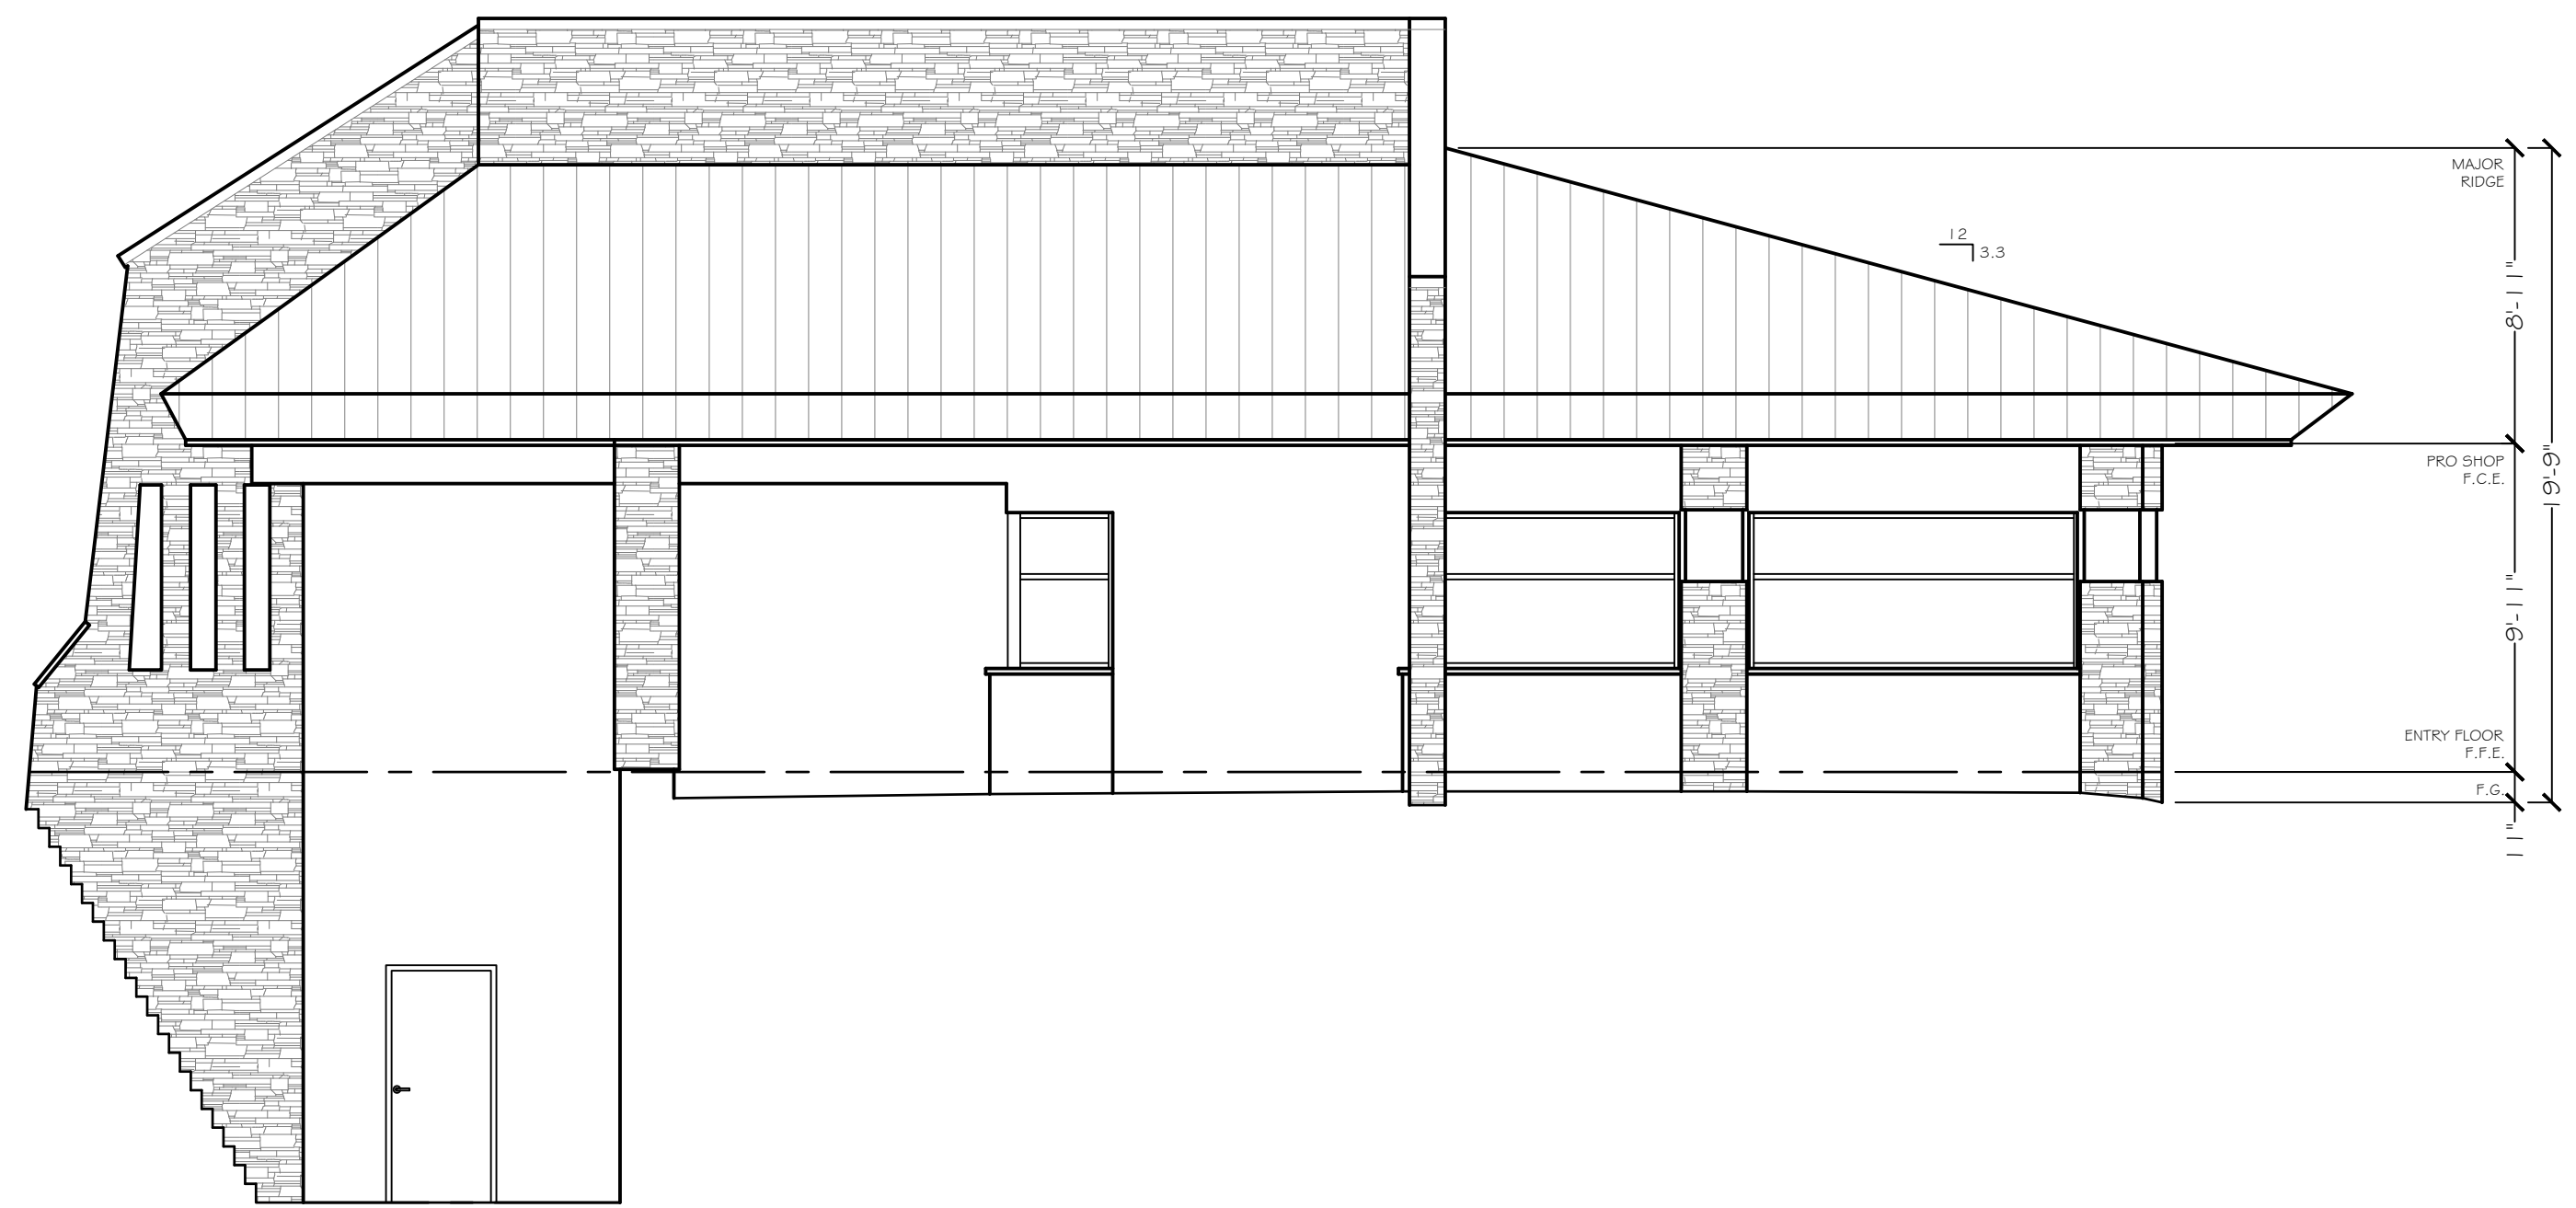


ELEVATION - F

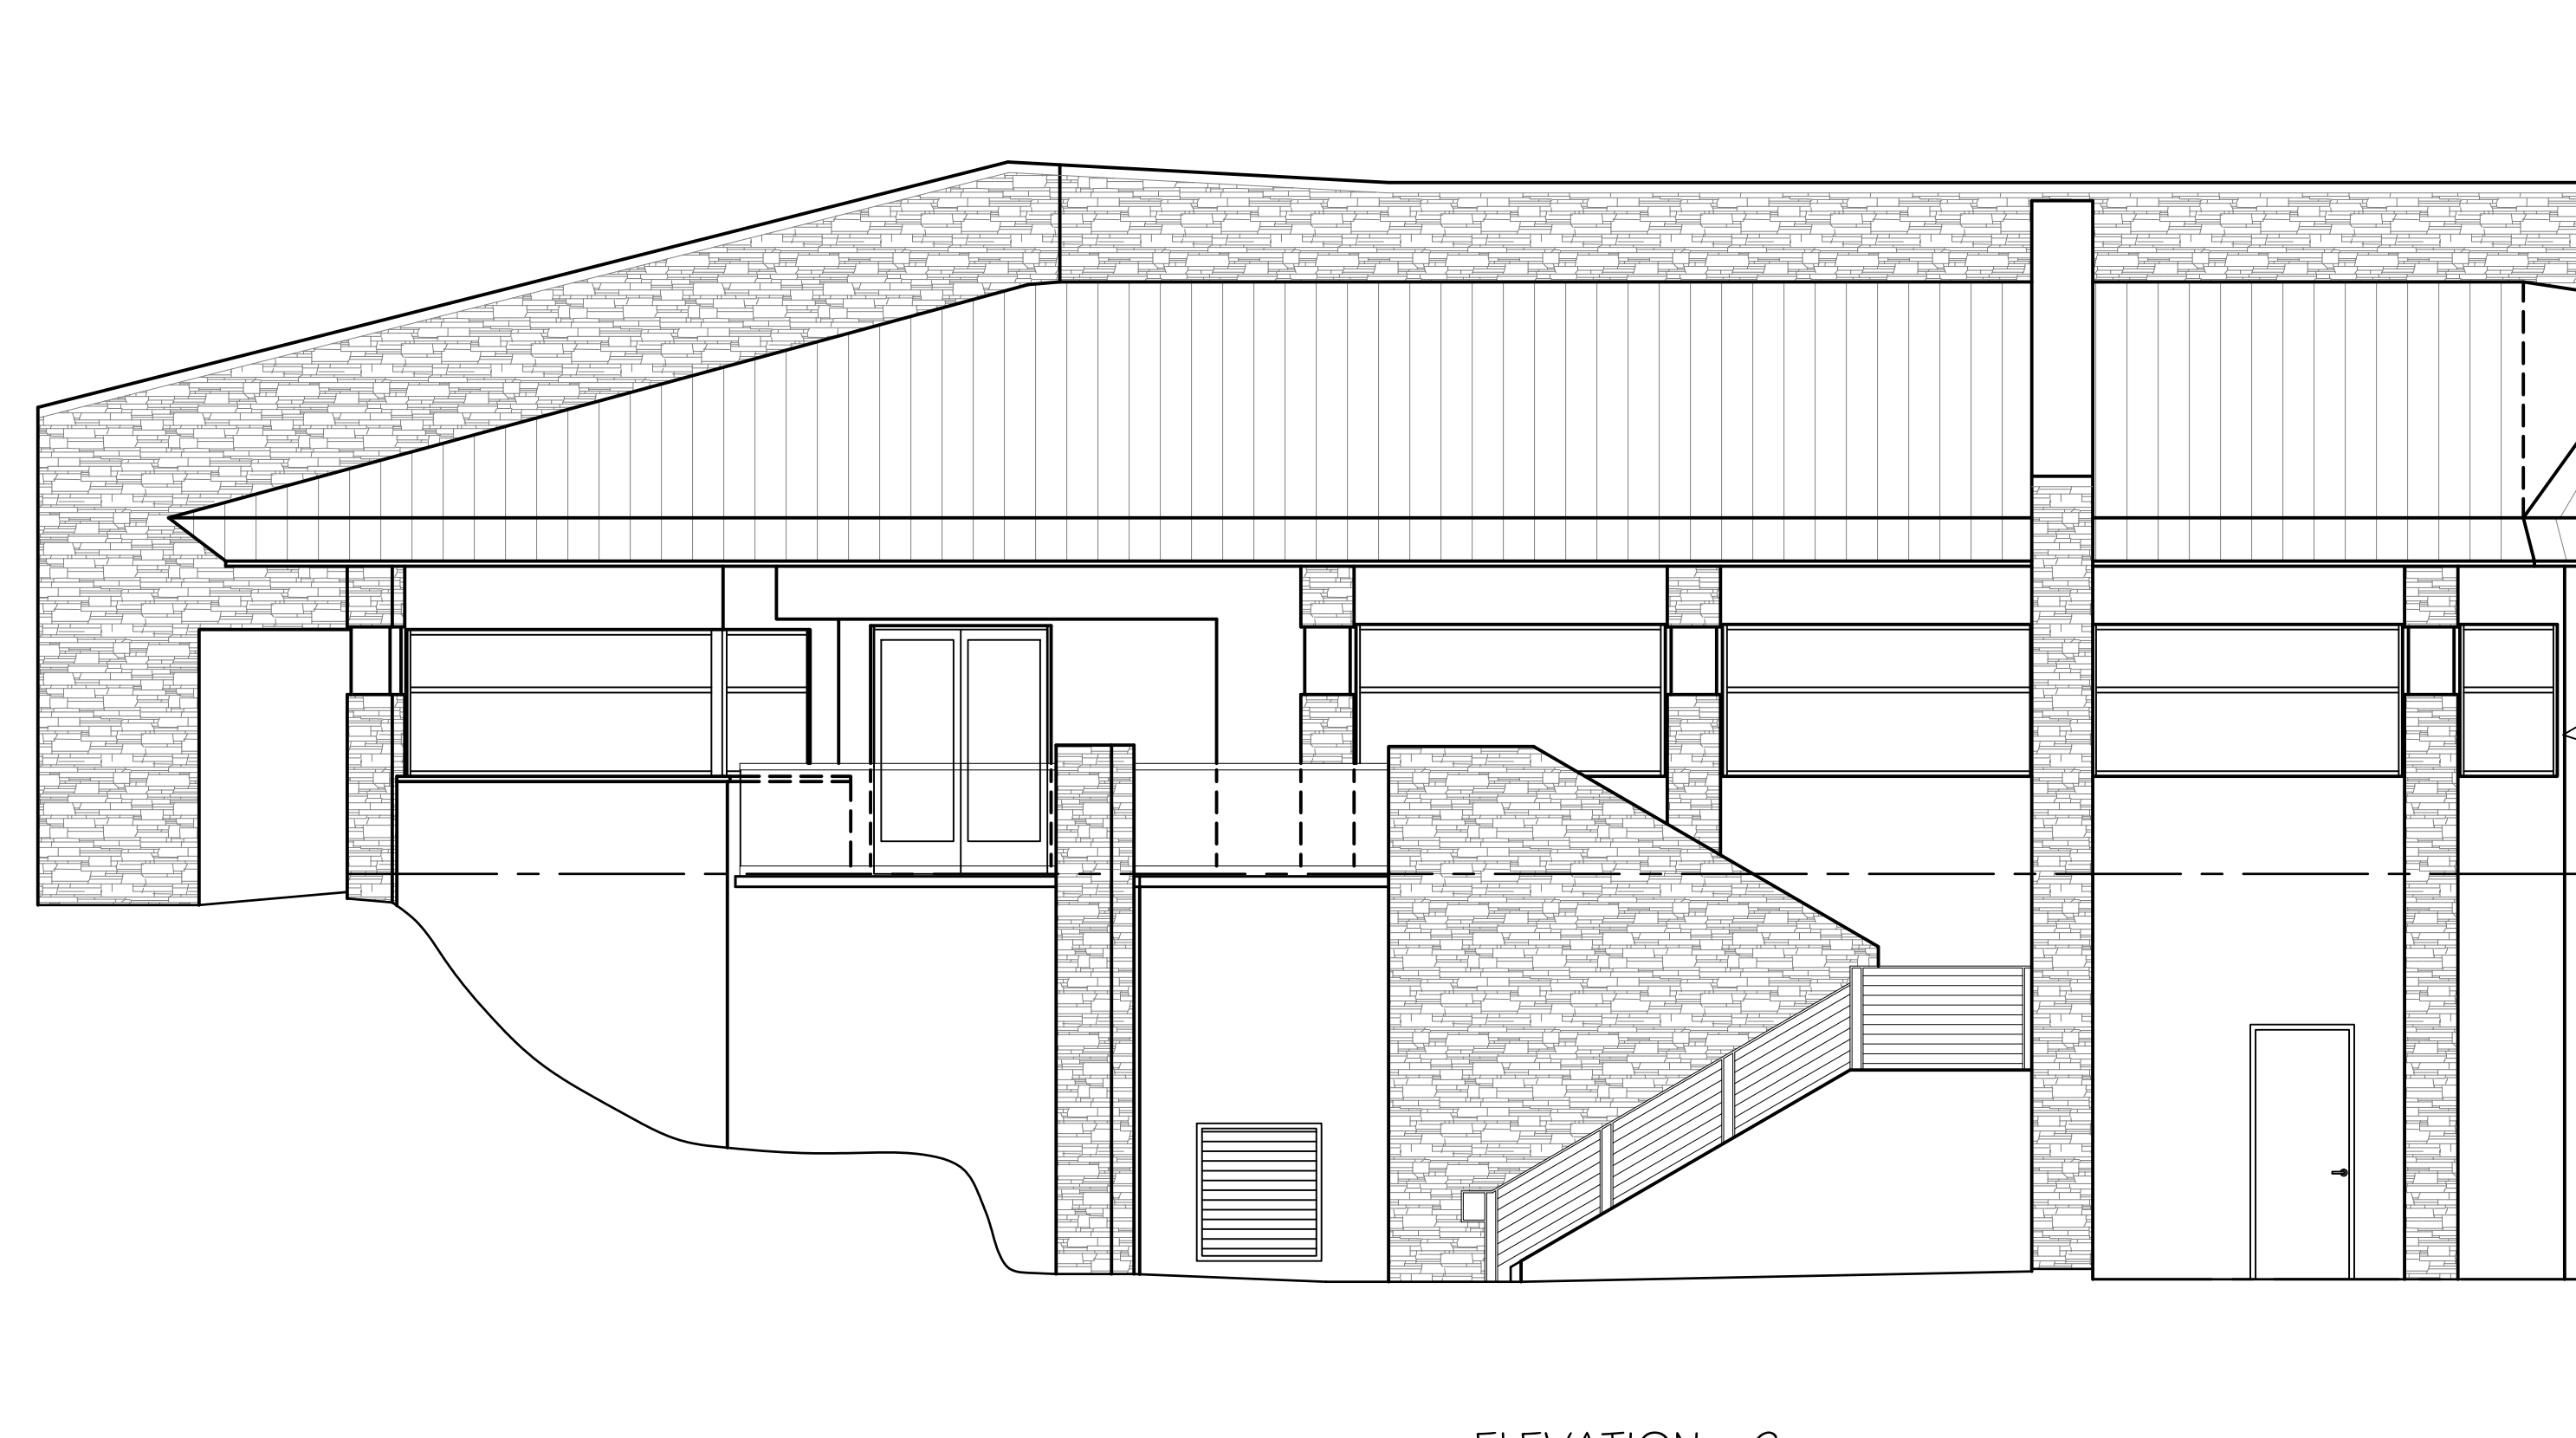


ELEVATION - G

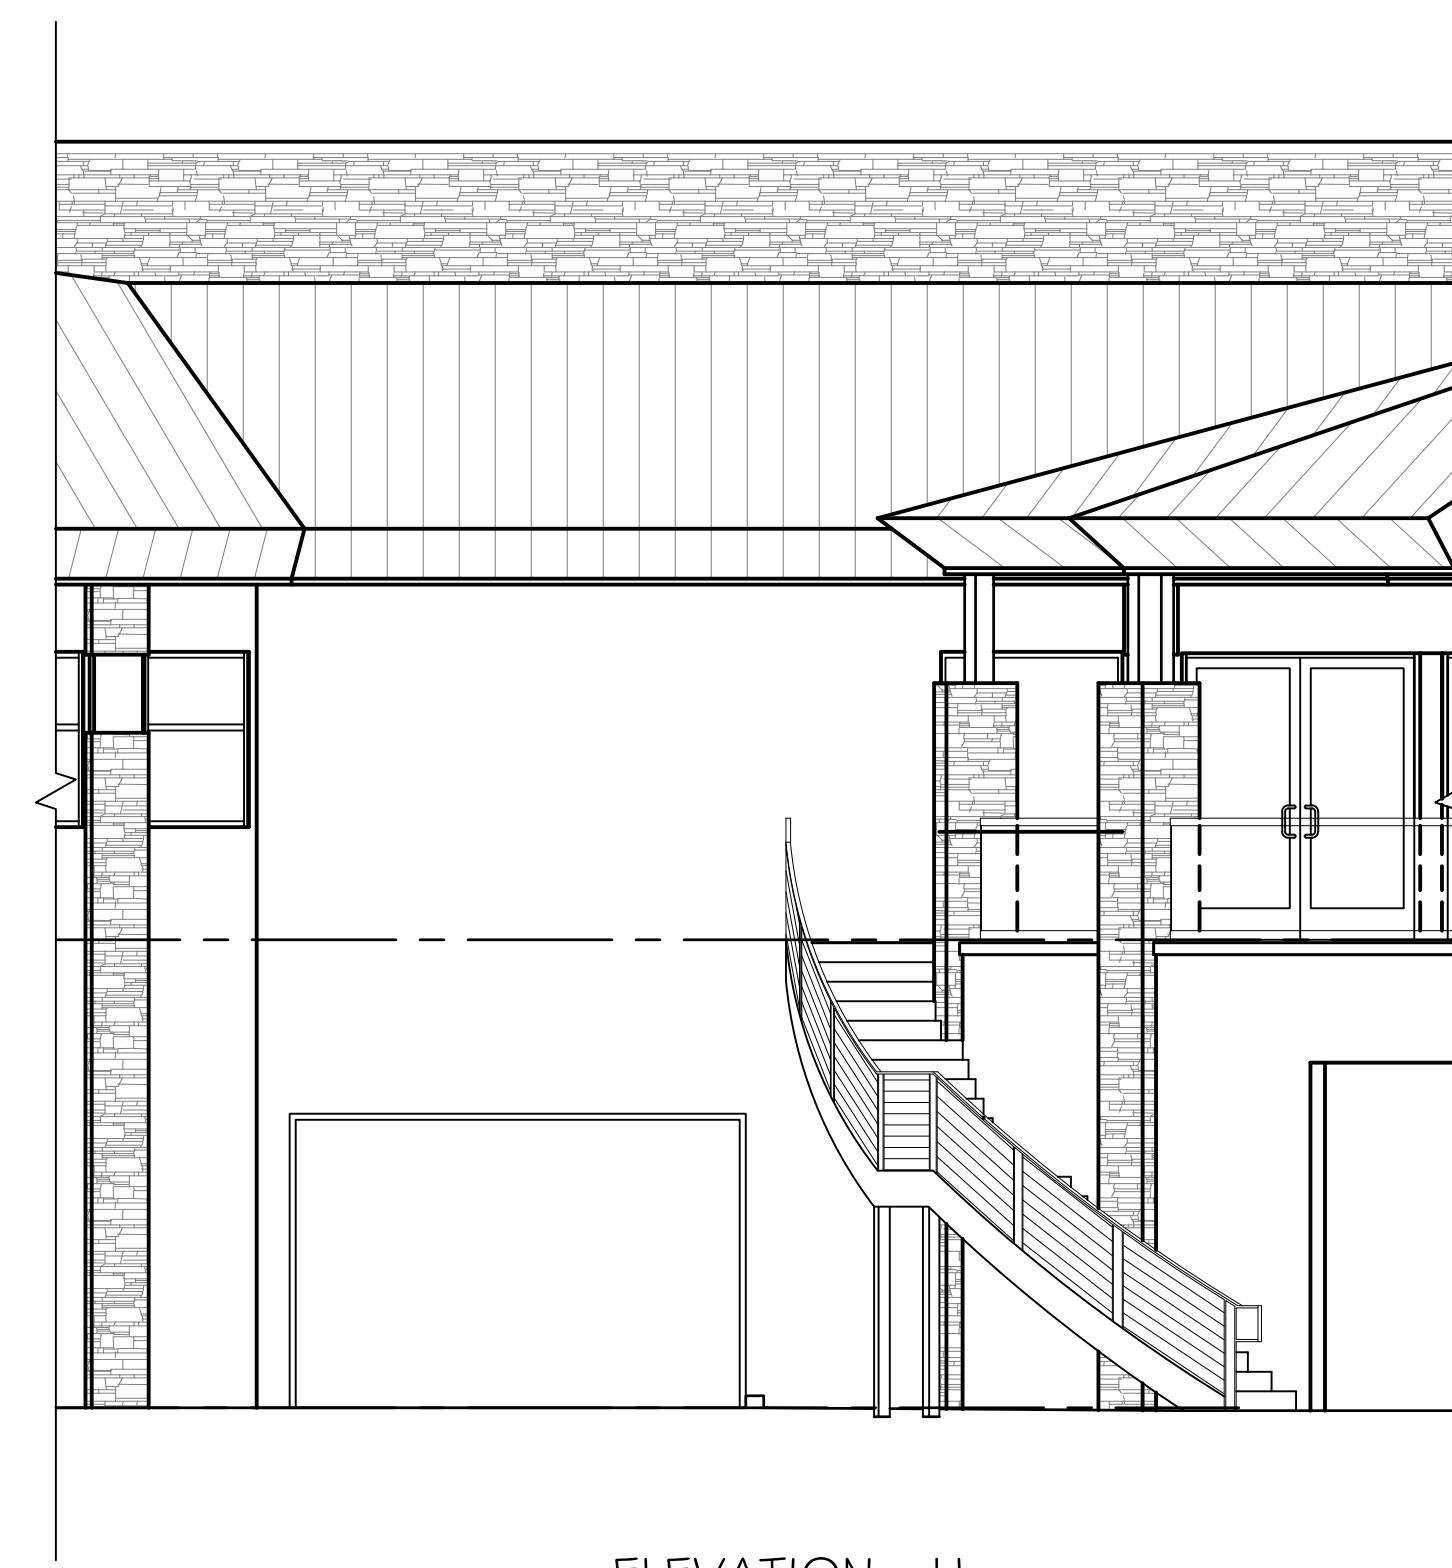


ELEVATION - H

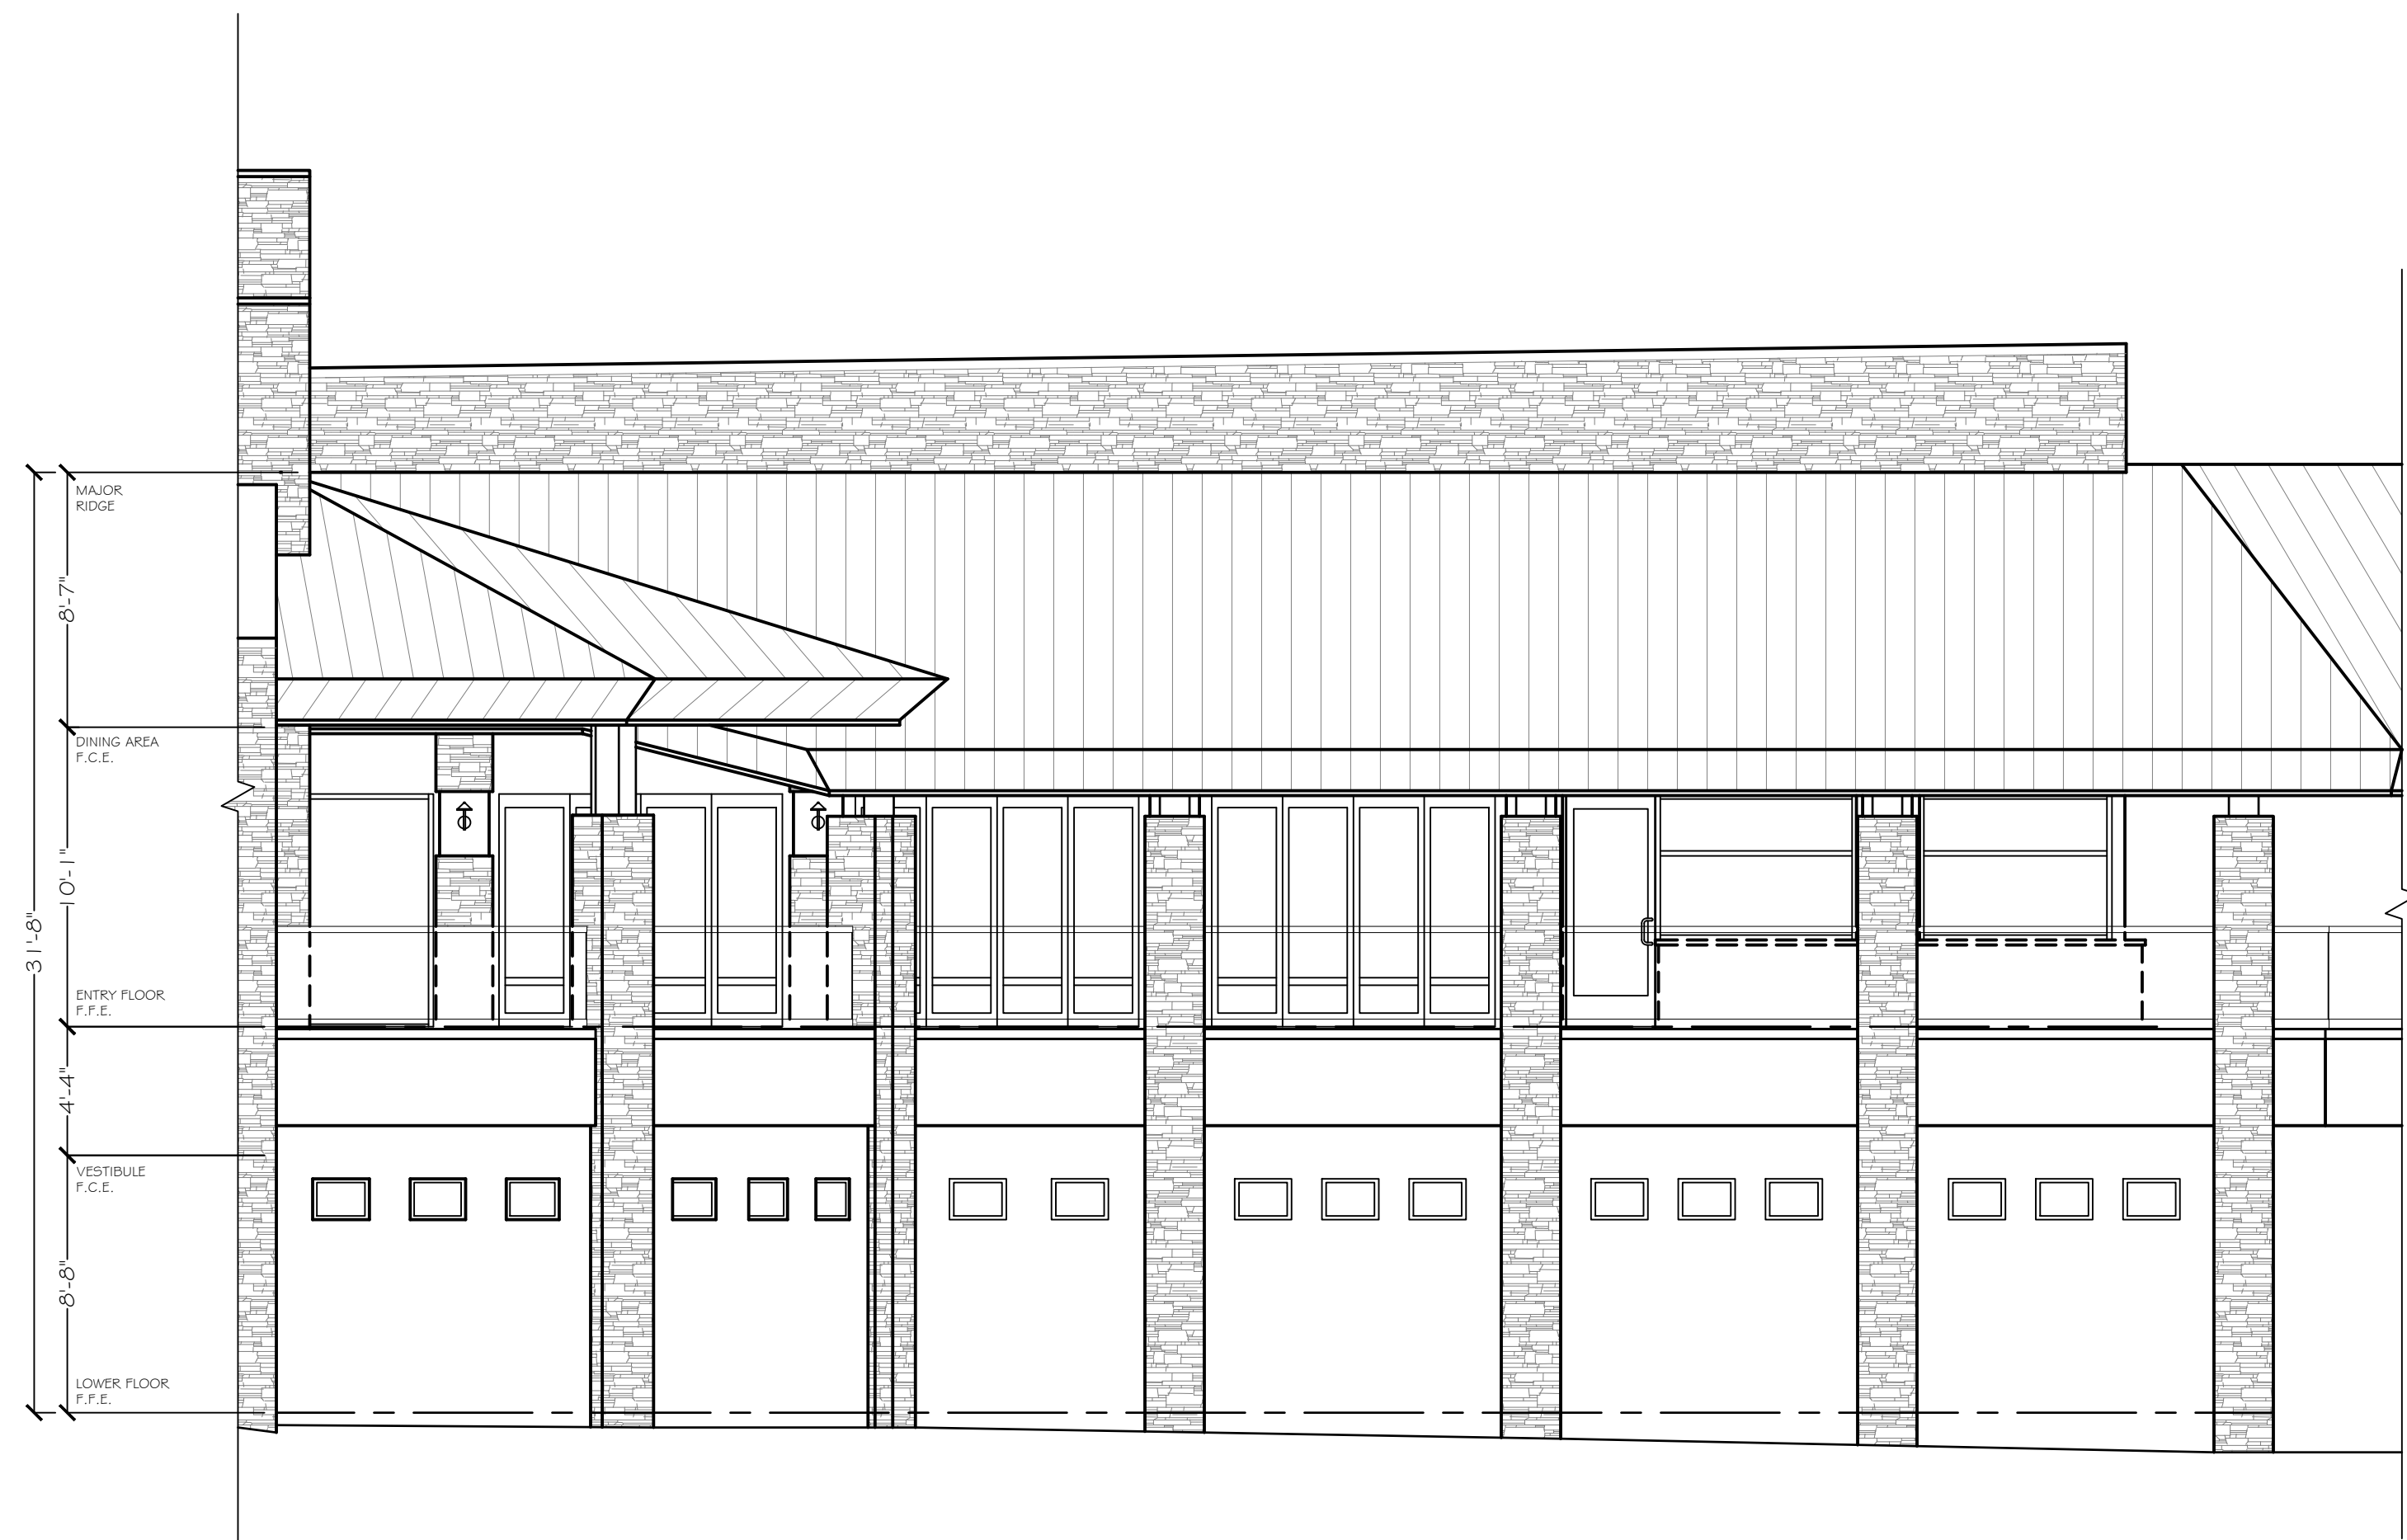

ELEVATION - I

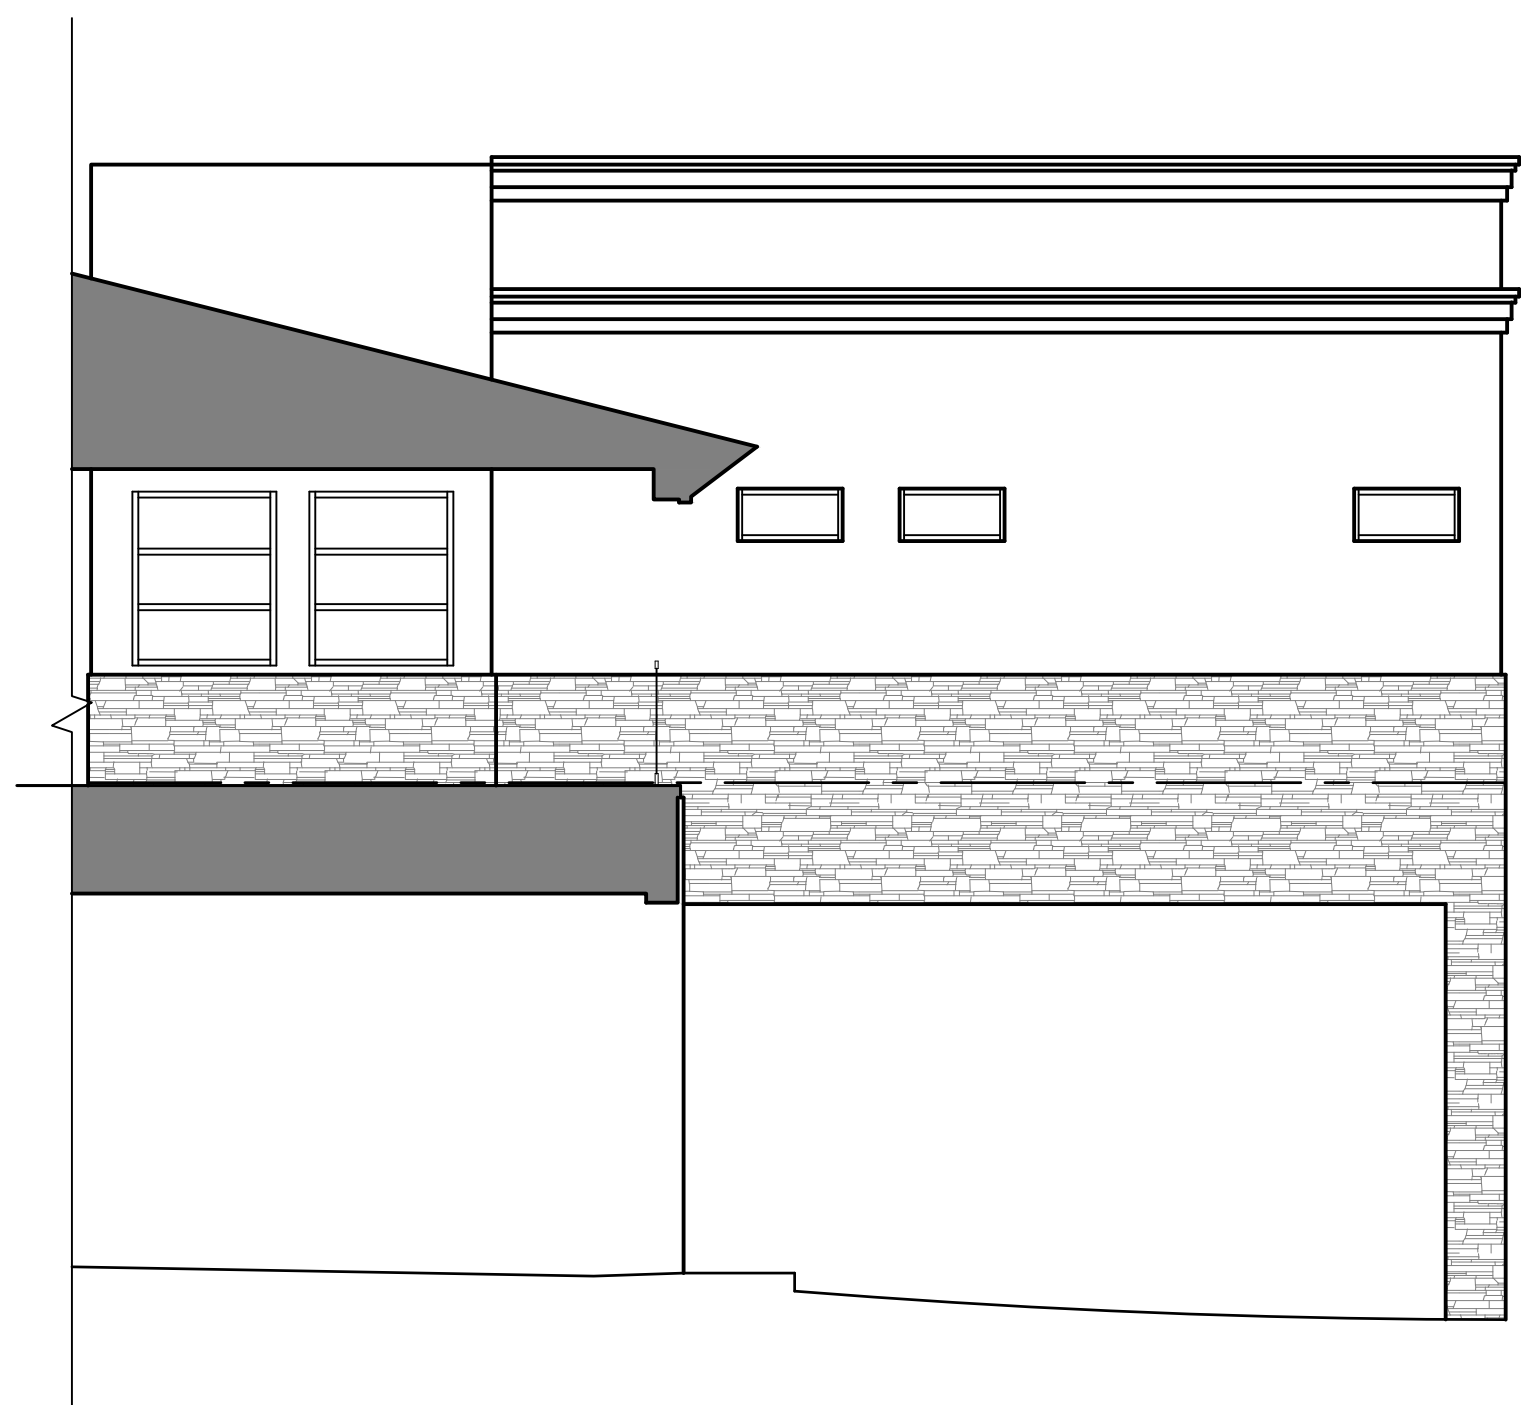

ELEVATION - J

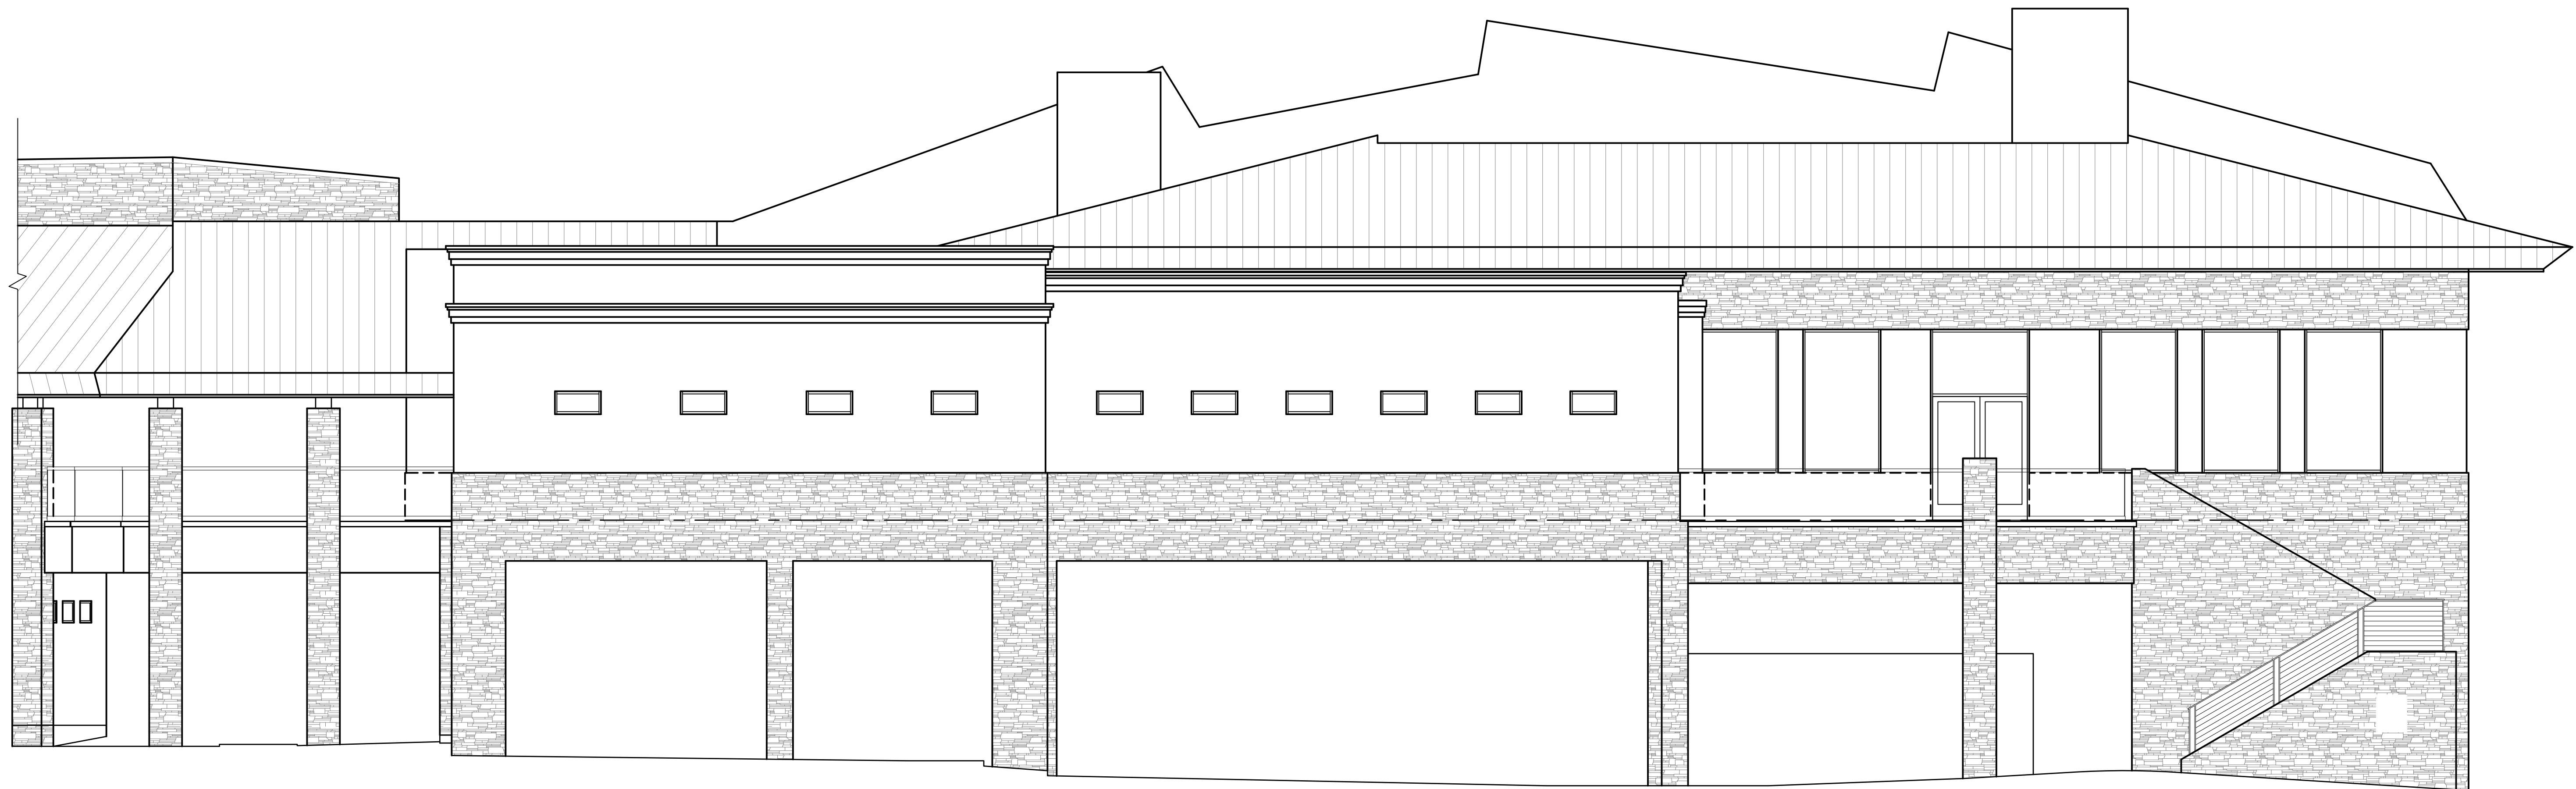

ELEVATION - K

LEGEND

FINISHED GRADE LINE

FINISHED FLOOR LINE

1/2
X

ROOF PITCH LABEL (RISE/RUN)



PRECISION PROPERTY MEASUREMENTS

3626 E. PACIFIC COAST
HIGHWAY | 2ND FLOOR
LONG BEACH CA | 90804
T 562.621.9100
F 888.698.2966
WWW.PPMCO.NET



PREPARED FOR

CLIENT NAME

PROJECT TYPE

EXTERIOR ELEVATIONS

PROJECT NAME

COUNTRY CLUB

PROJECT ADDRESS

STREET
CITY, ST 00000

All plans created by Precision Property Measurements, LLC ("PPM") are made exclusively for landscaping purposes (CA, Title 4 Prof. Code 86727). All data plans created by PPM do not include the determination of any property line, and as such do not constitute land acquisition. (CA, Title 4 Prof. Code 86728.2(b)(2)). In addition, PPM services and plans do not constitute an engineering (CA, Title 4 Prof. Code 86702.47(b)), and this should not be used for any activity or activities defined as civil engineering (CA, Title 4 Prof. Code 86731). All floor plans created by PPM are intended to be used as a reference for general construction and should not be considered a substitute for the services of a licensed structural engineer or licensed architect. PPM makes every reasonable effort to ensure the accuracy of its calculations based on data. However, some inaccuracies may occur due to the nature of the data. It is the duty of the architect, contractor, designer or other licensed professional, and a consultant to the property owner, to determine the suitability of the As-Built plans prior to construction. Measurements should be field confirmed before commencing construction, in the event that an error is found on a plan, PPM's liability is limited to the amount of the fee paid to PPM.


SCALE
3/16" = 1'-0"

PROJECT
0000_ZZ


APPROVED BY
XX

DATE
00/00/2023

SHEET
15 of 15

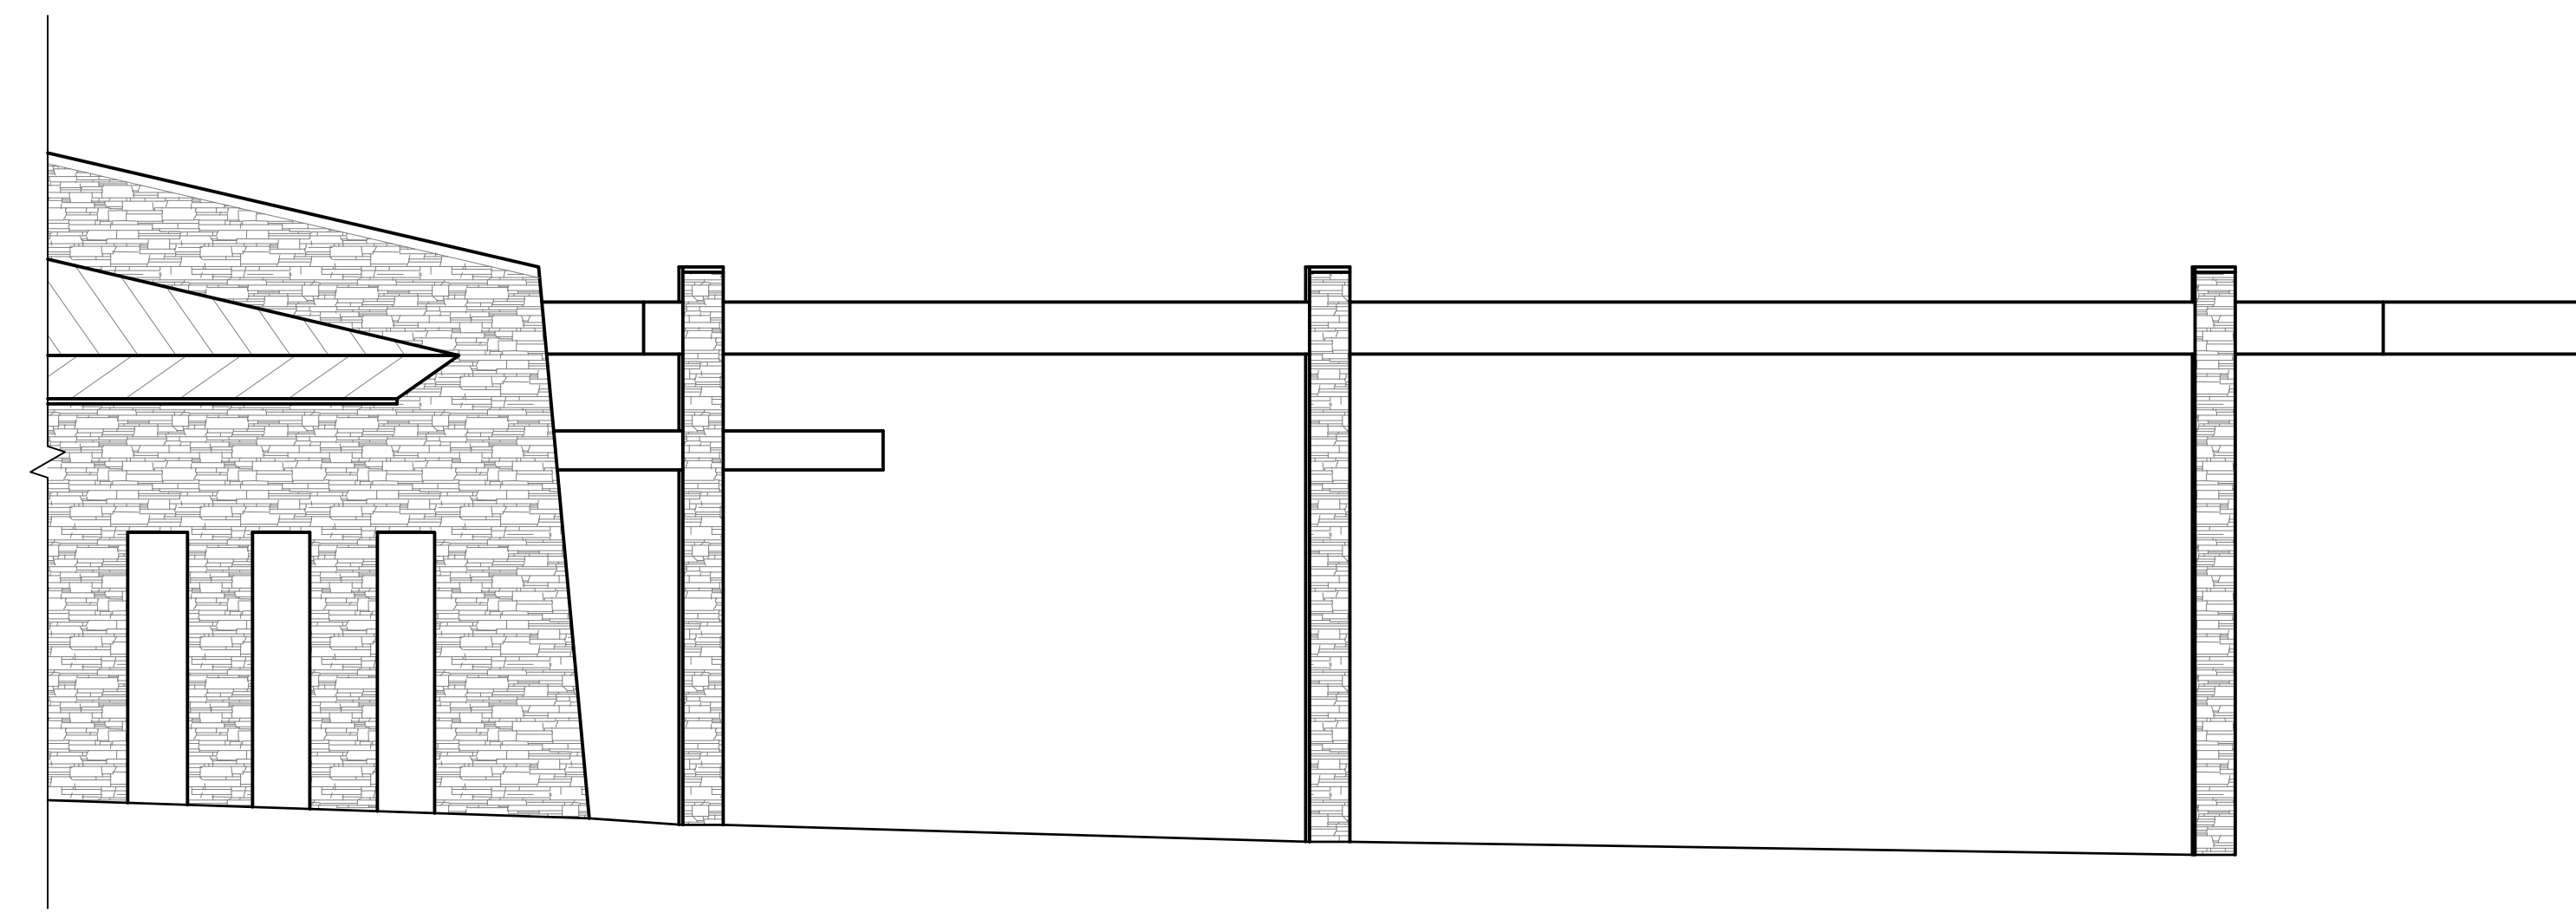

ELEVATION - L

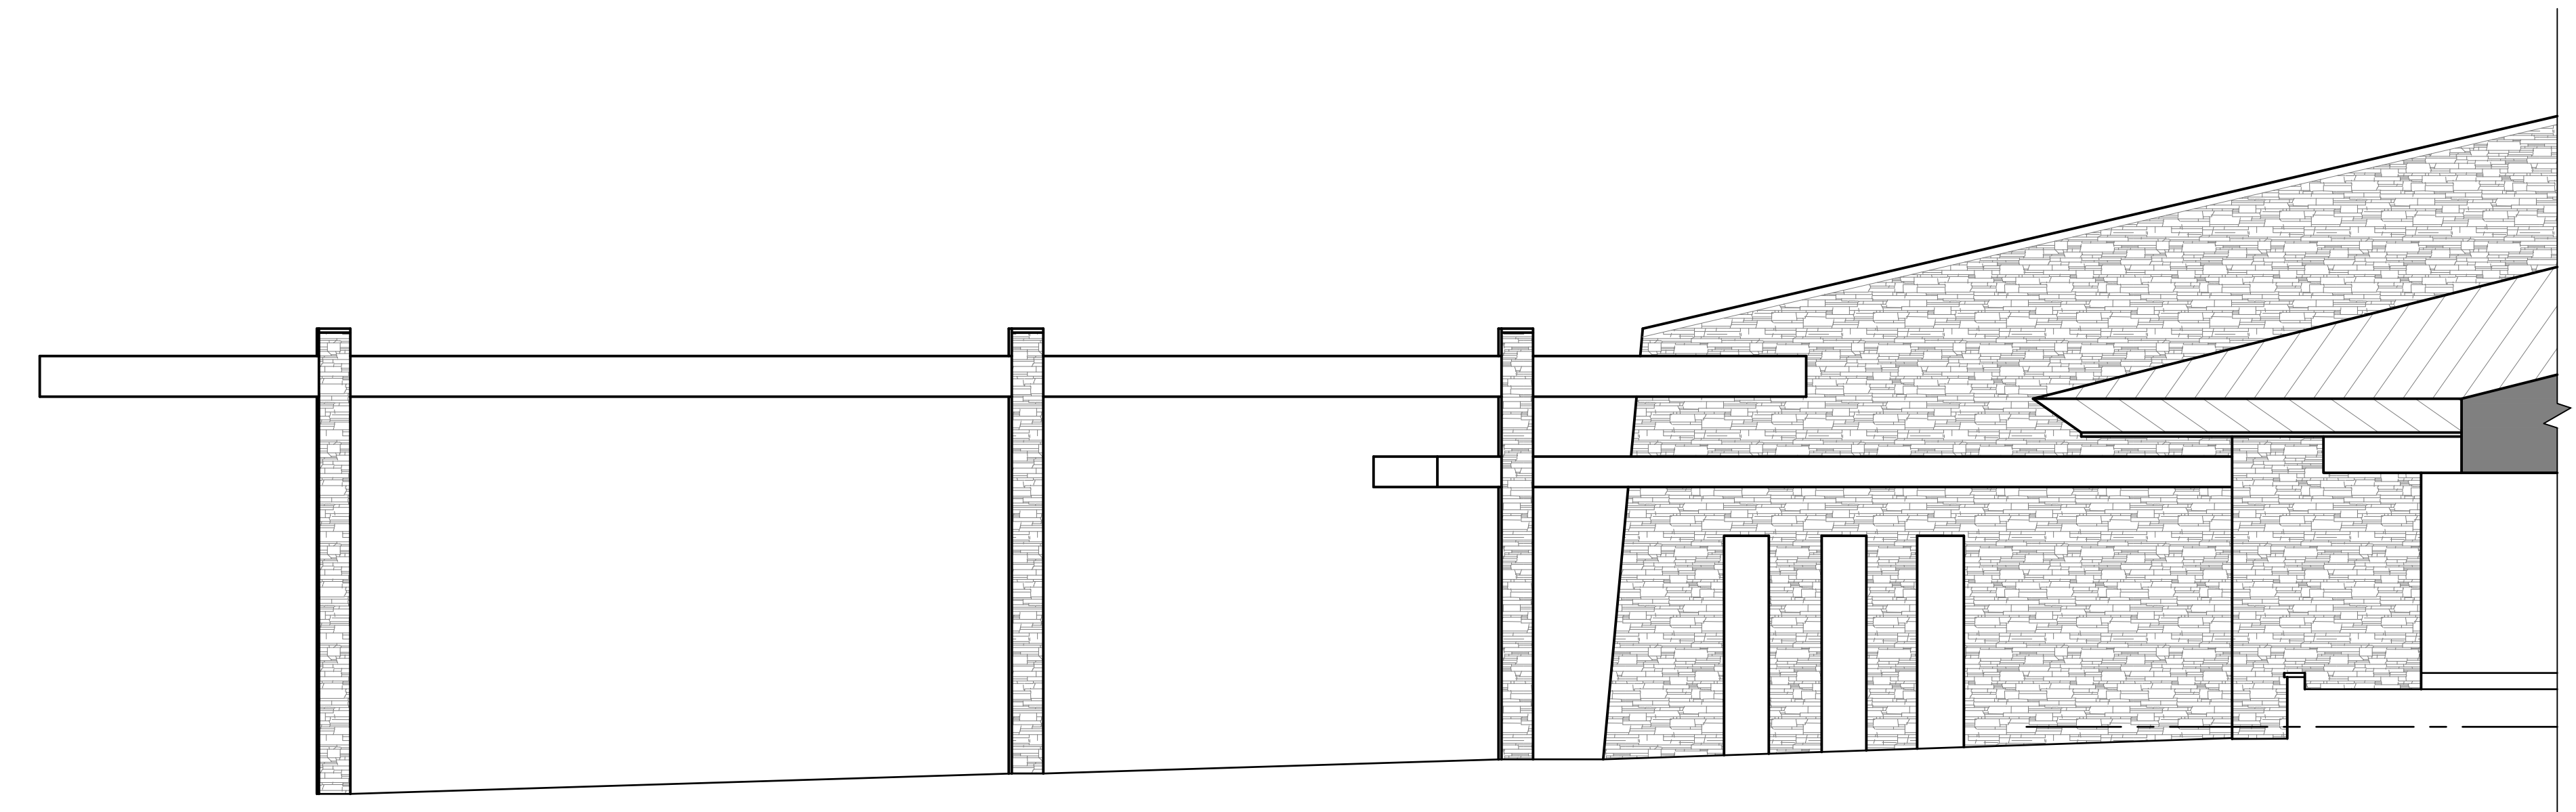

ELEVATION - M