

PREPARED FOR

CLIENT NAME

PROJECT TYPE

INTERIOR ELEVATIONS

PROJECT NAME

COUNTRY CLUB

PROJECT ADDRESS

STREET  
 CITY, ST 00000

All plans created by Precision Property Measurements, LLC ("PPM") are made exclusively for landscaping purposes (i.e., this is a PPM Code 80727). All other plans created by PPM do not include the determination of any property line, and as such, do not constitute legal advice. (See Civil Code § 818.007-00727, in addition, PPM services are given as a courtesy and this would not be used for any activity or activities defined as not engineering (i.e., this is a PPM Code 80727). All floor plans created by PPM are intended to be used as a reference for design and construction and should not be considered a substitute for the services of a licensed structural engineer or licensed architect. PPM makes every reasonable effort to ensure the accuracy of the information based on data provided. However, some jobsite drawings reflect conditions in some degree. It is the duty of the architect, contractor, designer or other licensed professional, as a consultant to the property owner, to determine the suitability of the As-Built plans prior to construction. Measurements should be field confirmed before commencing construction. In the event that an error is found on a plan, PPM's liability is limited to the amount of the fee paid to PPM.



SCALE  
 3/16" = 1'-0"

PROJECT  
 0000\_ZZ


APPROVED BY  
 XX

DATE  
 00/00/2023


SHEET  
 5 of 15

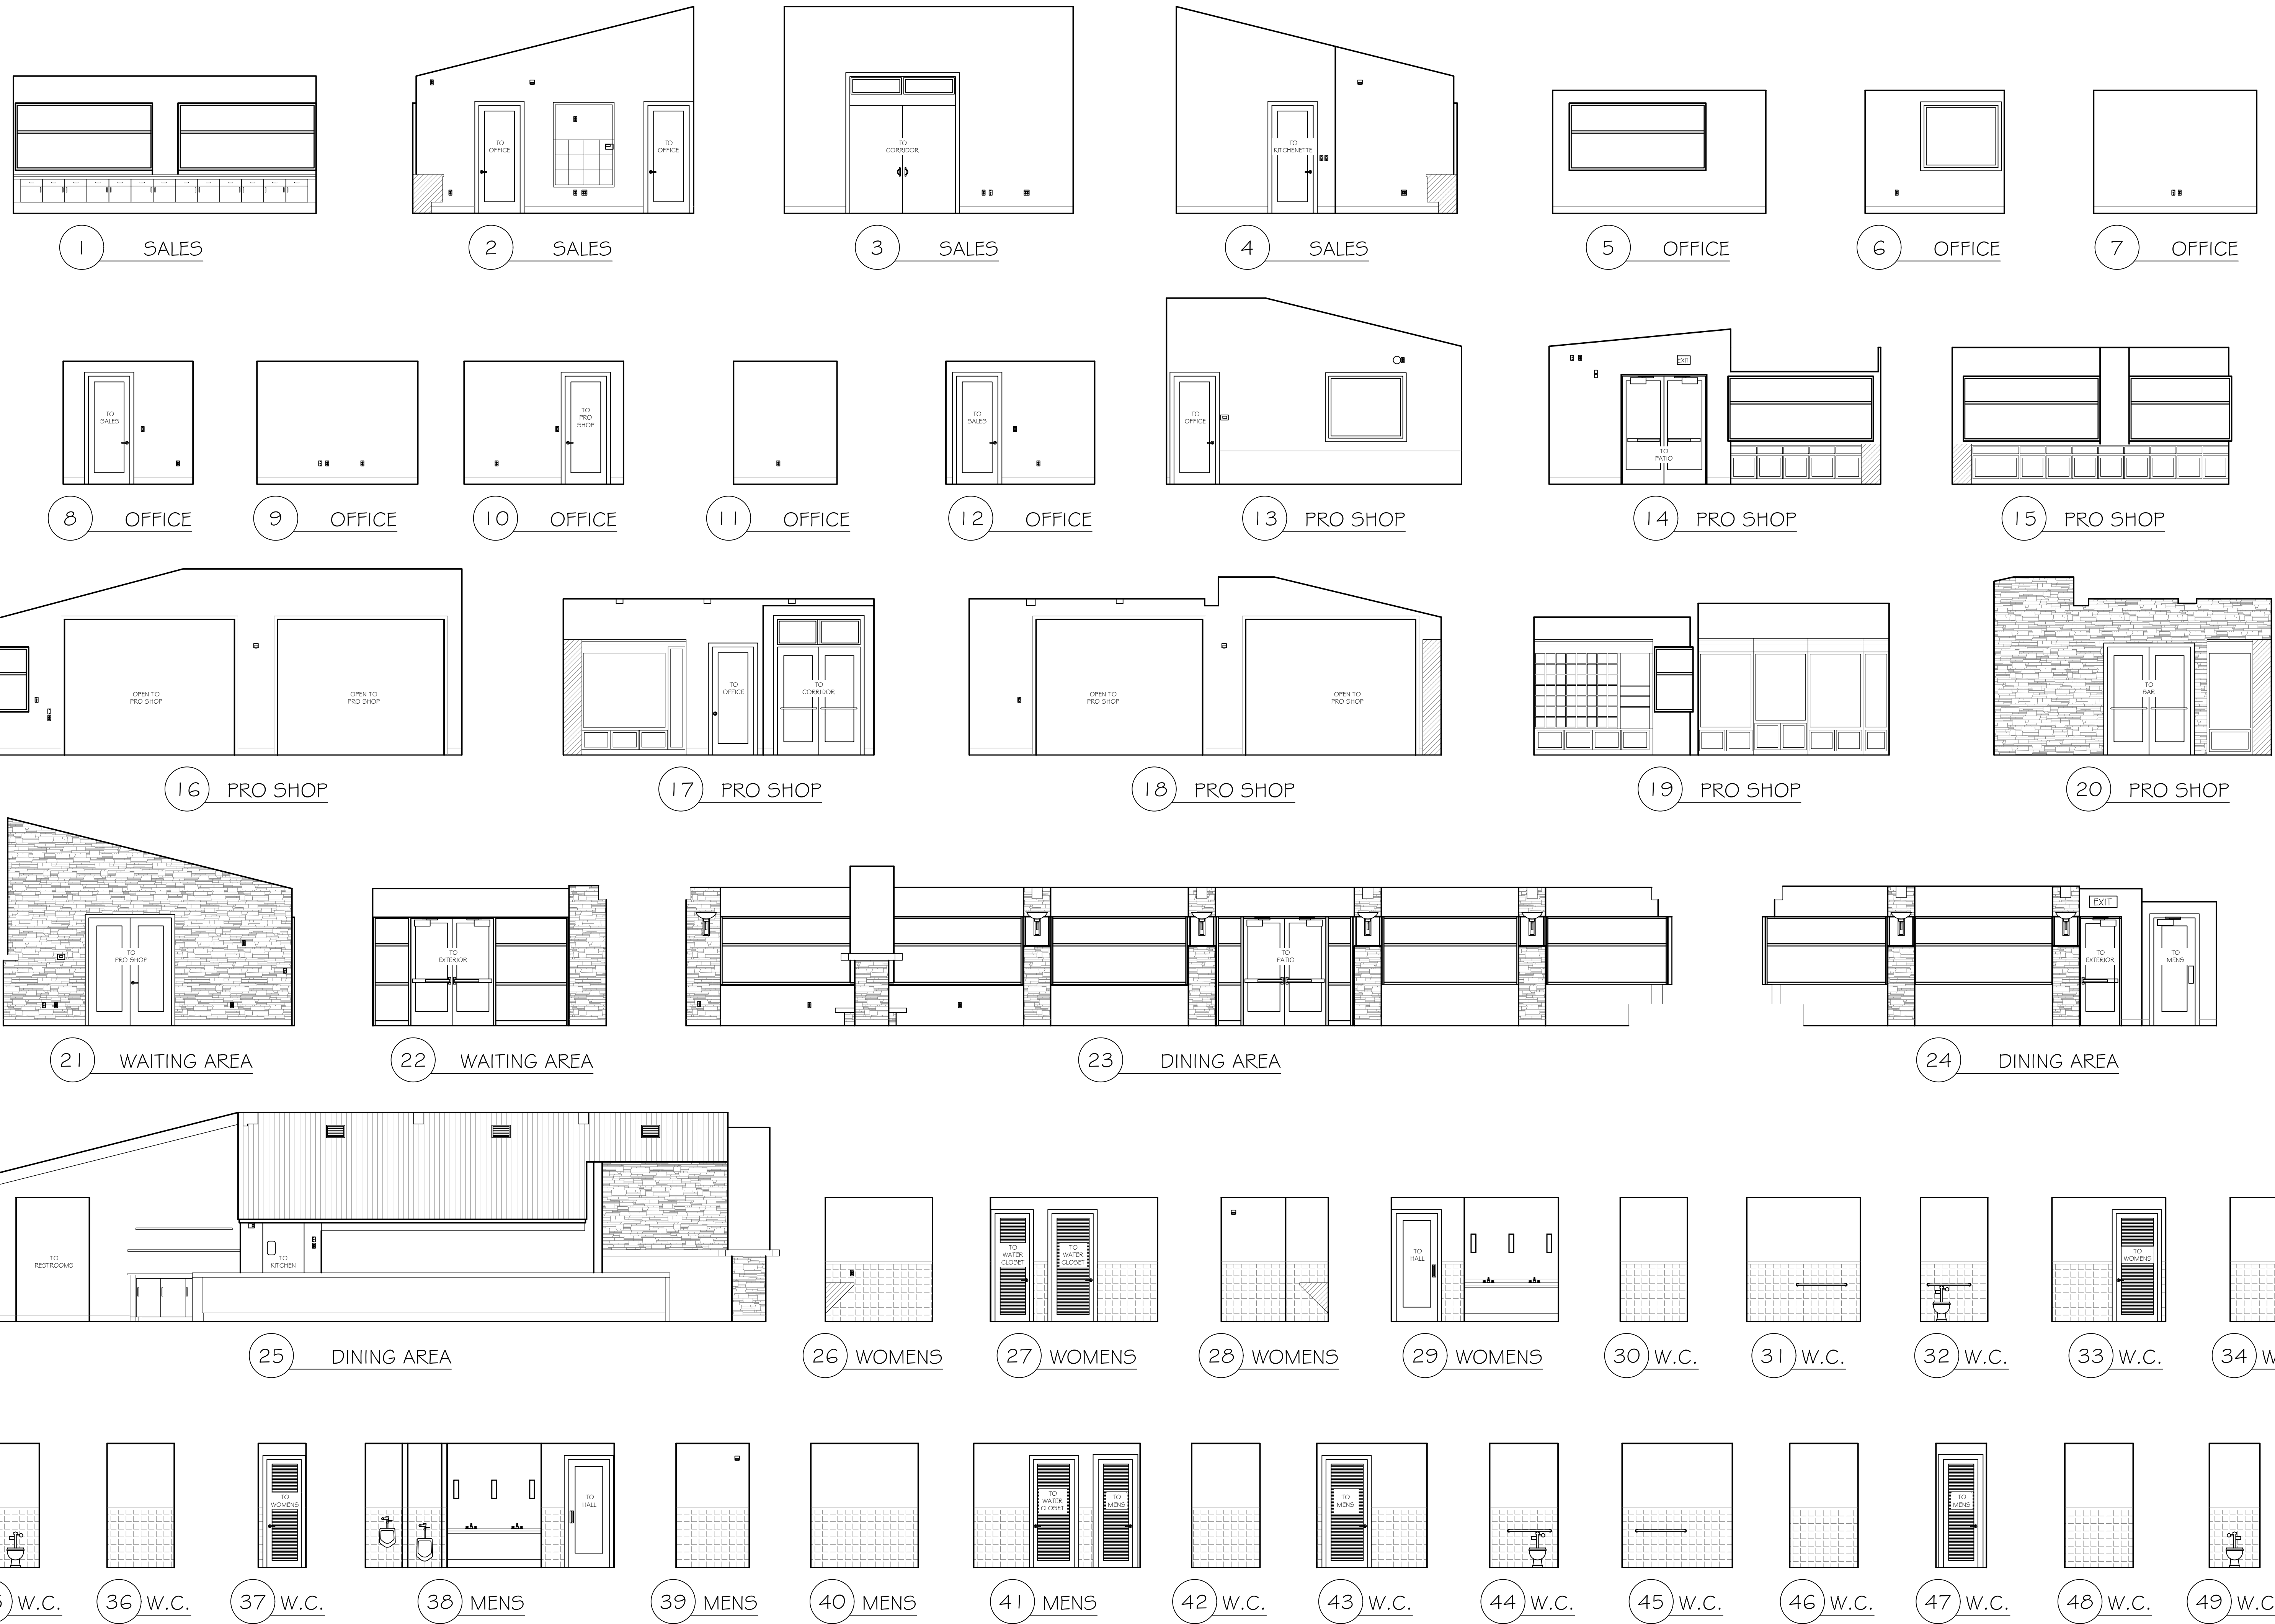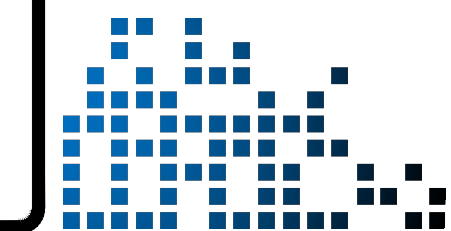




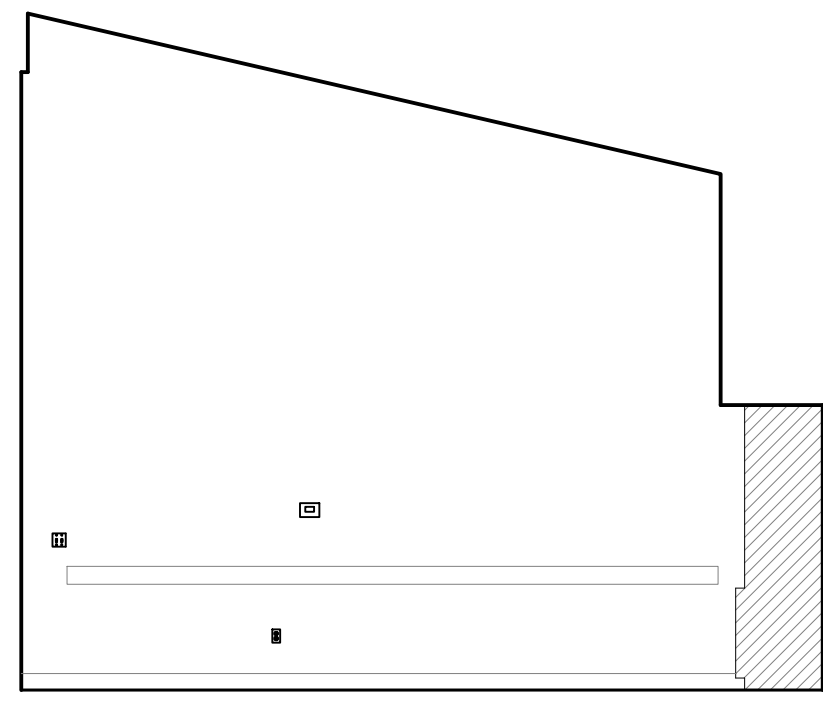


82 CONF. ROOM

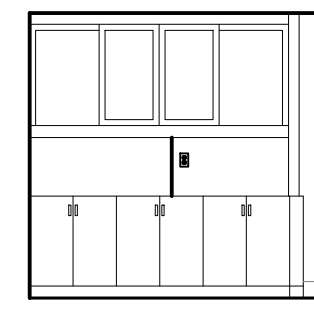


83 CONF. ROOM

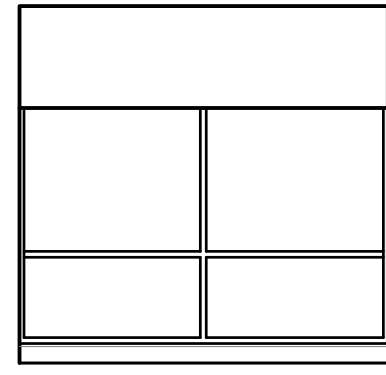


84 CONF. ROOM

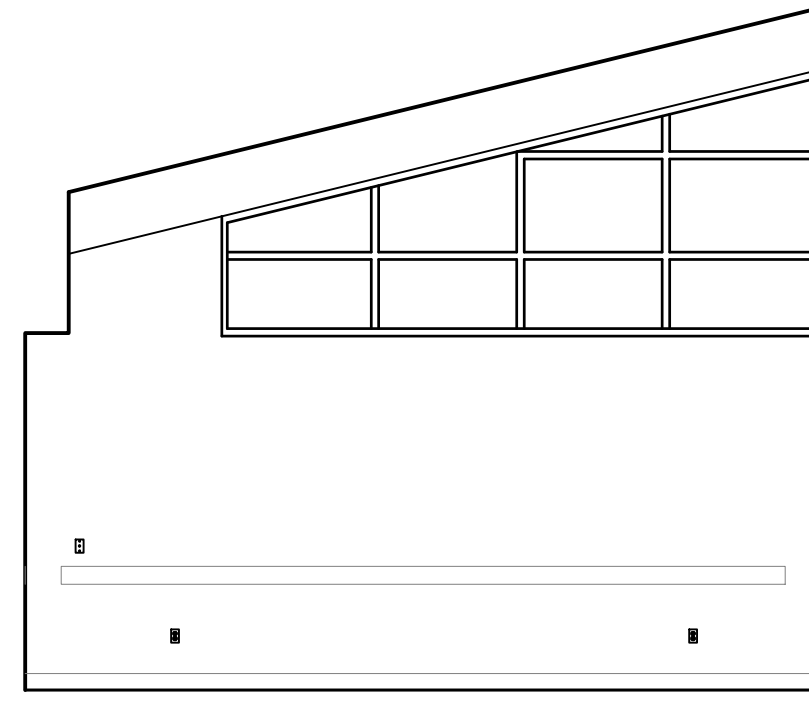


85 CONF. ROOM

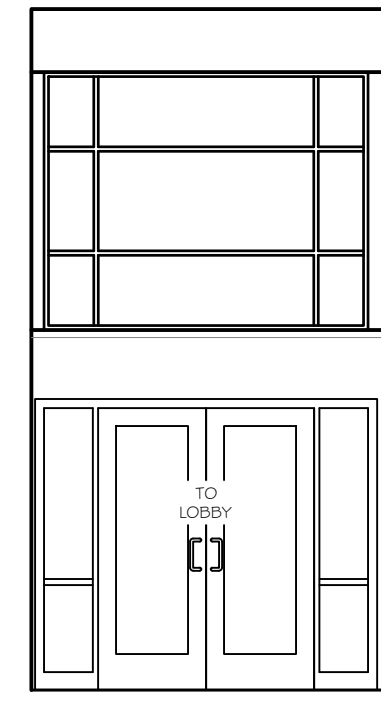


86 CONF. ROOM

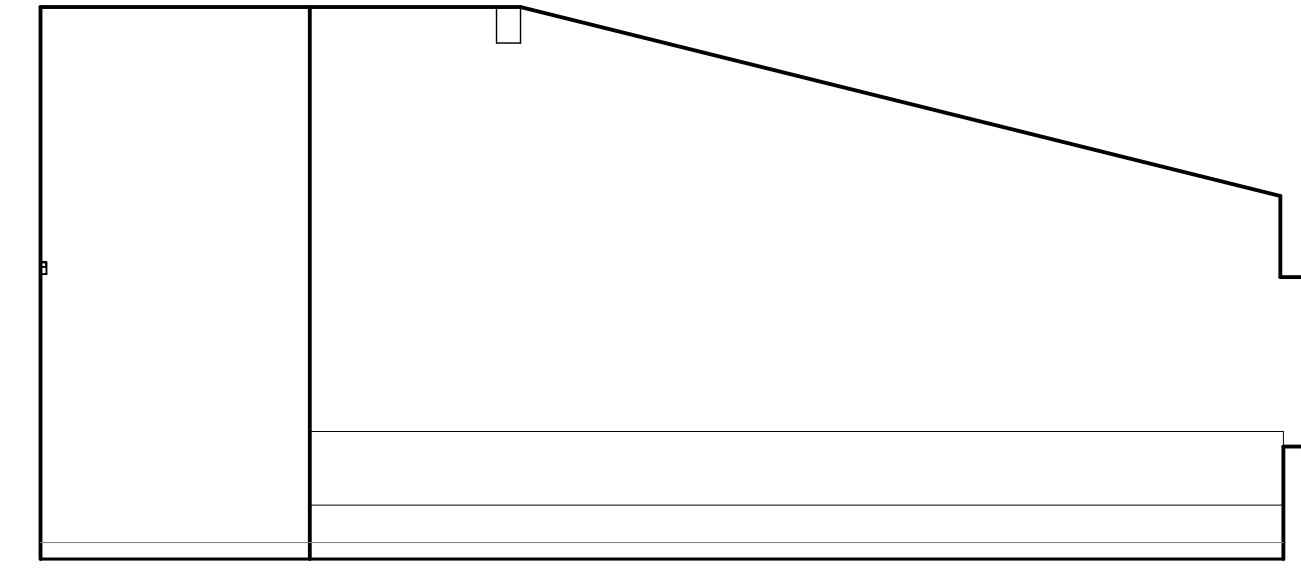


87 DINING

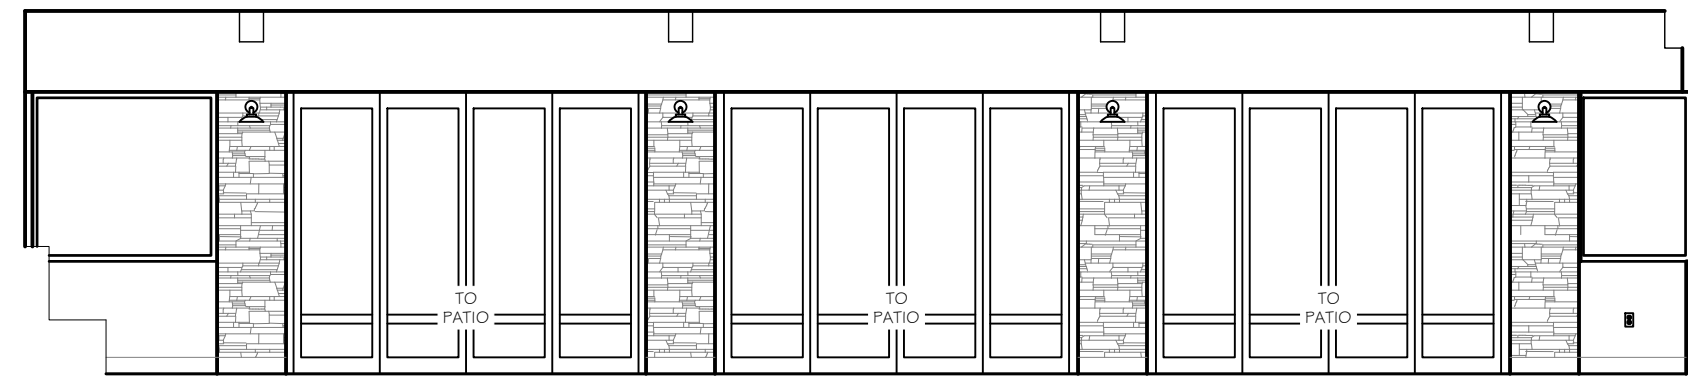


88 DINING

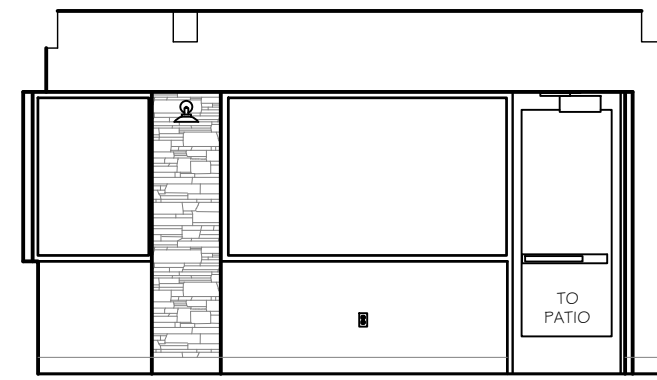


89 DINING

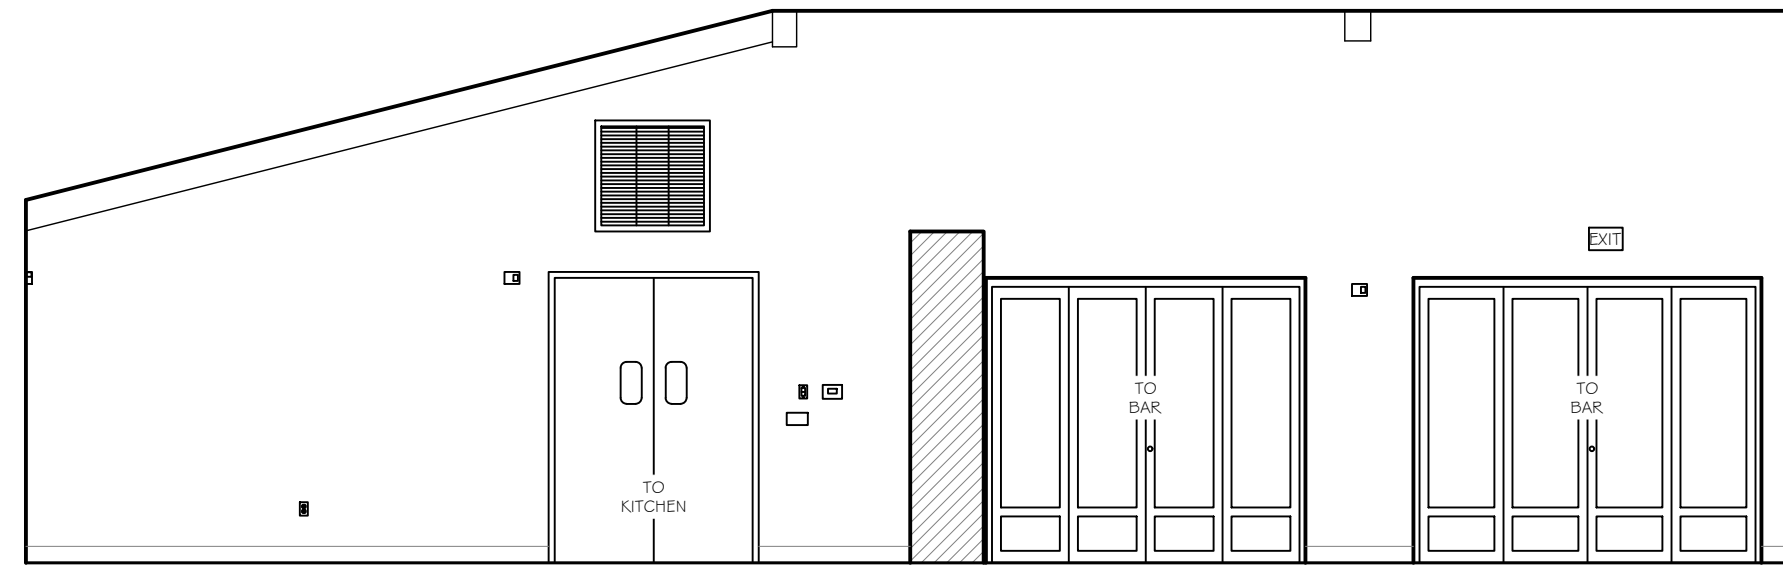


90 DINING

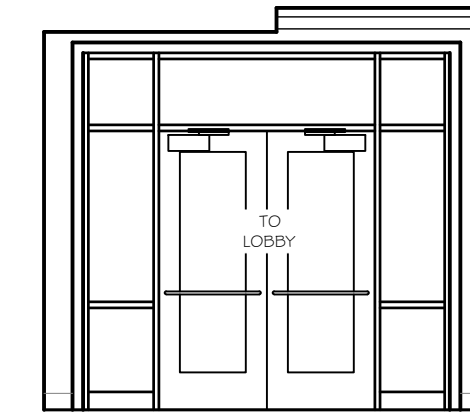


91 BAR

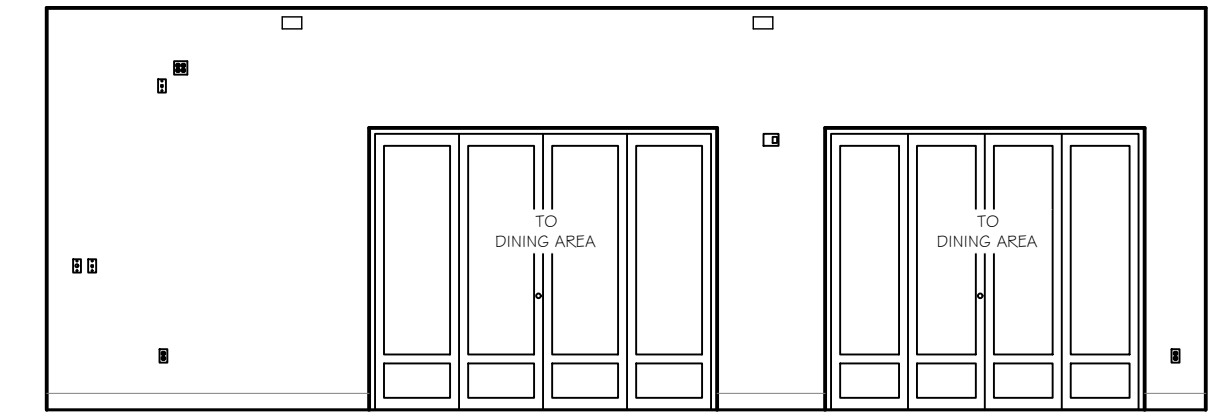


92 BAR

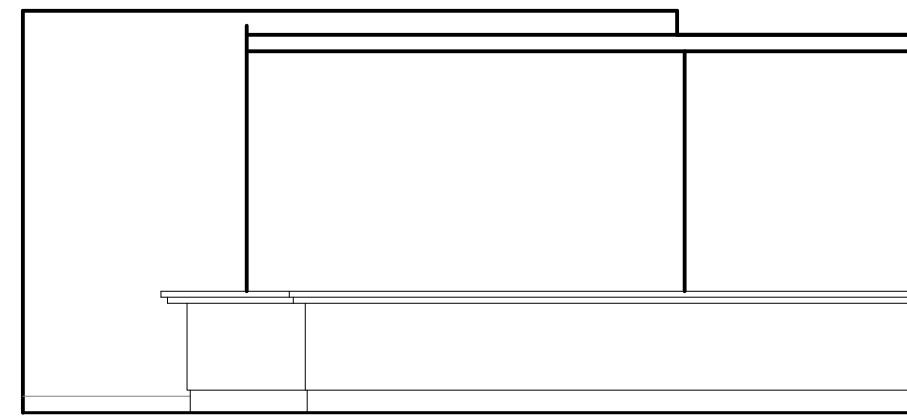


93 BAR

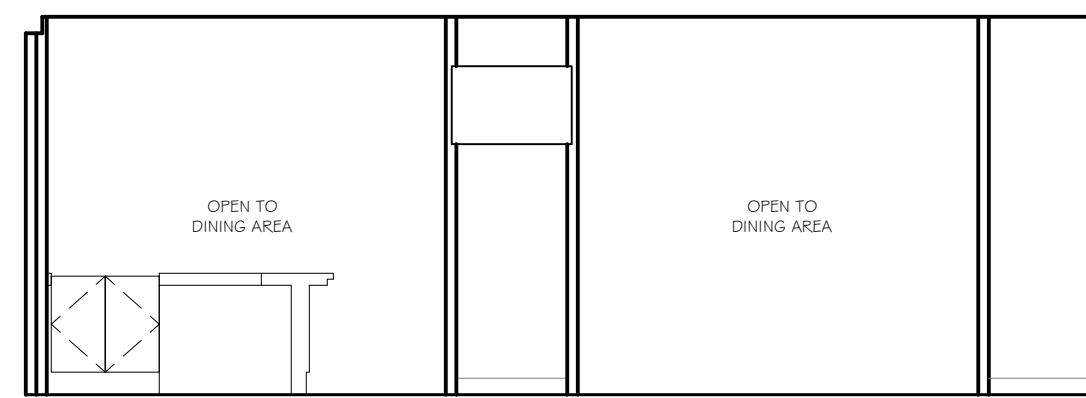


94 BAR

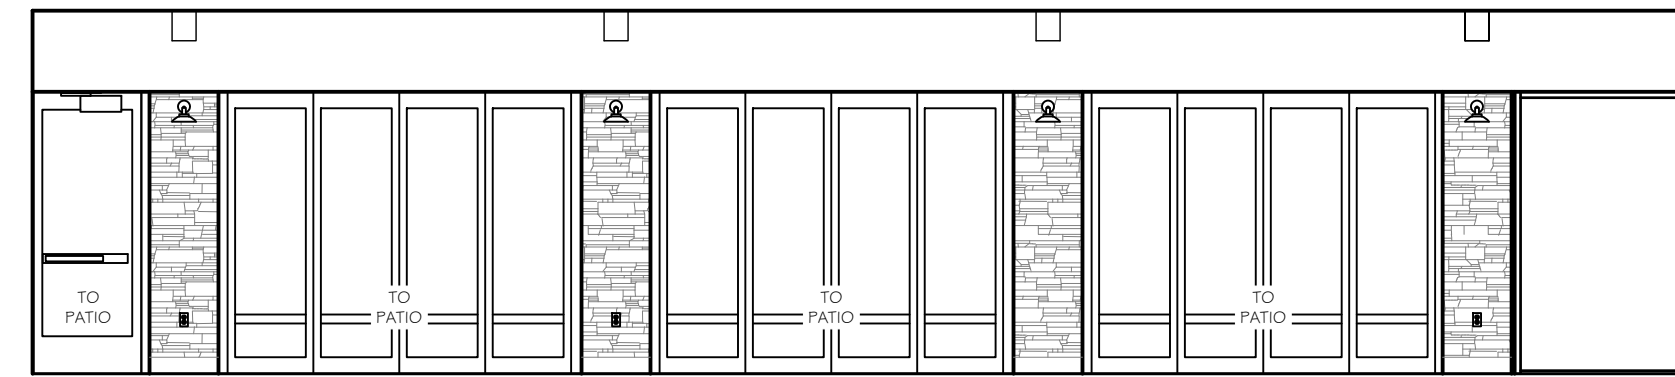


95 DINING

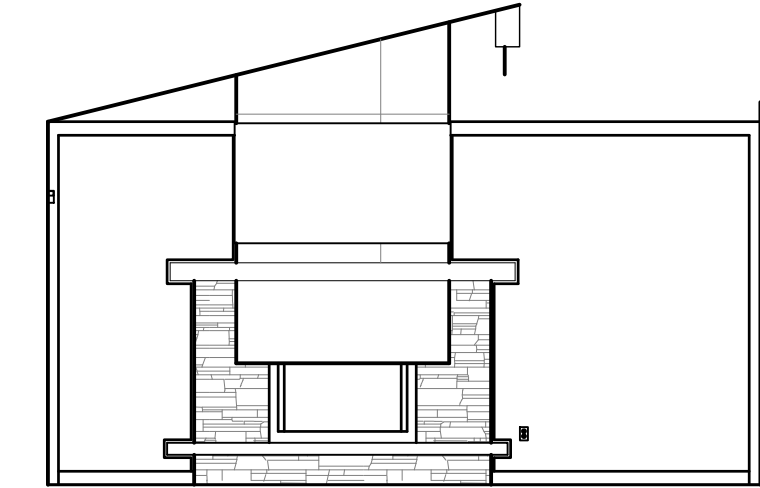


96 DINING

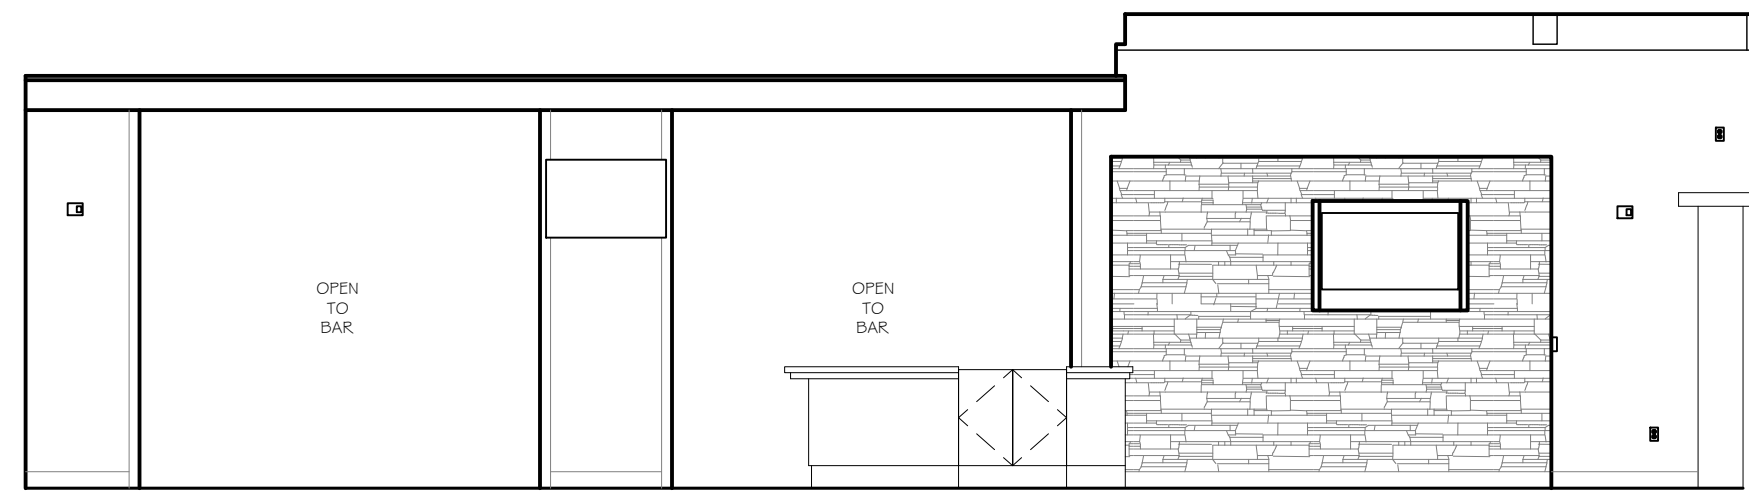


97 DINING

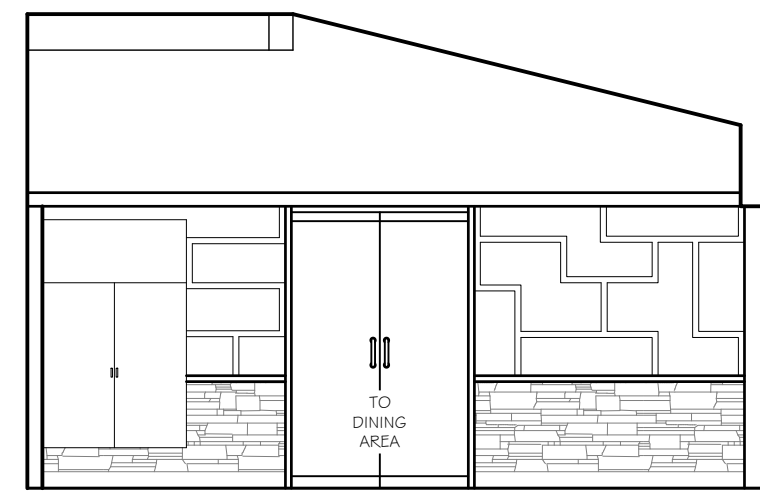


98 DINING

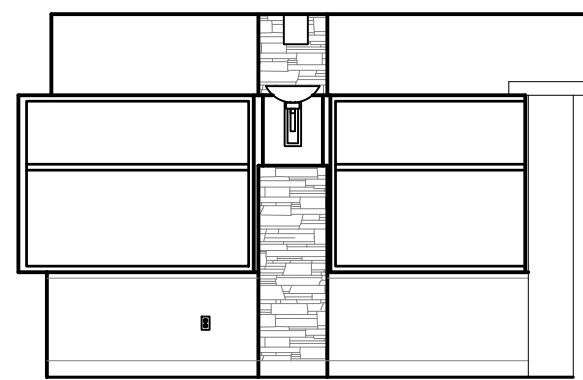


99 DINING

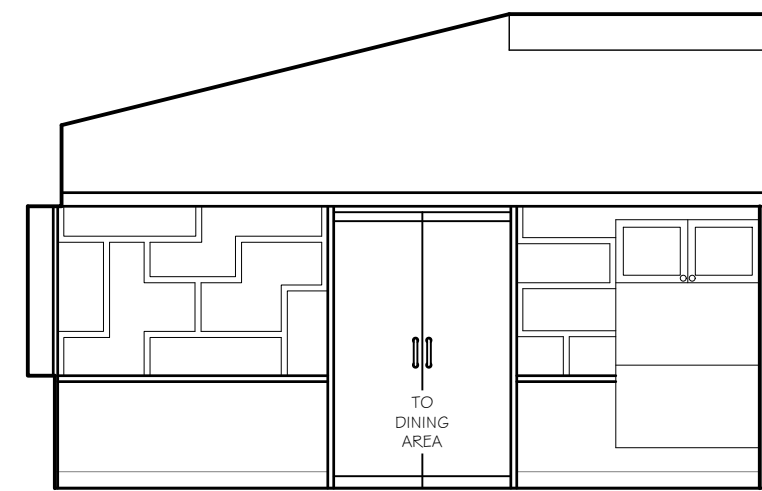


100 DINING

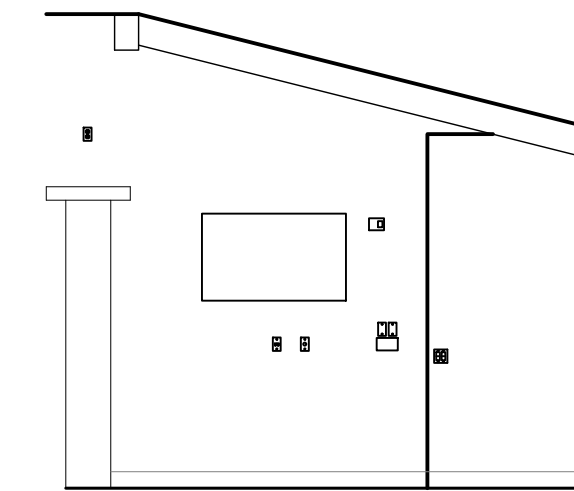


101 DINING

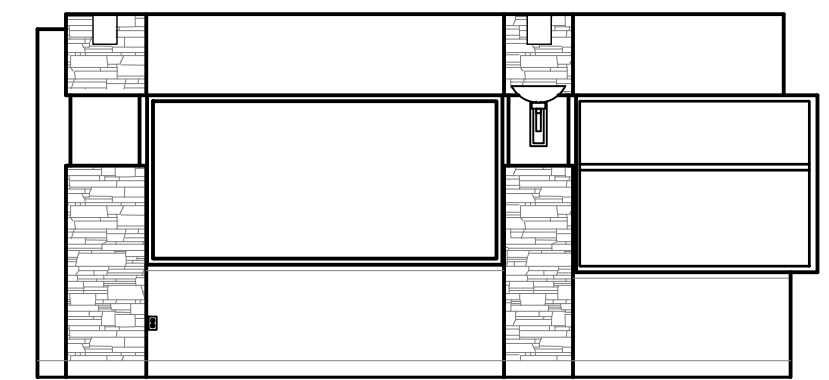


102 DINING

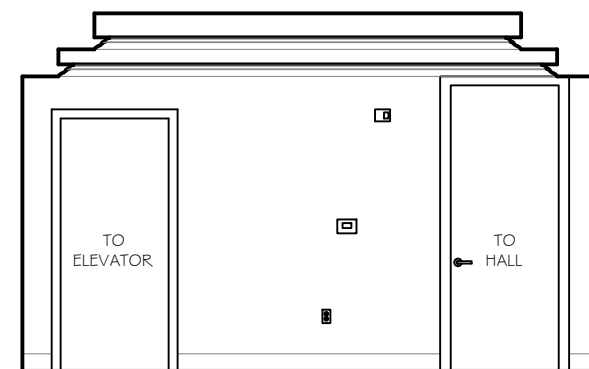


103 HALL

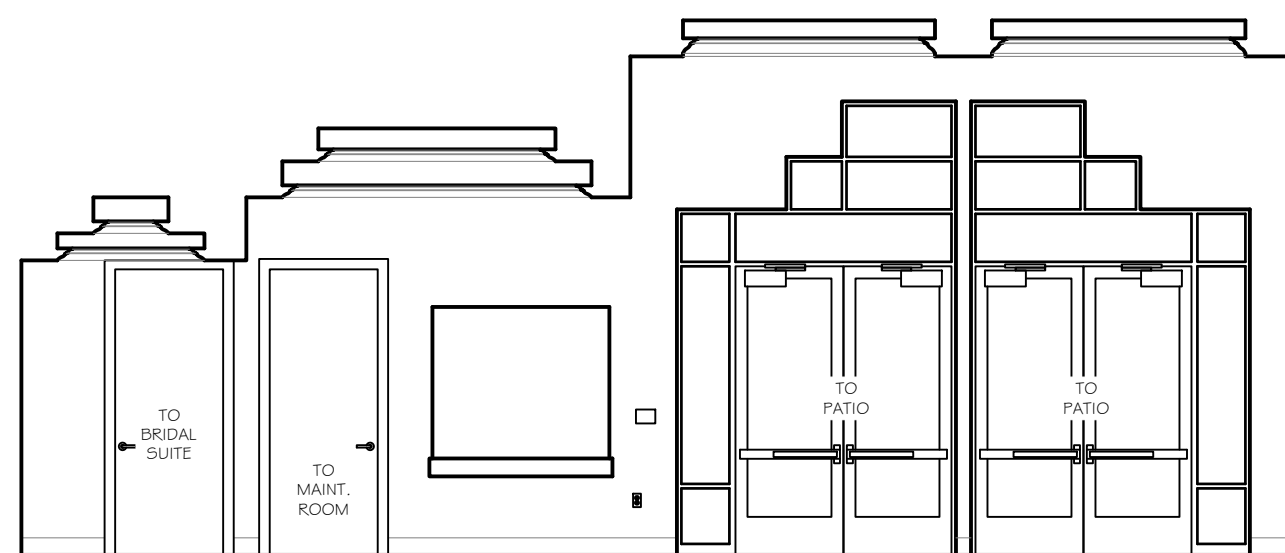


104 HALL

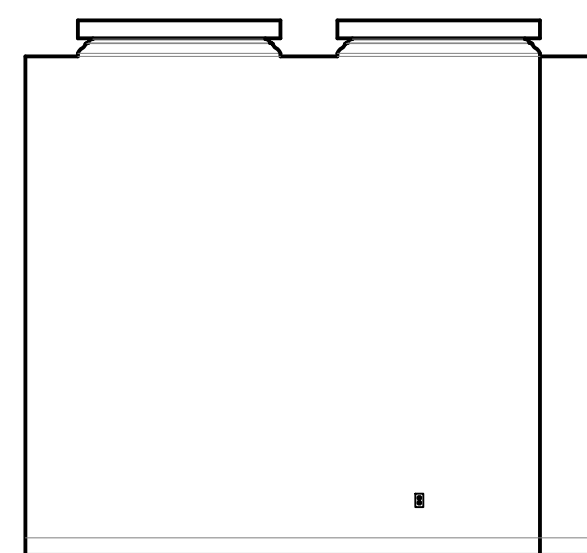


105 HALL

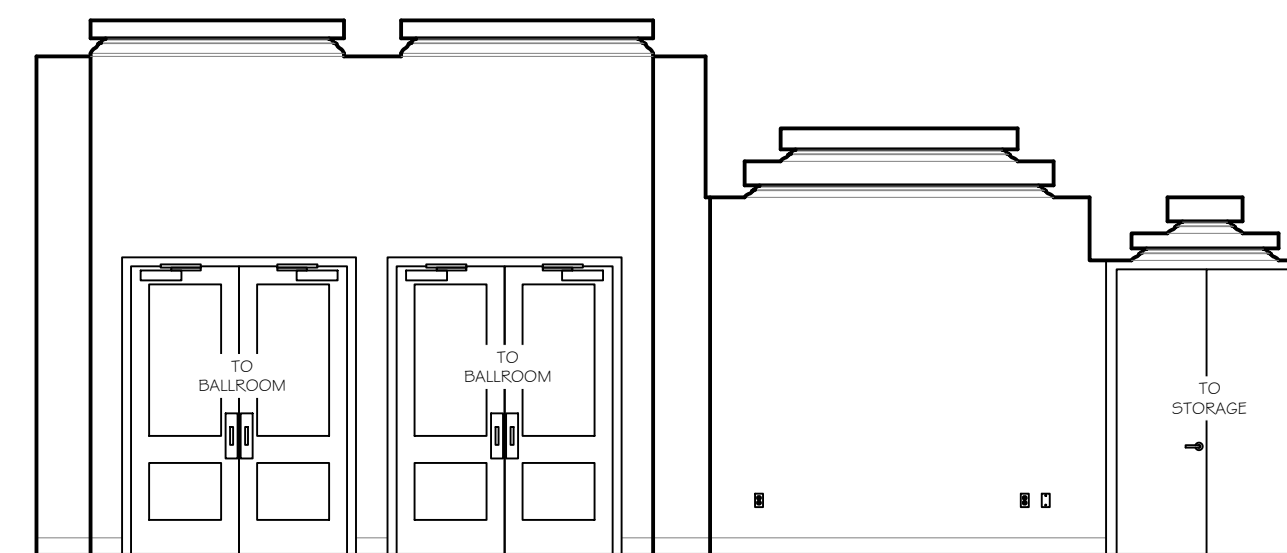


106 HALL

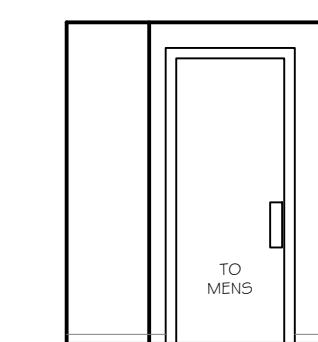


107 HALL

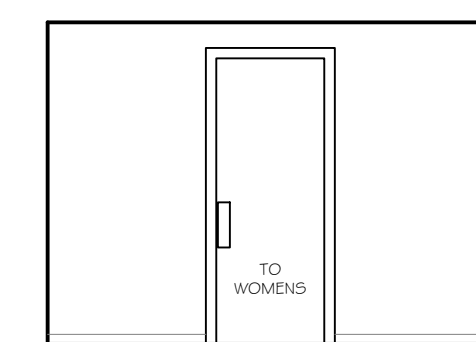

108 HALL

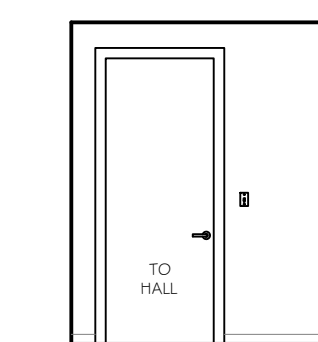

109 HALL

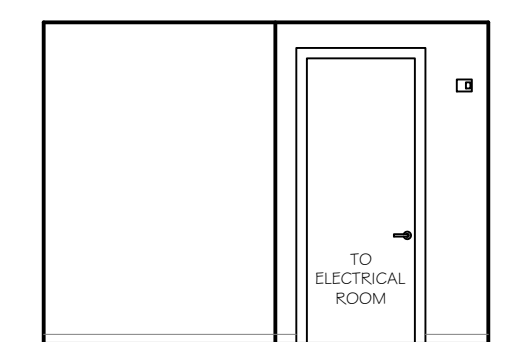

110 HALL

PREPARED FOR

CLIENT NAME

PROJECT TYPE

INTERIOR ELEVATIONS

PROJECT NAME

COUNTRY CLUB

PROJECT ADDRESS

STREET CITY, ST 00000

All plans created by Precision Property Measurements, LLC ("PPM") are made exclusively for the purposes of the project and are not to be used for any other purpose. PPM does not warrant the accuracy of the information shown on these plans. PPM makes every reasonable effort to ensure the accuracy of the information shown on these plans. However, some errors may occur due to human error or other factors. PPM is not responsible for any errors or omissions. The user of these plans should verify all dimensions and locations before construction. PPM's liability is limited to the amount of the fee paid to PPM.

SCALE 3/16" = 1'-0"


PROJECT 0000\_ZZ

APPROVED BY XX


DATE 00/00/2023

SHEET


7 of 15

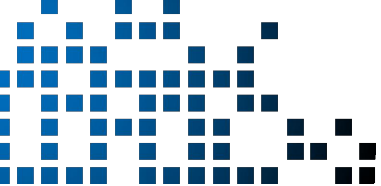




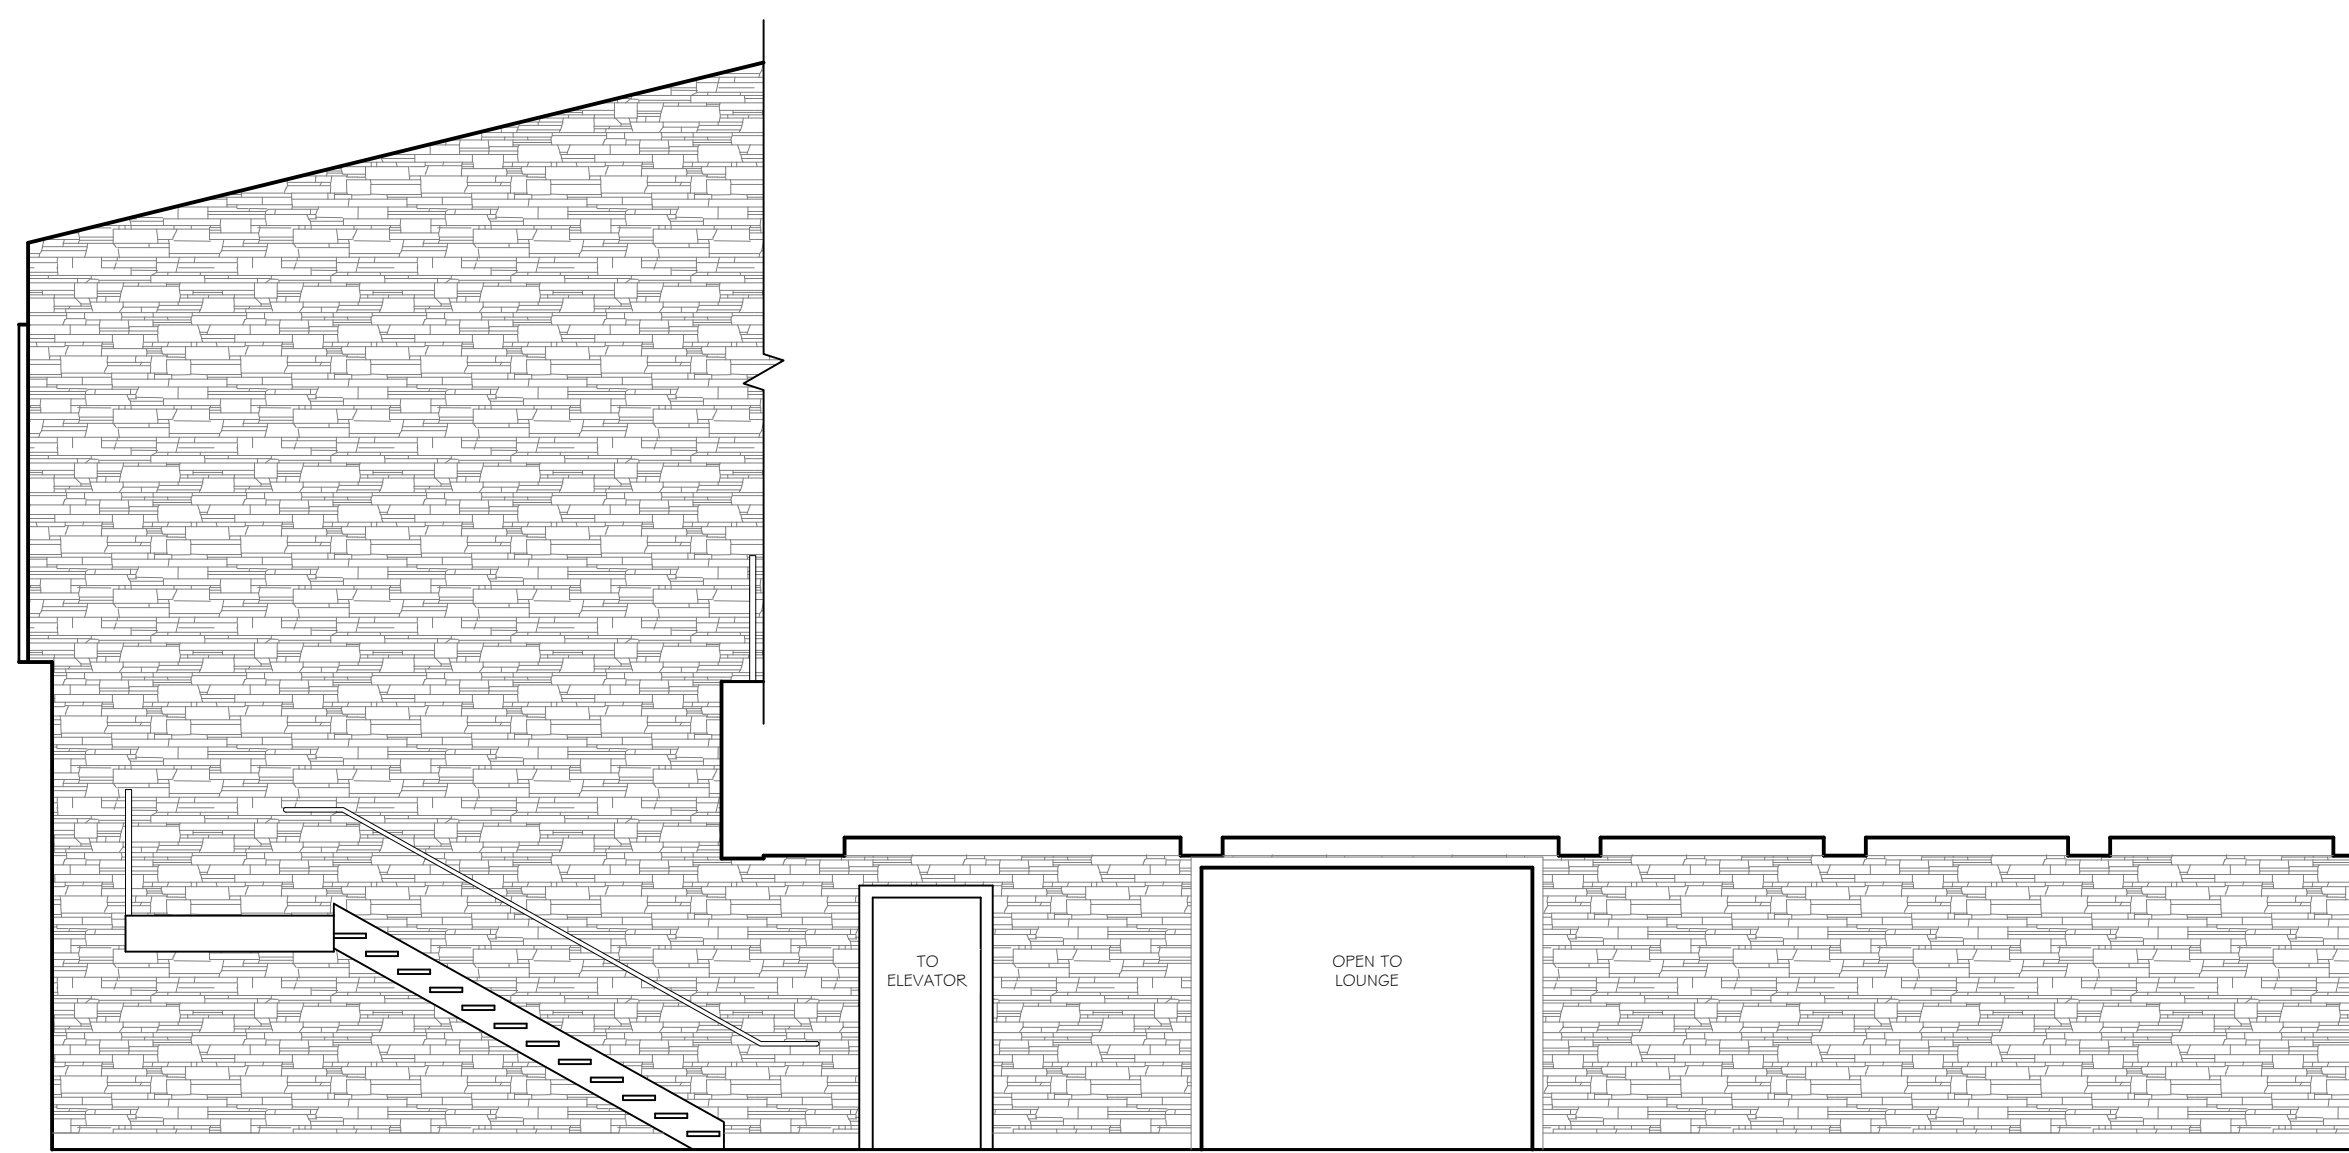


151 CORRIDOR

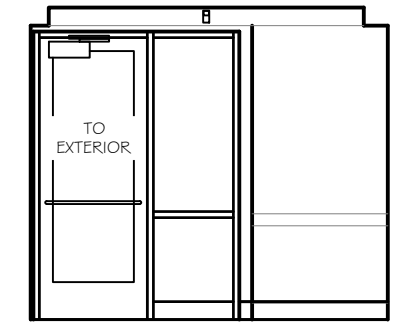


152 CORRIDOR

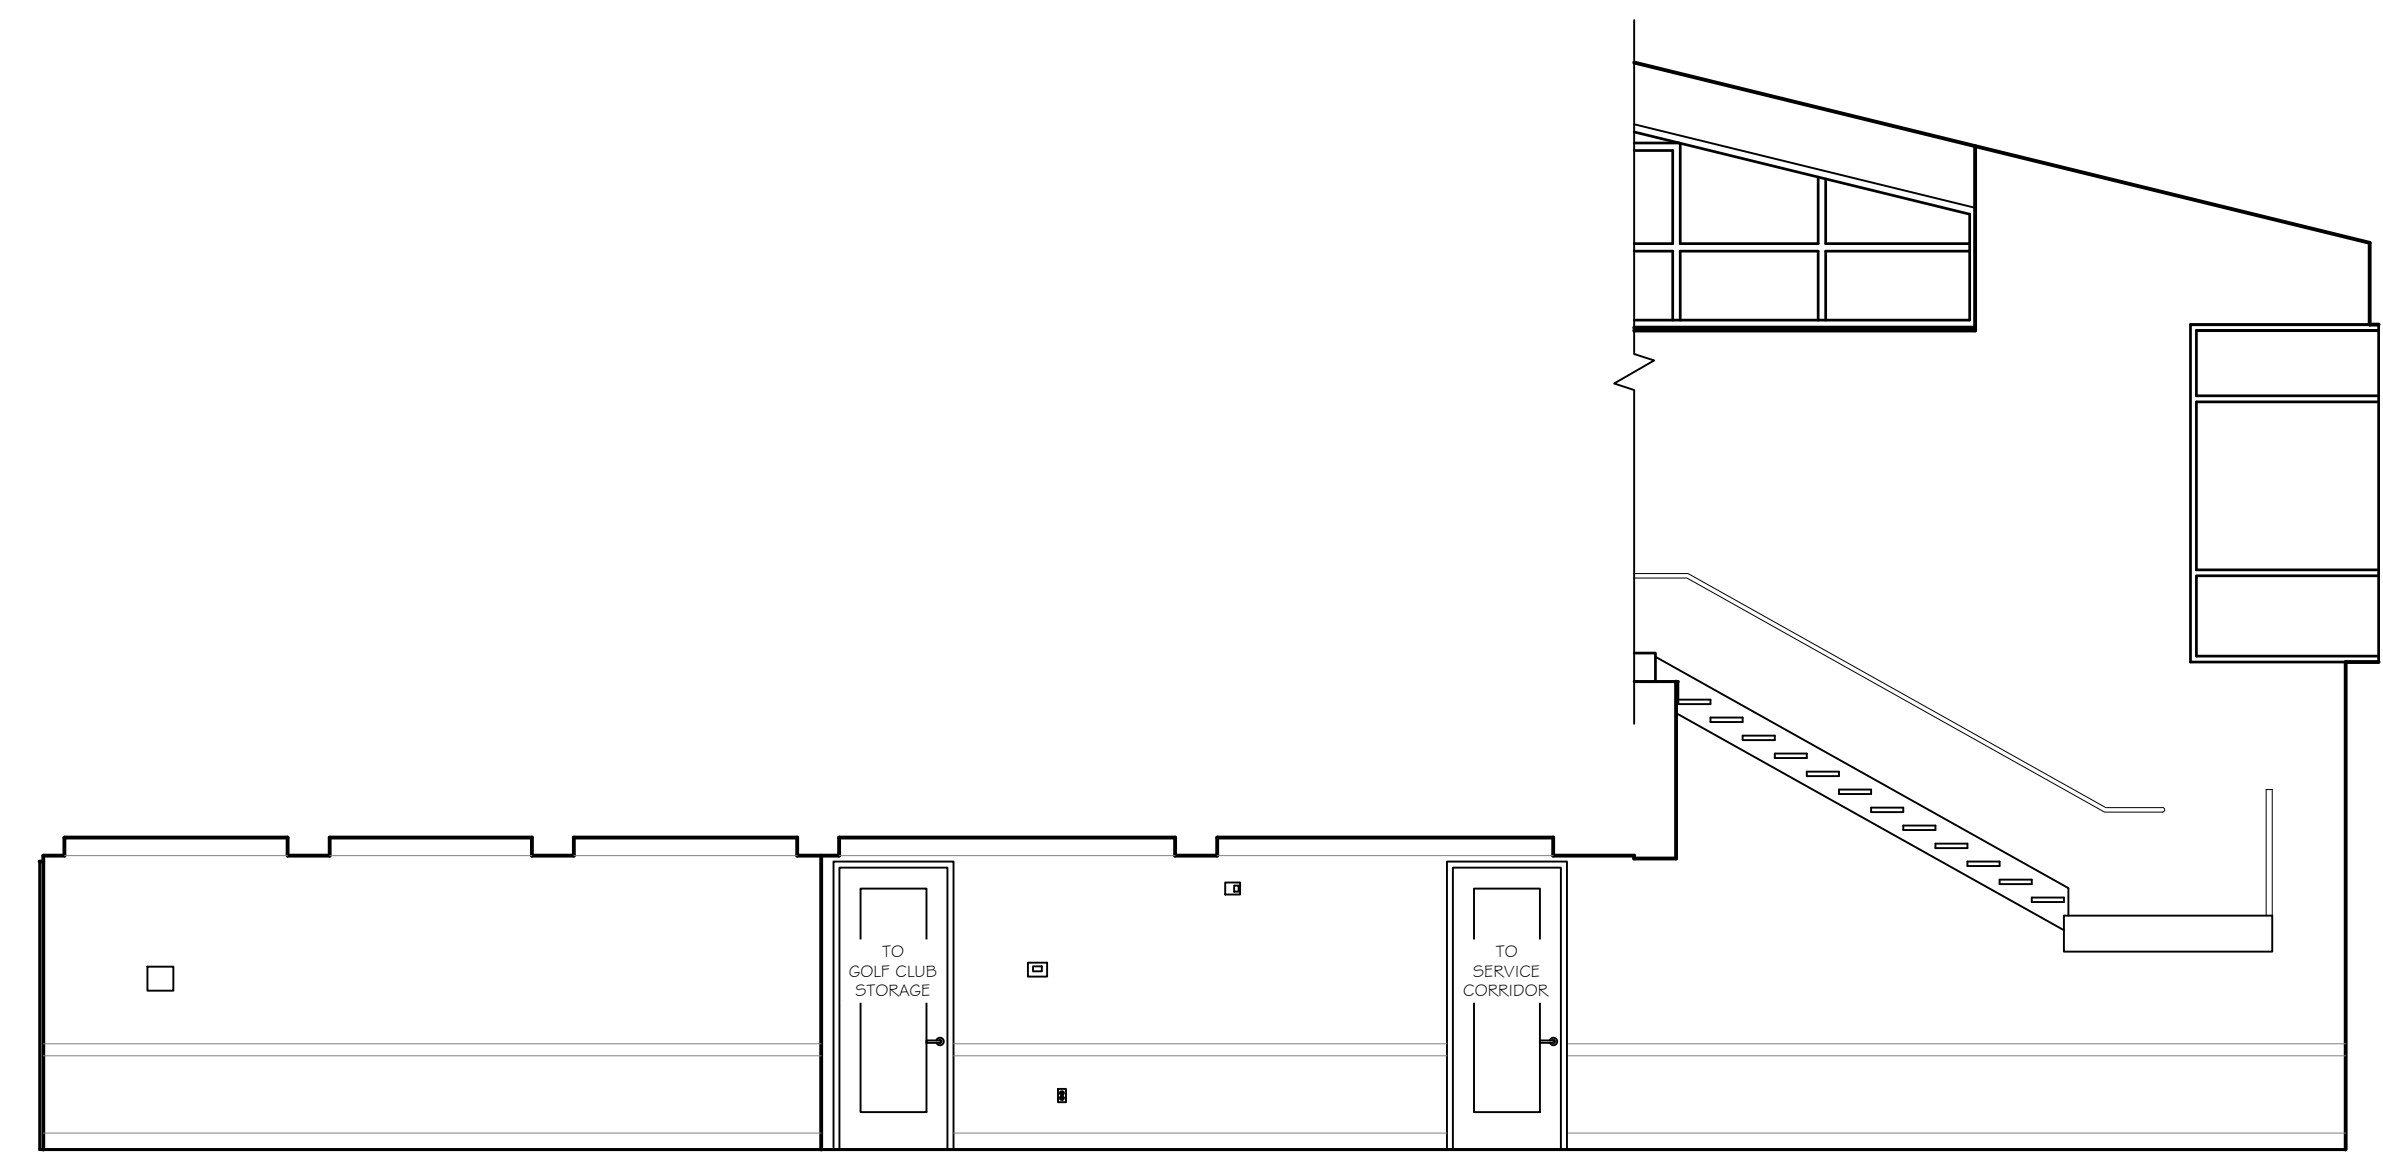


153 CORRIDOR

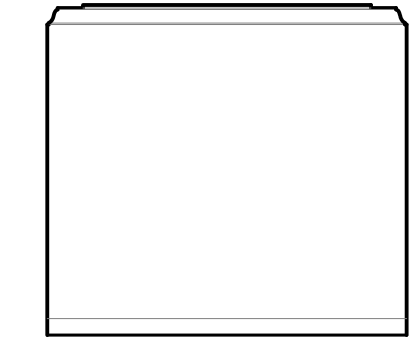


154 VESTIBULE

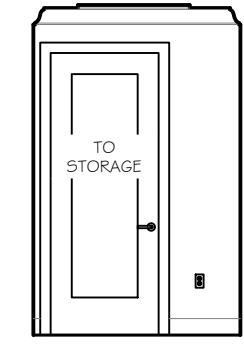


155 VESTIBULE

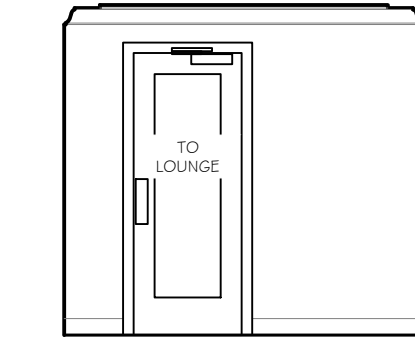


156 VESTIBULE

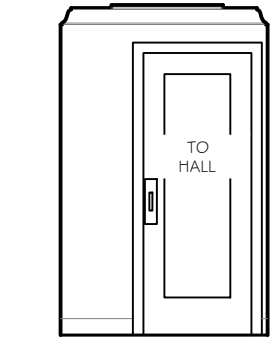


157 VESTIBULE

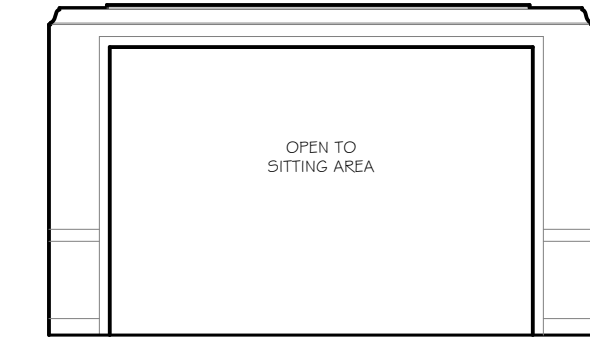


158 HALL

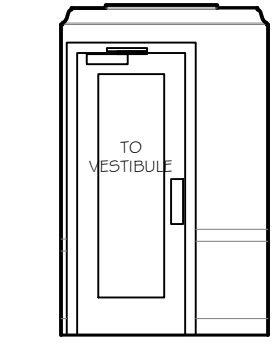


159 HALL

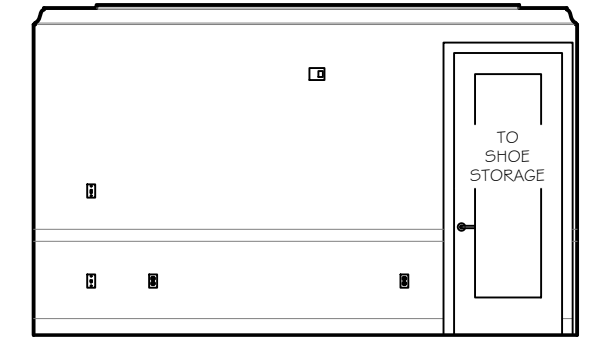


160 HALL

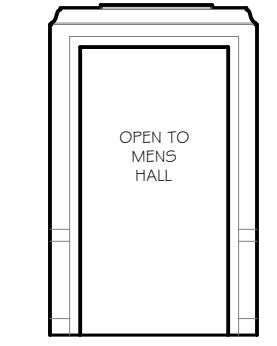


161 HALL

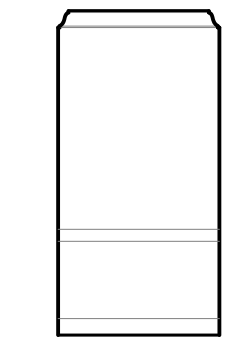


162 MENS HALL

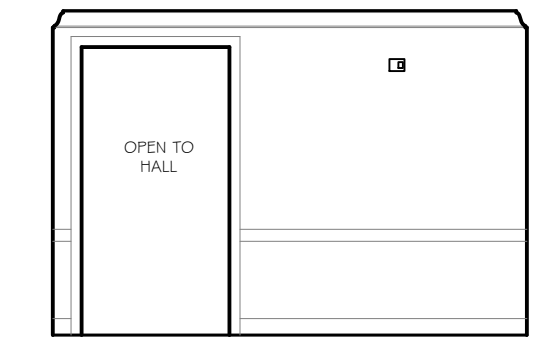


163 MENS HALL

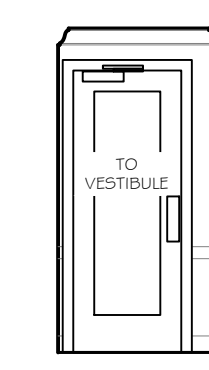


164 MENS HALL

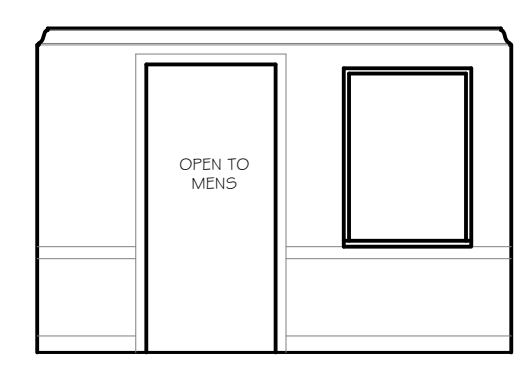


165 MENS HALL

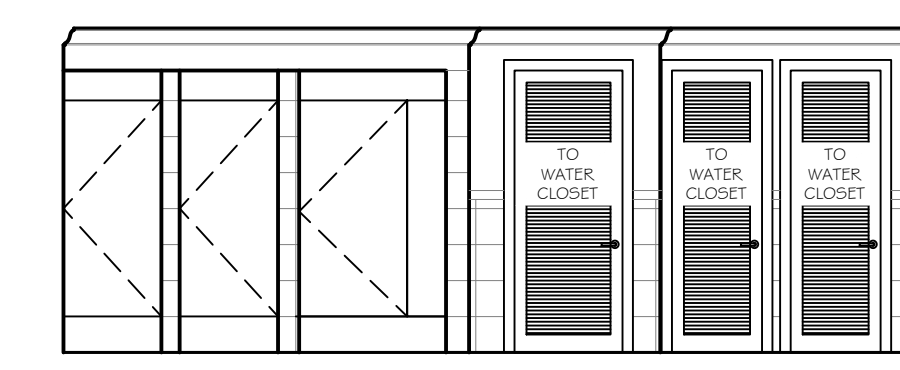


166 MENS

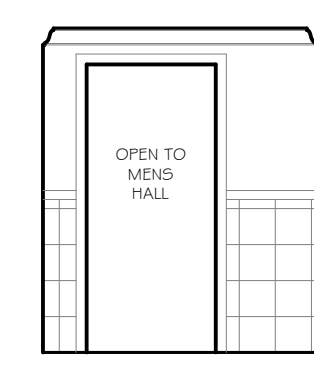


167 MENS

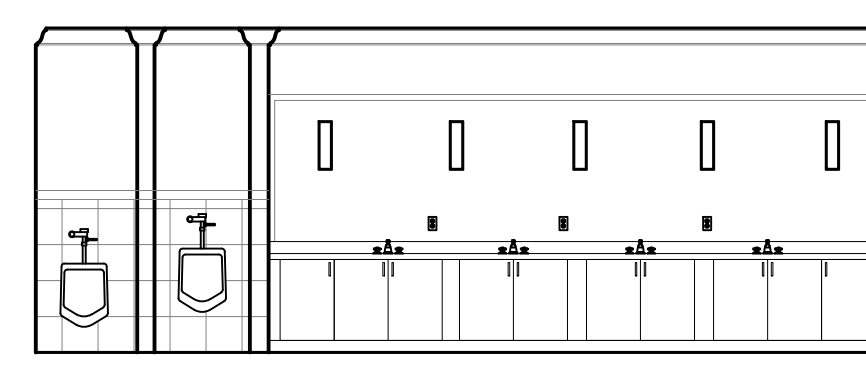


168 MENS

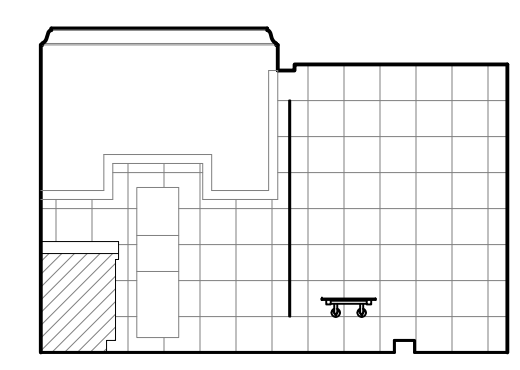


169 MENS

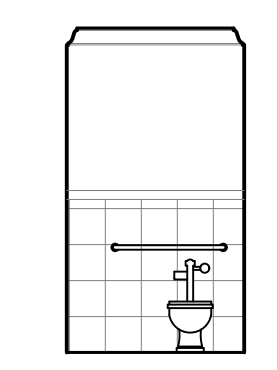


170 W.C.

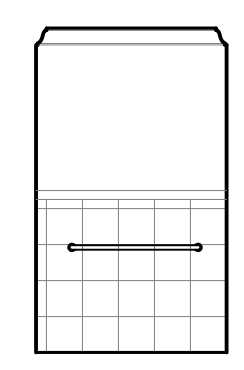


171 W.C.

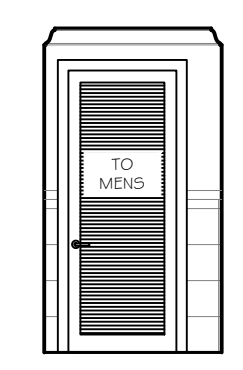


172 W.C.

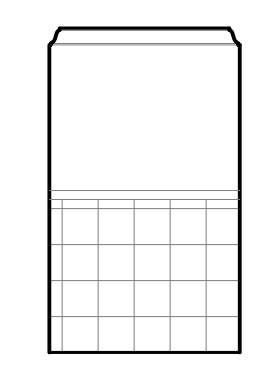


173 W.C.

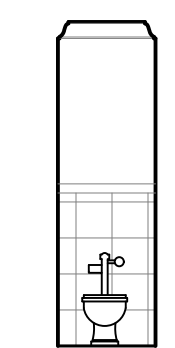


174 W.C.

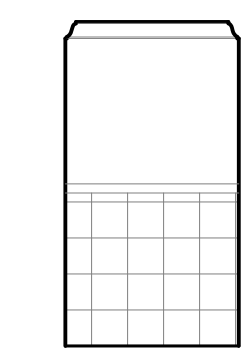


175 W.C.

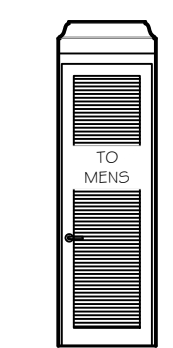


176 W.C.

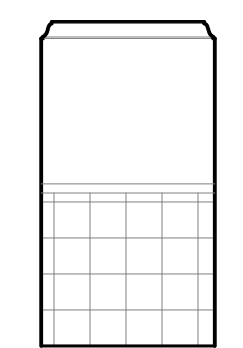


177 W.C.

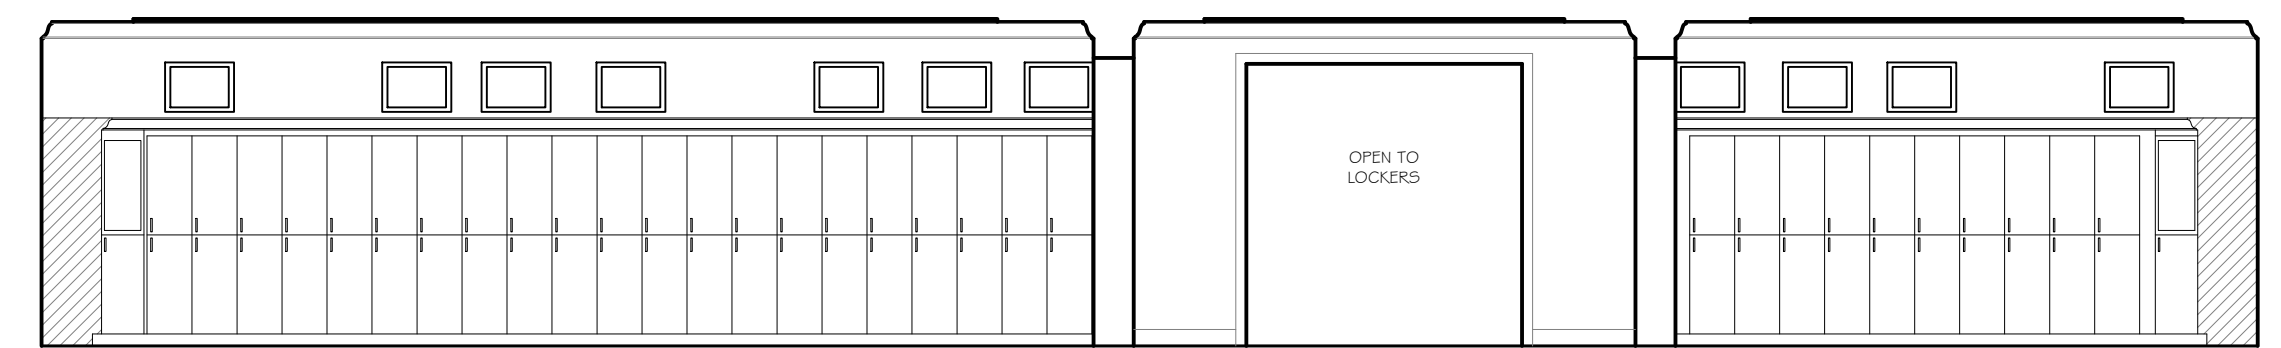


178 MENS LOCKER

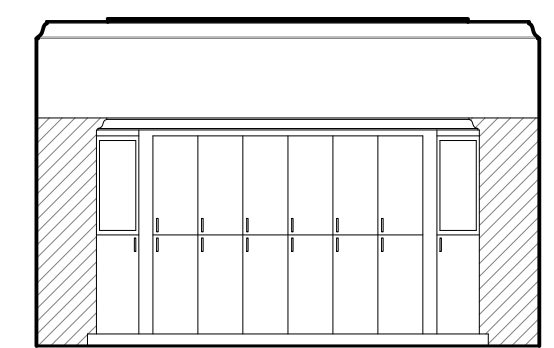


179 MENS LOCKER

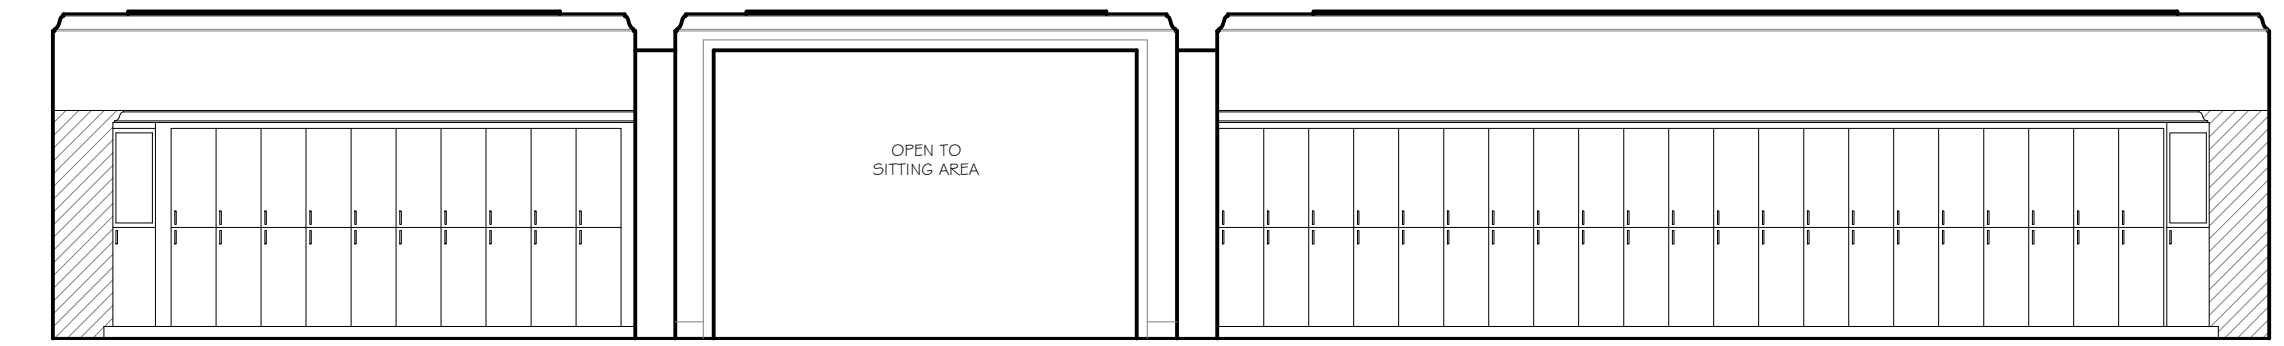

180 MENS LOCKER

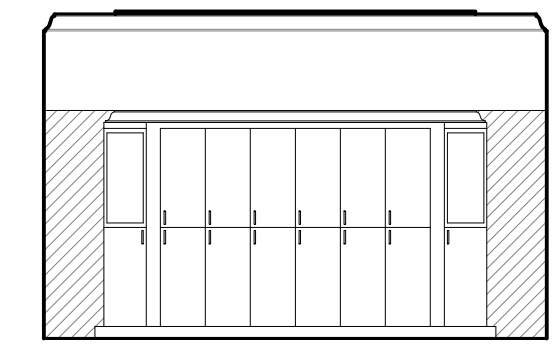

181 MENS LOCKER

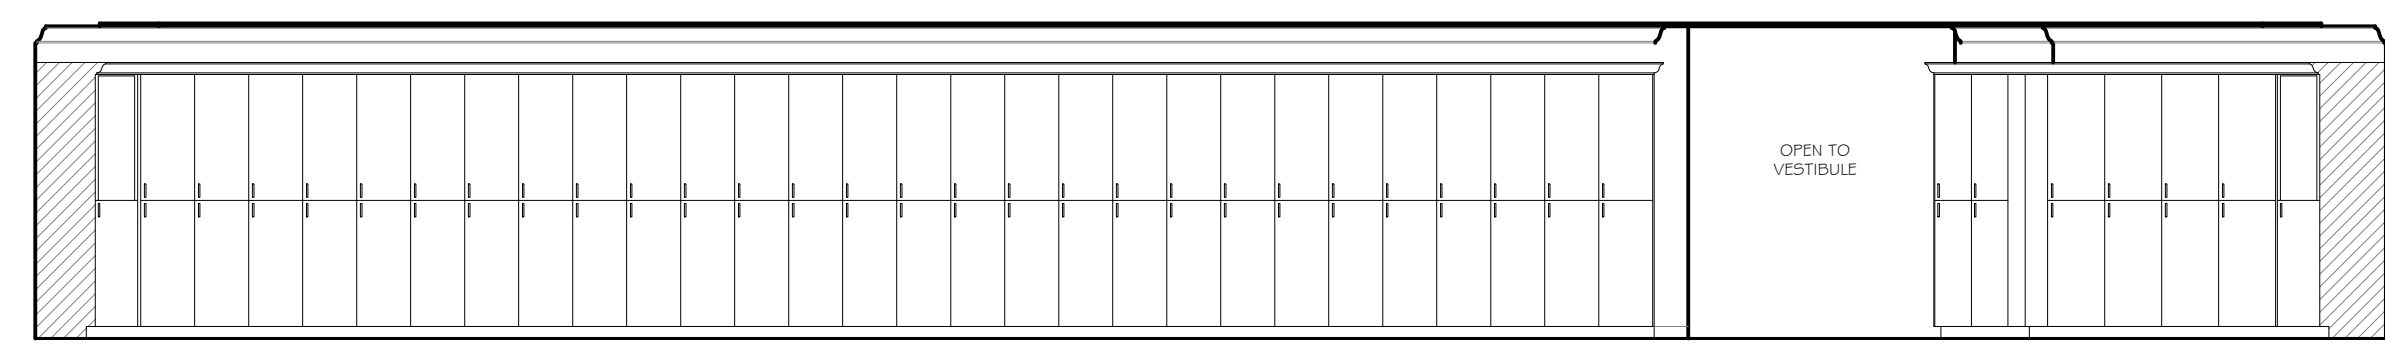

182 MENS LOCKER



PREPARED FOR

CLIENT NAME

PROJECT TYPE

INTERIOR  
ELEVATIONS


PROJECT NAME

COUNTRY CLUB


PROJECT ADDRESS

STREET  
CITY, ST 00000


All plans created by Precision Property Measurements, LLC ("PPM") are made exclusively for the purposes of the project and are not to be used for any other purpose. PPM does not warrant the accuracy of any information provided in these plans and does not assume any liability for any errors or omissions. PPM is not a licensed architect or engineer and does not provide any professional services. PPM is not responsible for any construction or other work performed in accordance with these plans. PPM's liability is limited to the amount of the fee paid to PPM.

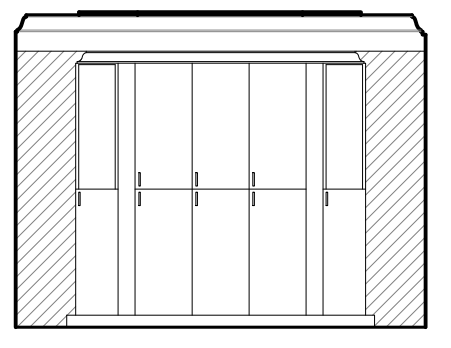


183 MENS LOCKER

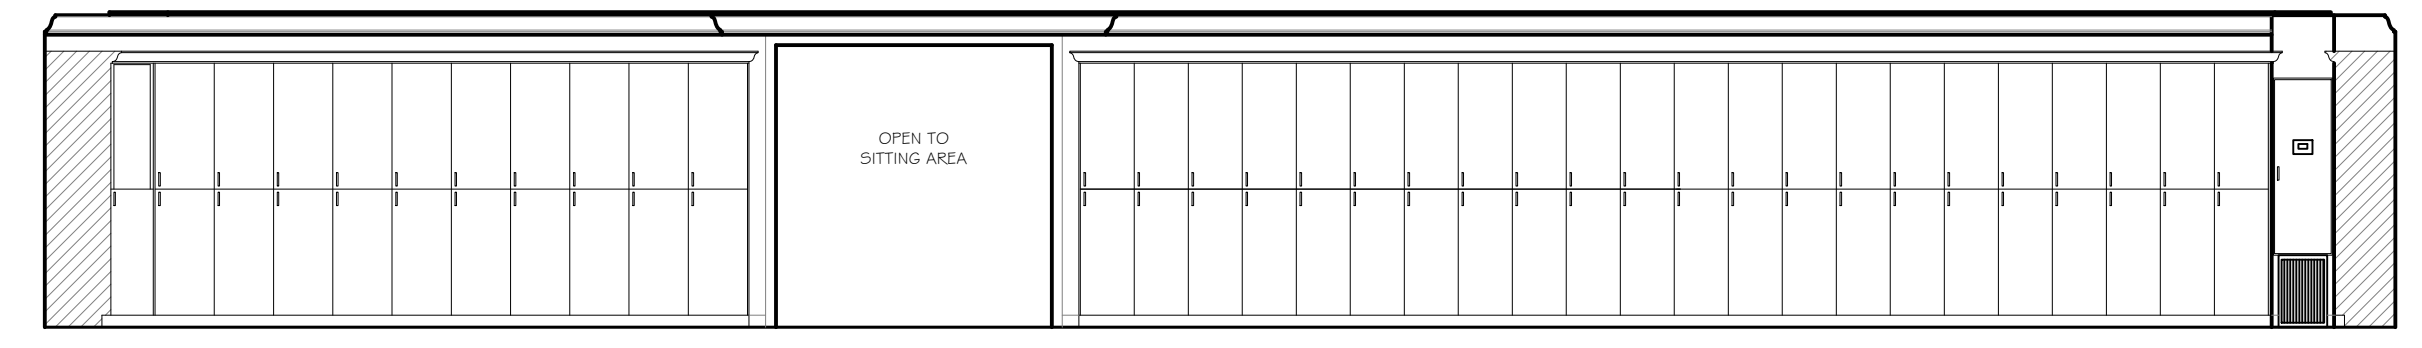

184 MENS LOCKER

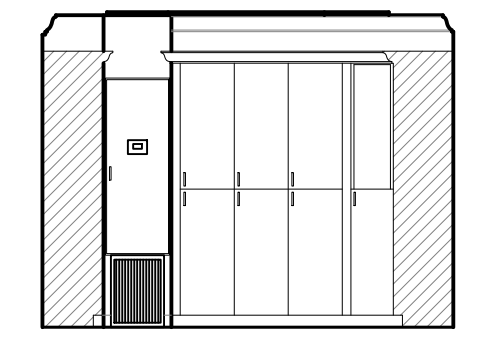


185 MENS LOCKER

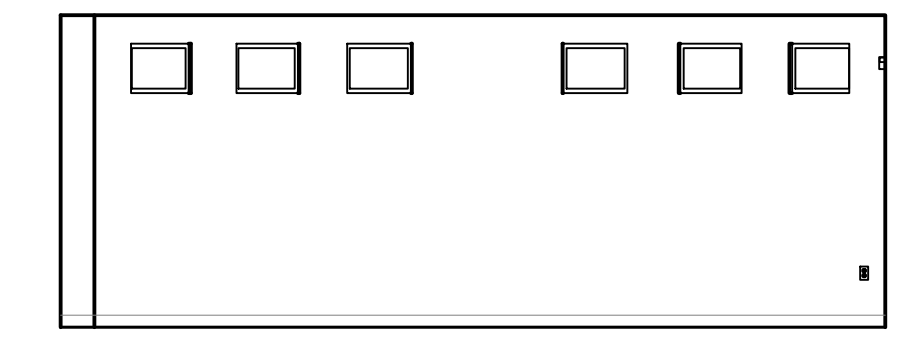


186 VESTIBULE




187 VESTIBULE

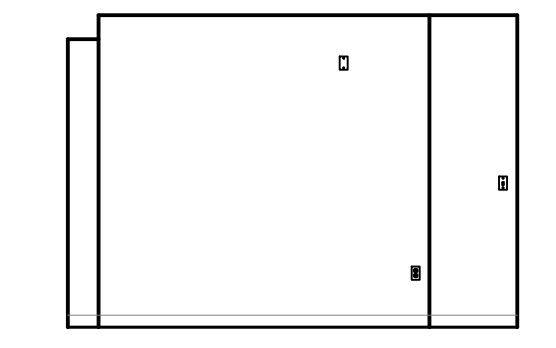

188 VESTIBULE

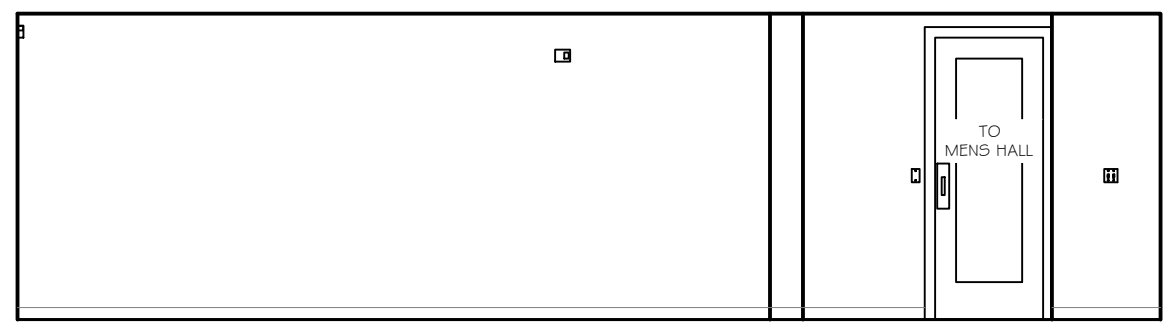


189 POKER ROOM

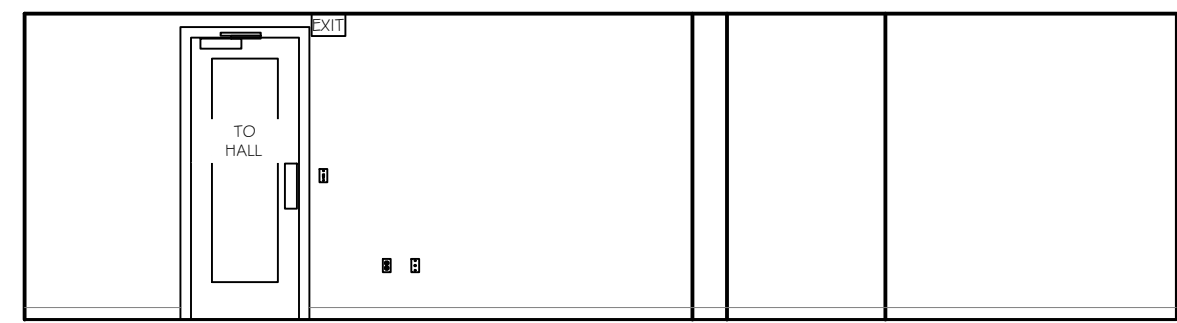


190 POKER ROOM




191 POKER ROOM

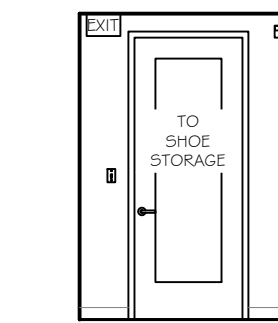


192 POKER ROOM

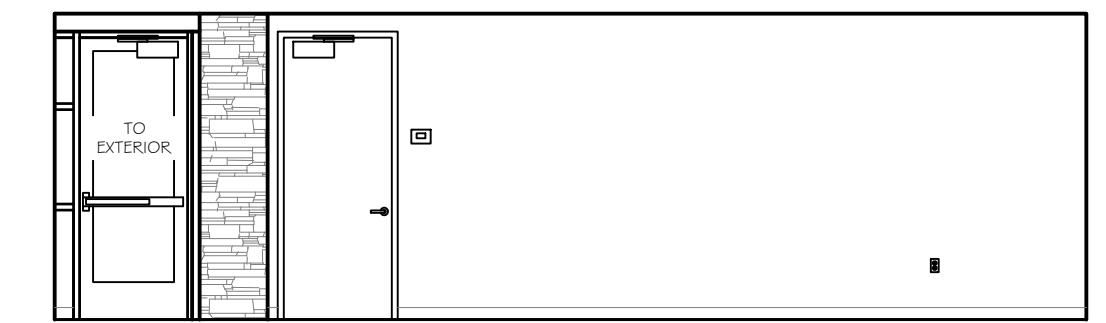


193 POKER ROOM

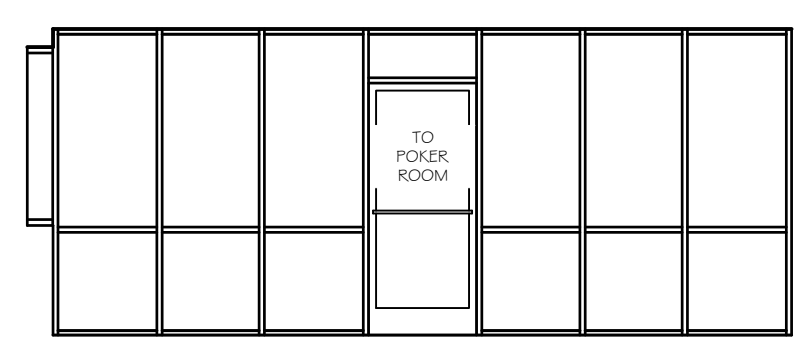


194 SMOKING ROOM

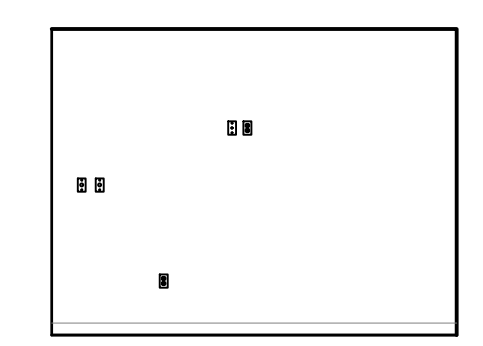


195 SMOKING ROOM

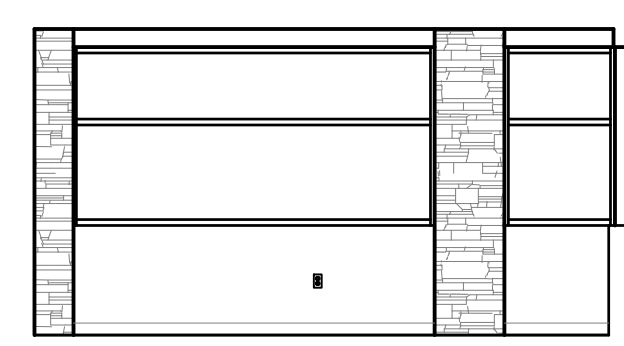


196 SMOKING ROOM

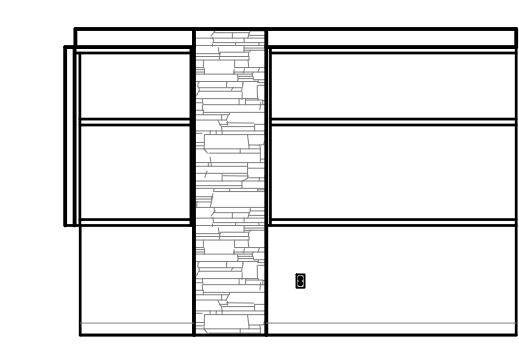


197 SMOKING ROOM

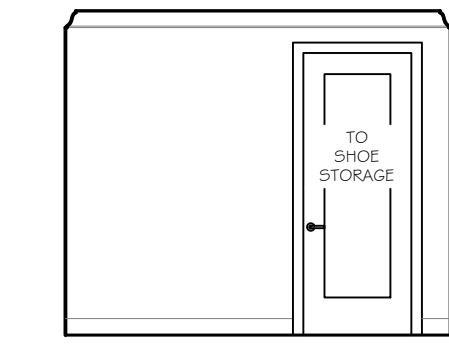


198 HALL

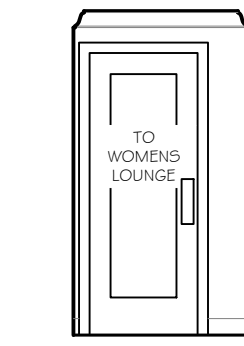

199 HALL

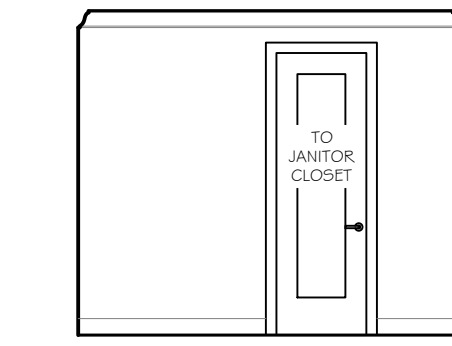

200 HALL

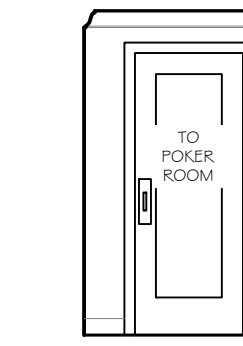

201 HALL

