

MEASUREMENTS

3626 E. PACIFIC COAST HIGHWAY | 2ND FLOOR LONG BEACH CA | 90804 T 562.621.9100 F 888.698.2966 WWW.PPMCO.NET



PREPARED FOR

ARCHITECT PLANNING

FLOOR PLAN

PROJECT NAME

PROJECT

PROJECT ADDRESS

1234 CHERRY TREE BOULEVARD LONG BEACH, CA 90000




 $\frac{3}{32}$ " = 1'-0" PROJECT 12345

APPROVED BY CT

DATE 07/30/18

2 of 47

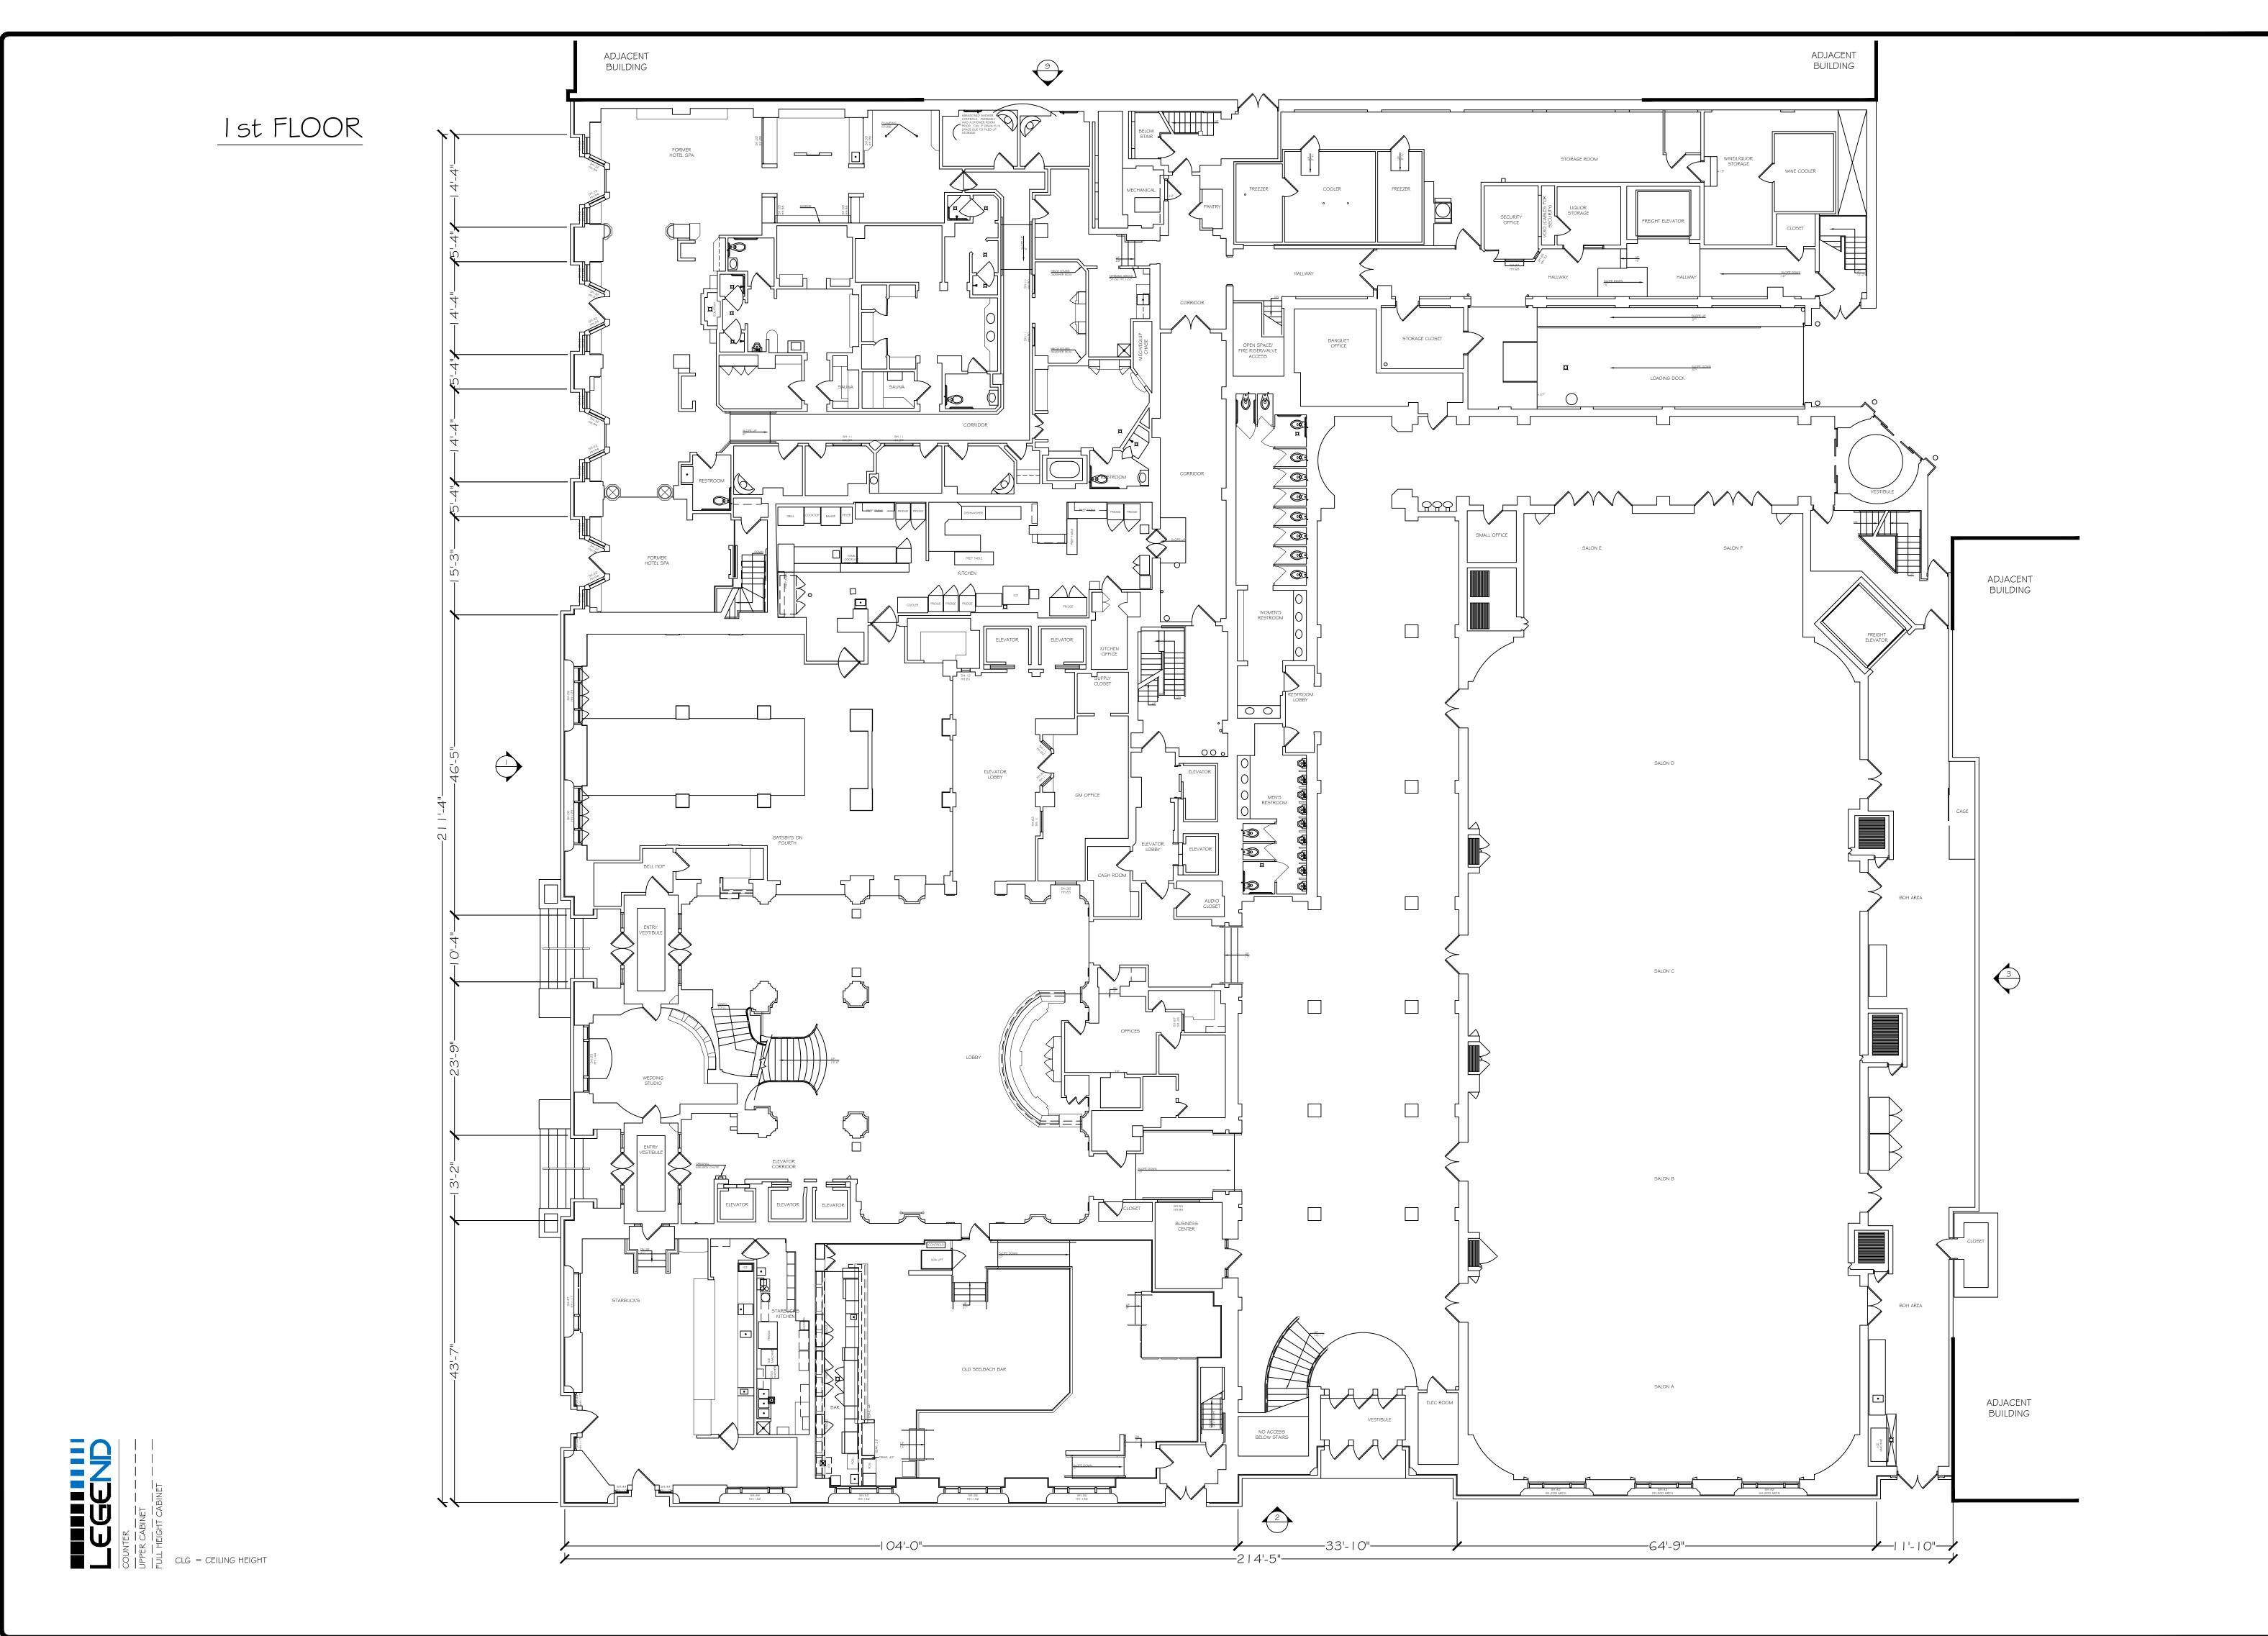



MEASUREMENTS

3626 E. PACIFIC COAST HIGHWAY | 2ND FLOOR LONG BEACH CA | 90804 T 562.621.9100 F 888.698.2966 WWW.PPMCO.NET



PREPARED FOR

ARCHITECT PLANNING

PROJECT TYPE

FLOOR PLAN

PROJECT NAME

THE PPM PROJECT

PROJECT ADDRESS

I 234 CHERRY TREE BOULEVARD LONG BEACH, CA 90000

All plans created by Precision Property
Measurement Ltd "PPM" are made exclusively
for landscaping purposes (Cal. Bus. & Prof.
Code §8727). All site plans created by PPM do not
involve the determination of any property line, and as
such do not constitute land surveying
(Cal. Bus. & Prof. Code §96726-8727). In
addition, PPM services and plans do not constitute
civil engineering (Cal. Bus. & Prof. Code §96702-6704),
and thus should not be used for any studies or activities
defined as civil engineering (Cal. Bus. & Prof. Code
§6731). All floor plans created by PPM are intended to
be used as a reference for design and construction and
should not be considered a substitute for the services of
a licensed structural engineer on licensed architect. PPM
makes every reasonable effort to ensure the accuracy of
the information found in our plans. However, every
As-Built drawing inherently contains errors to some
degree. It is the duty of the architect, contractor,
designer or other licensed professional, as a consultant
to the property owner, to determine the suitability of the
s-Built plans prior to construction. Measurements should
se field confirmed before commencing construction, in the



SCALE

3/32" = 1'-0"

PROJECT

1 2345

I 2345


APPROVED BY

CT

07/30/18

3 of 47

BASEMENT FLOOR

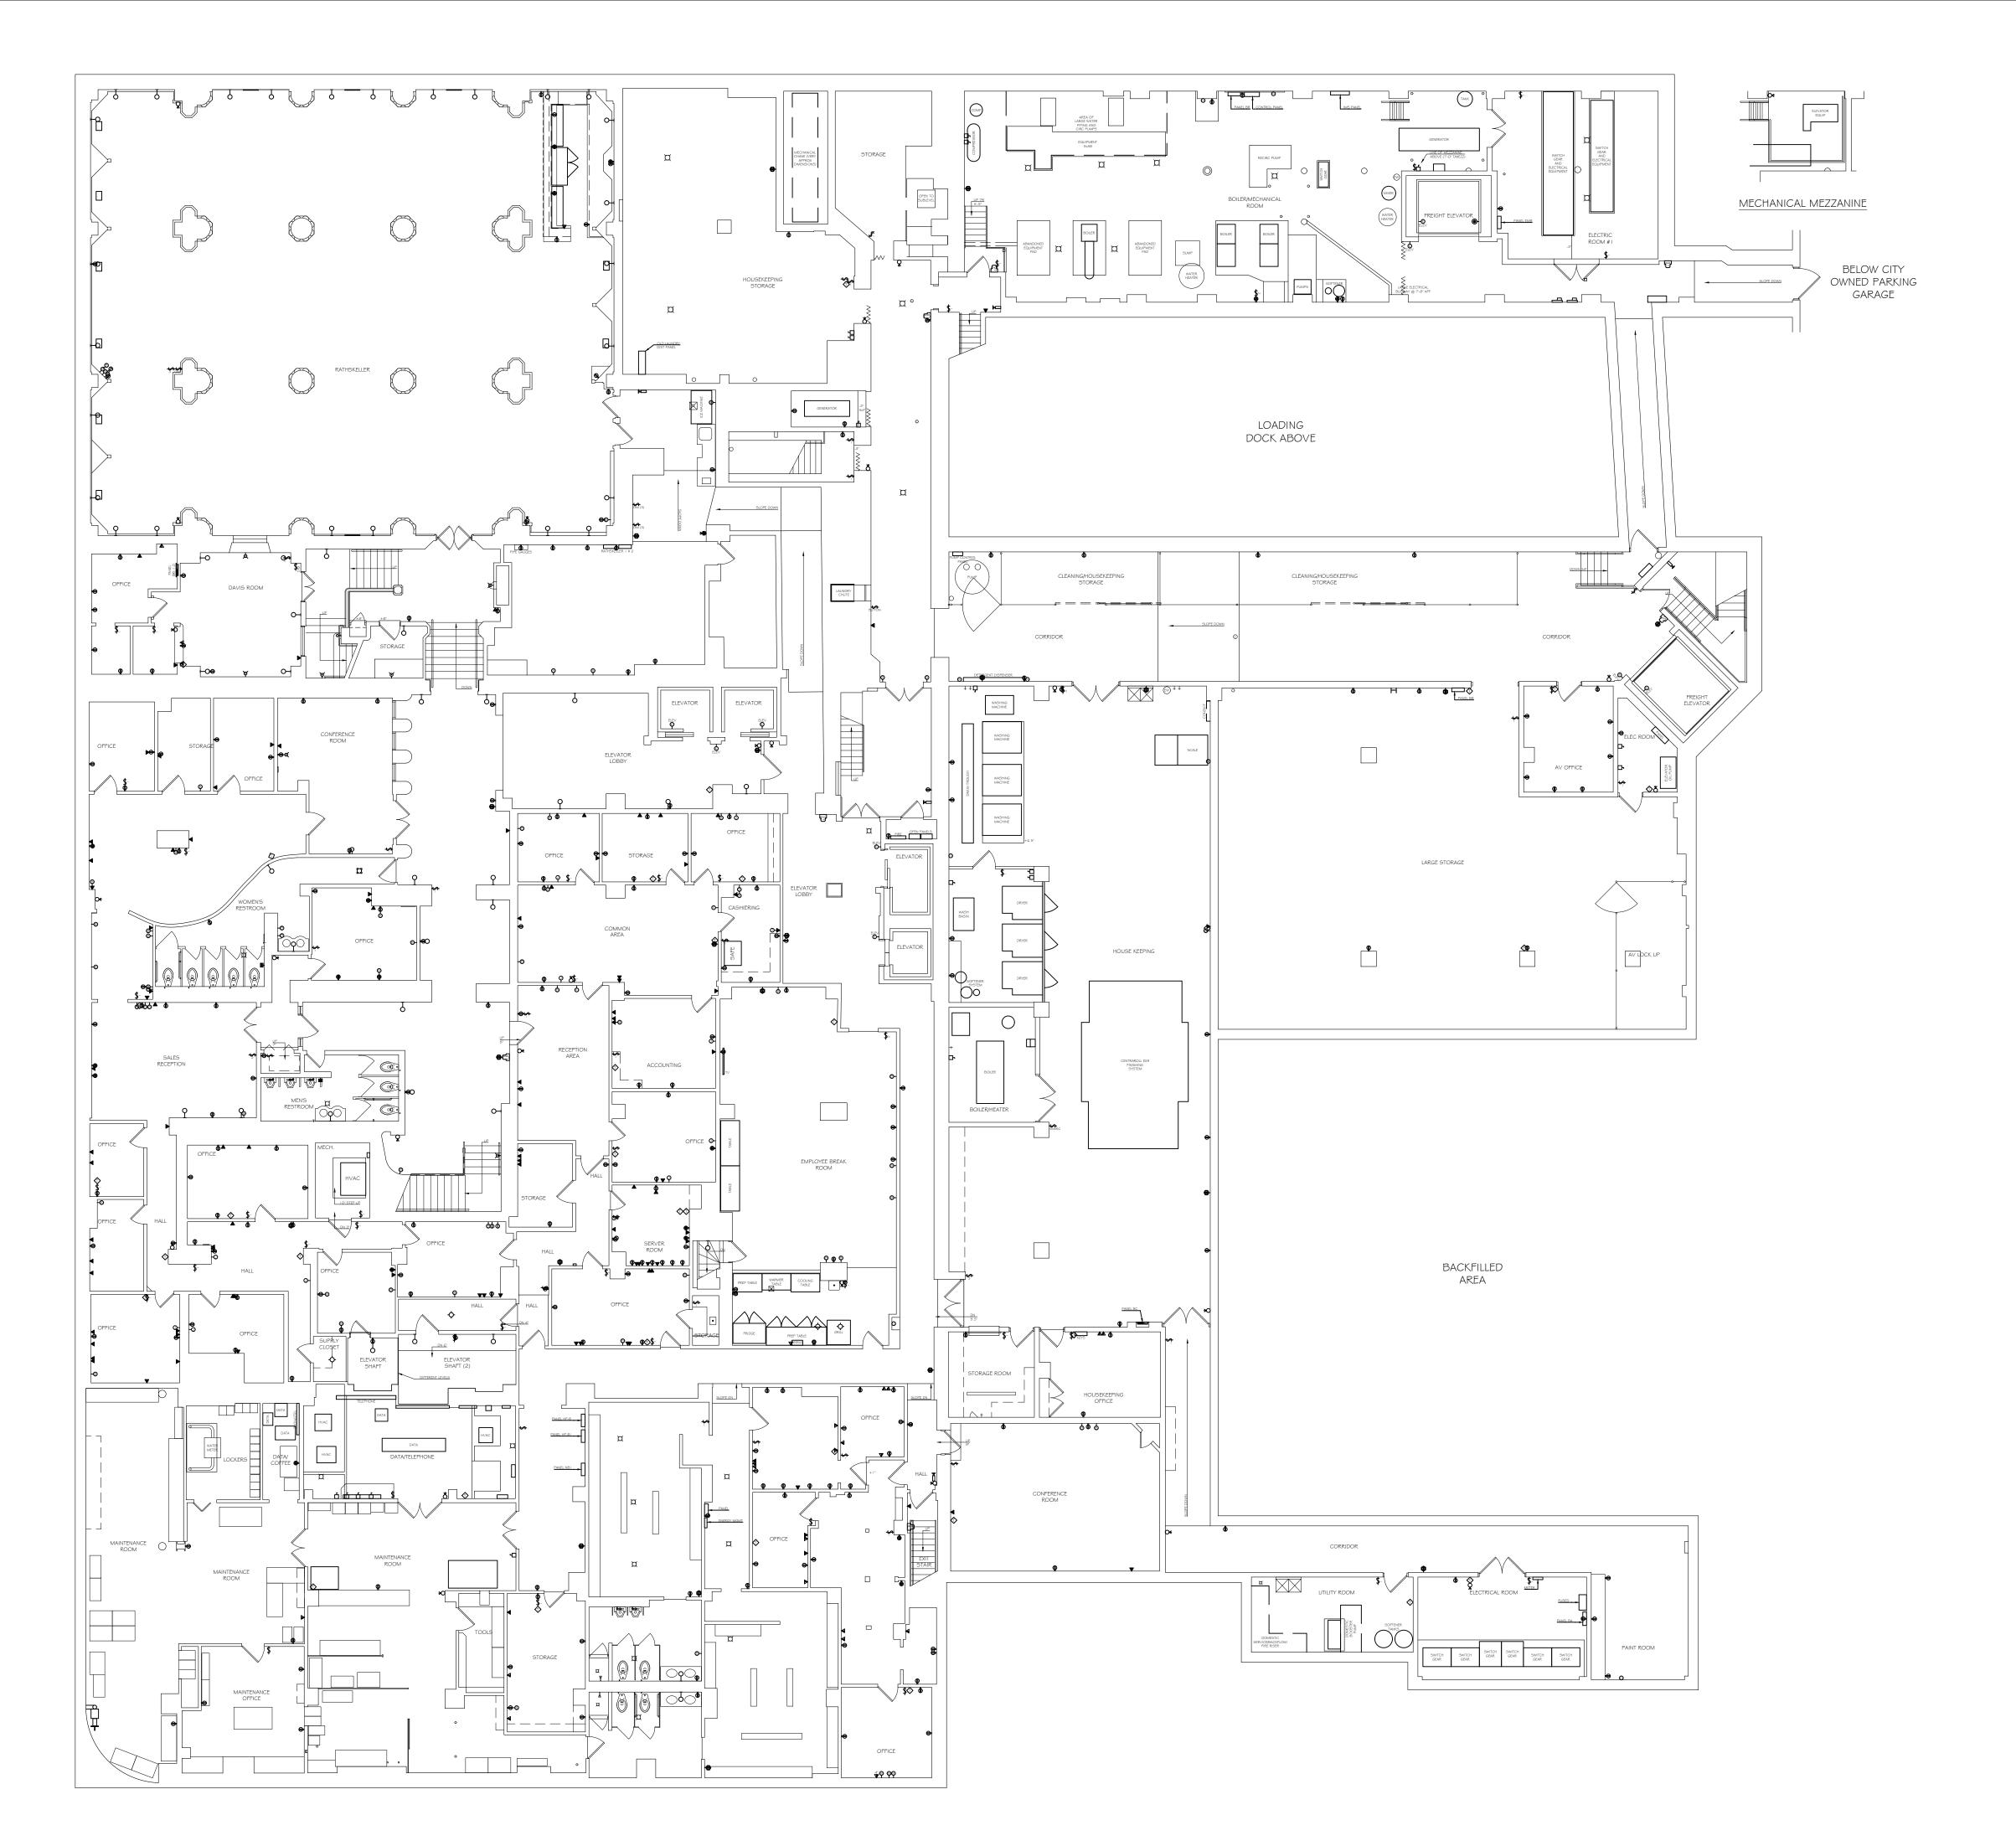



 ⇒
 = GFI OUTLET

 \Rightarrow = THERMOSTAT A = ALARM CONTROLS ⇒ = ELECTRICAL OUTLET

O- = WALL MOUNTED FIXTURE

=⊖ = GFI OUTLET = ELECTRICAL PANEL → = CABLE JACK

▲ = ETHERNET JACK SPEAKER -Ø = KEY PAD

\$ = SWITCHM = MOTION SENSOR \triangle = TELEPHONE JACK

PRECISION PROPERTY **MEASUREMENTS**

3626 E. PACIFIC COAST HIGHWAY | 2ND FLOOR LONG BEACH CA | 90804 T 562.621.9100 F 888.698.2966 WWW.PPMCO.NET



PREPARED FOR

ARCHITECT PLANNING

PROJECT TYPE


ELECTRICAL PLAN

PROJECT NAME

PROJECT

PROJECT ADDRESS

1234 CHERRY TREE BOULEVARD LONG BEACH, CA 90000

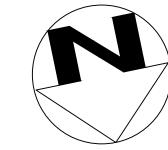


 $\frac{3}{32}$ " = 1'-0" PROJECT 12345

APPROVED BY

CT DATE 07/30/18

17 of 47

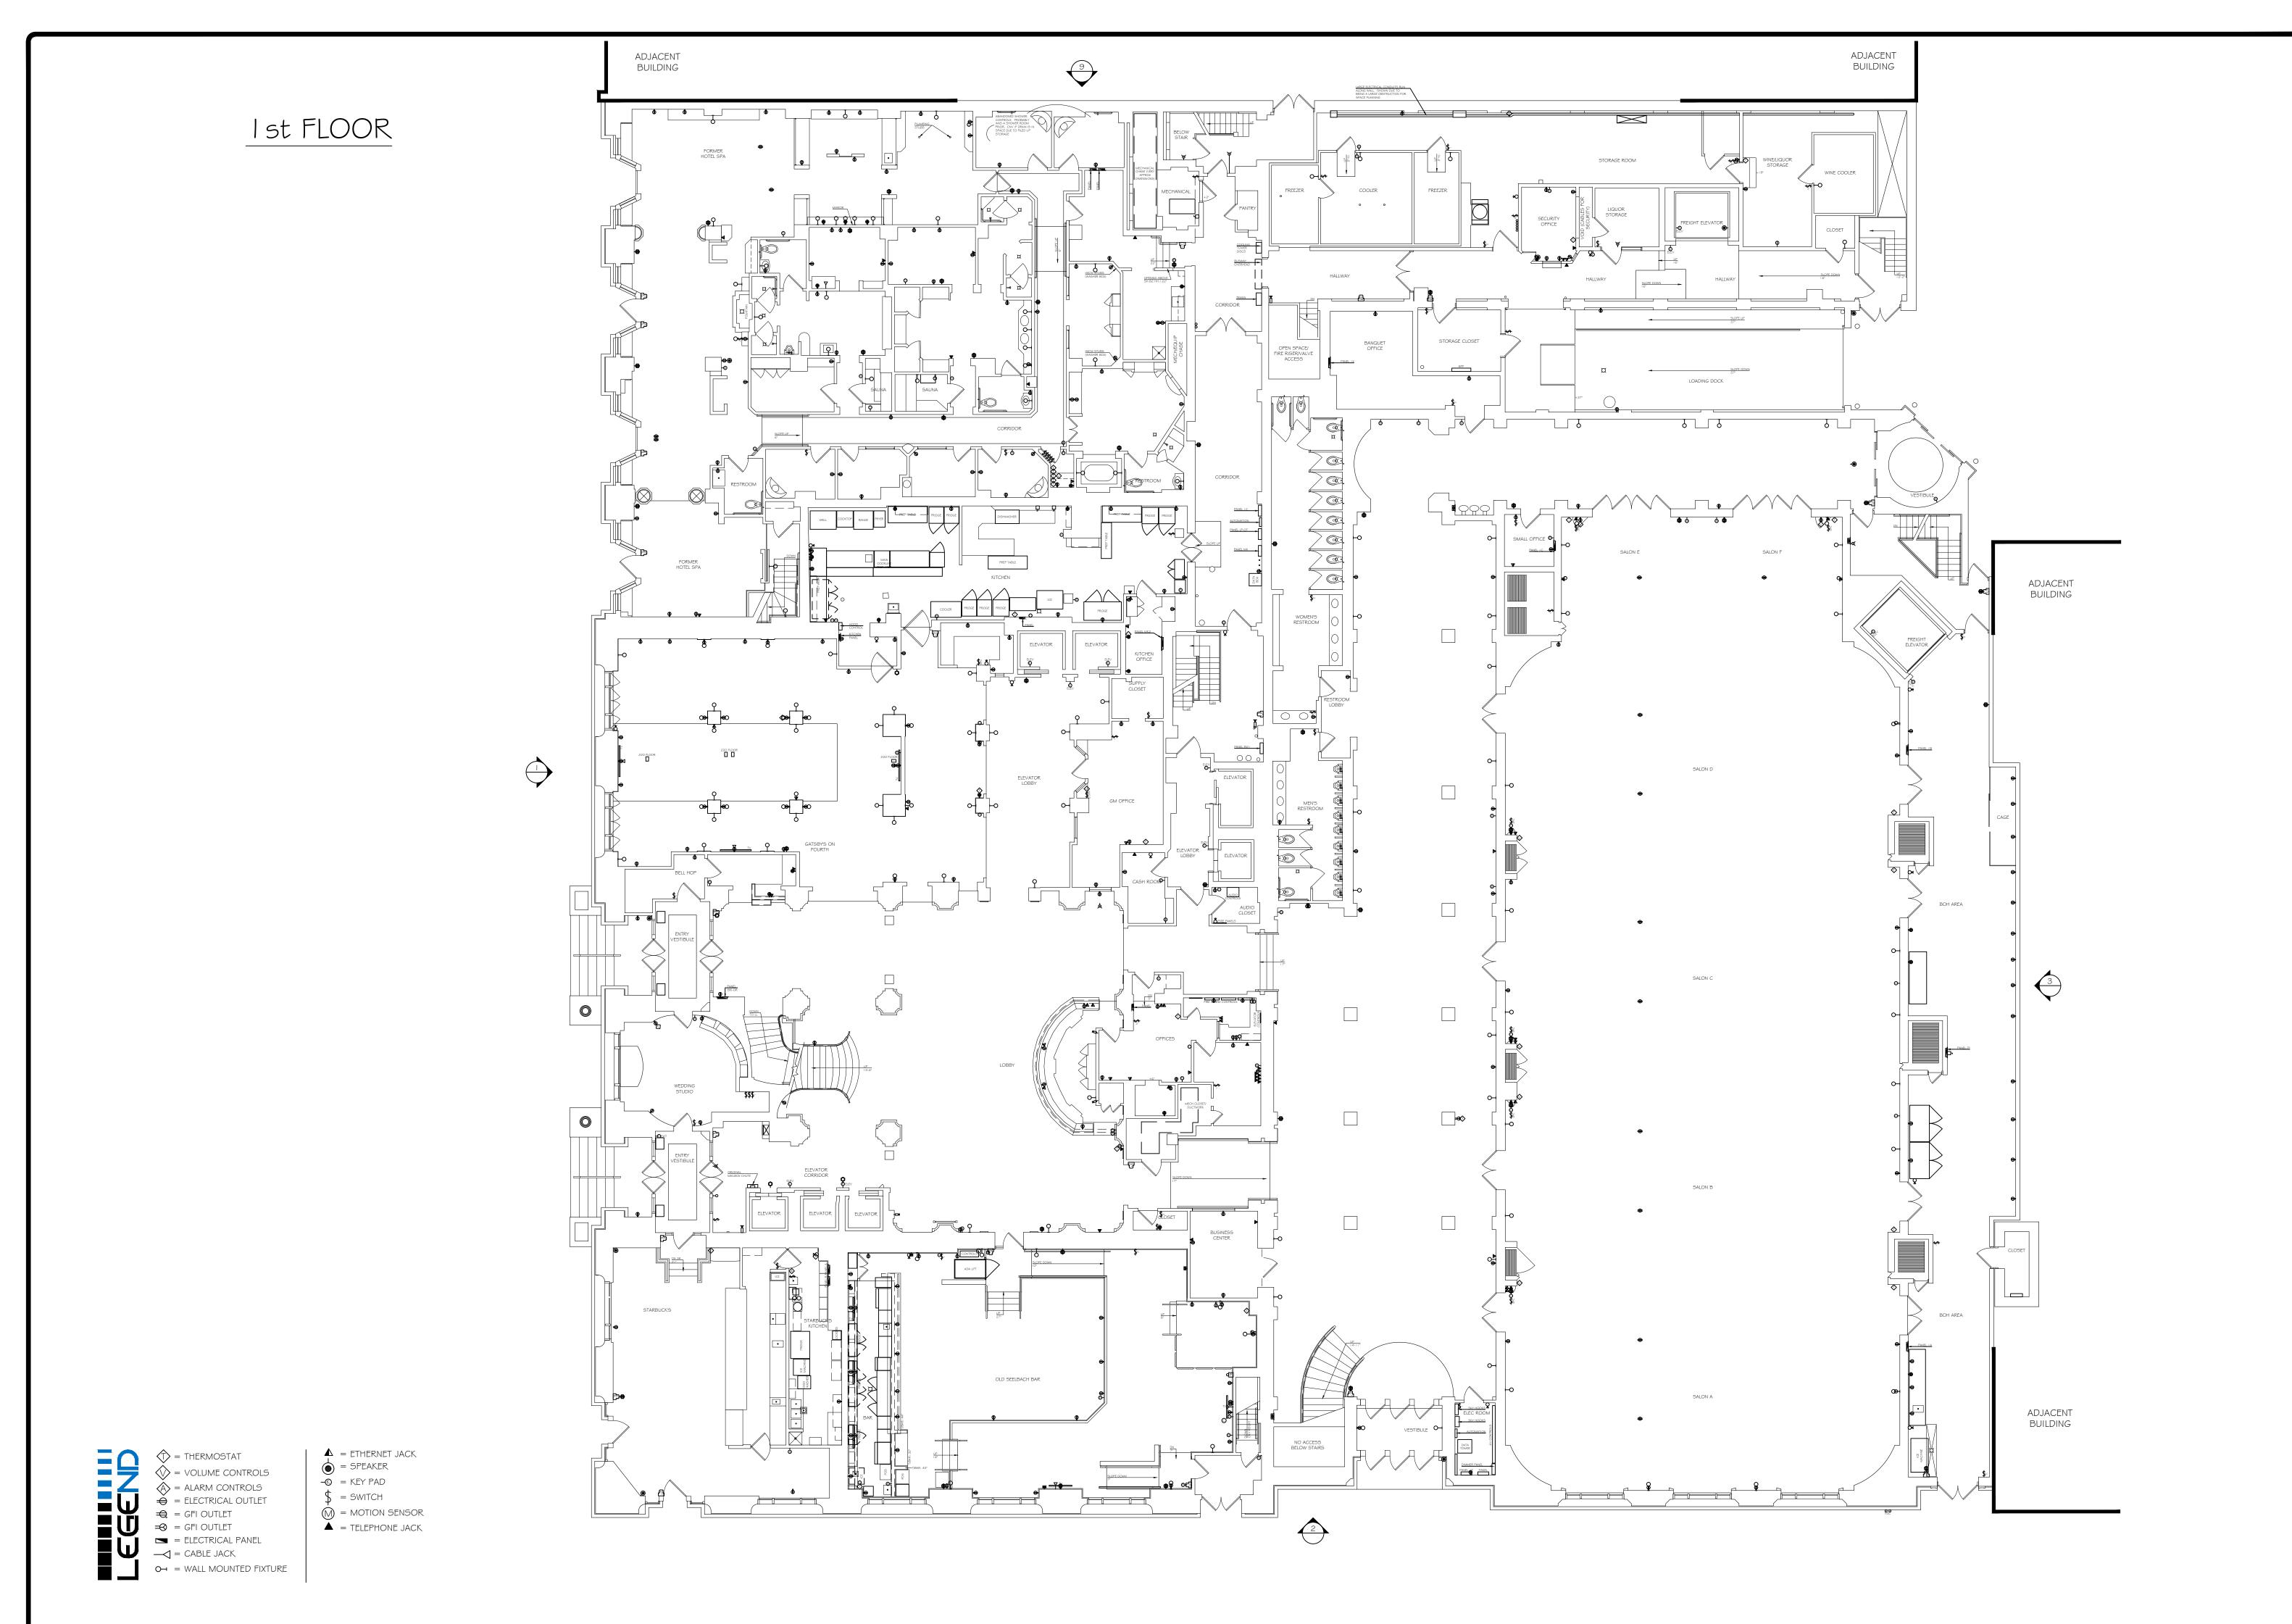

PPM

MEASUREMENTS

3626 E. PACIFIC COAST HIGHWAY | 2ND FLOOR LONG BEACH CA | 90804 T 562.621.9100 F 888.698.2966 WWW.PPMCO.NET



PREPARED FOR

ARCHITECT PLANNING

PROJECT TYPE

ELECTRICAL PLAN


PROJECT NAME

THE PPM PROJECT

PROJECT ADDRESS

I 234 CHERRY TREE BOULEVARD LONG BEACH, CA 90000

for landscaping purposes (Cal. Bus. & Prof. Code §8727). All site plans created by PPM do not involve the determination of any property line, and as such do not constitute land surveying (Cal. Bus. & Prof. Code §88726-8727). In addition, PPM services and plans do not constitute civil engineering (Cal. Bus. & Prof. Code §86702-6704), and thus should not be used for any studies or activities defined as civil engineering (Cal. Bus. & Prof. Code §6731). All floor plans created by PPM are intended to be used as a reference for design and construction and should not be considered a substitute for the services of a licensed structural engineer or licensed architect. PPM makes every reasonable effort to ensure the accuracy of the information found in our plans. However, every As-Built drawing inherently contains errors to some degree. It is the duty of the architect, contractor, designer or other licensed professional, as a consultant to the property owner, to determine the suitability of the As-Built plans prior to construction. Measurements shoule field confirmed before commencing construction. in the event that an error is found on a plan, PPMs liability is

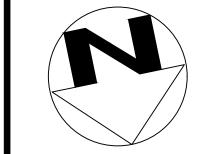

9CALE 3/₃₂" = 1'-0" PROJECT 12345


APPROVED BY

CT

DATE 07/30/18

18 of 47

BASEMENT FLOOR

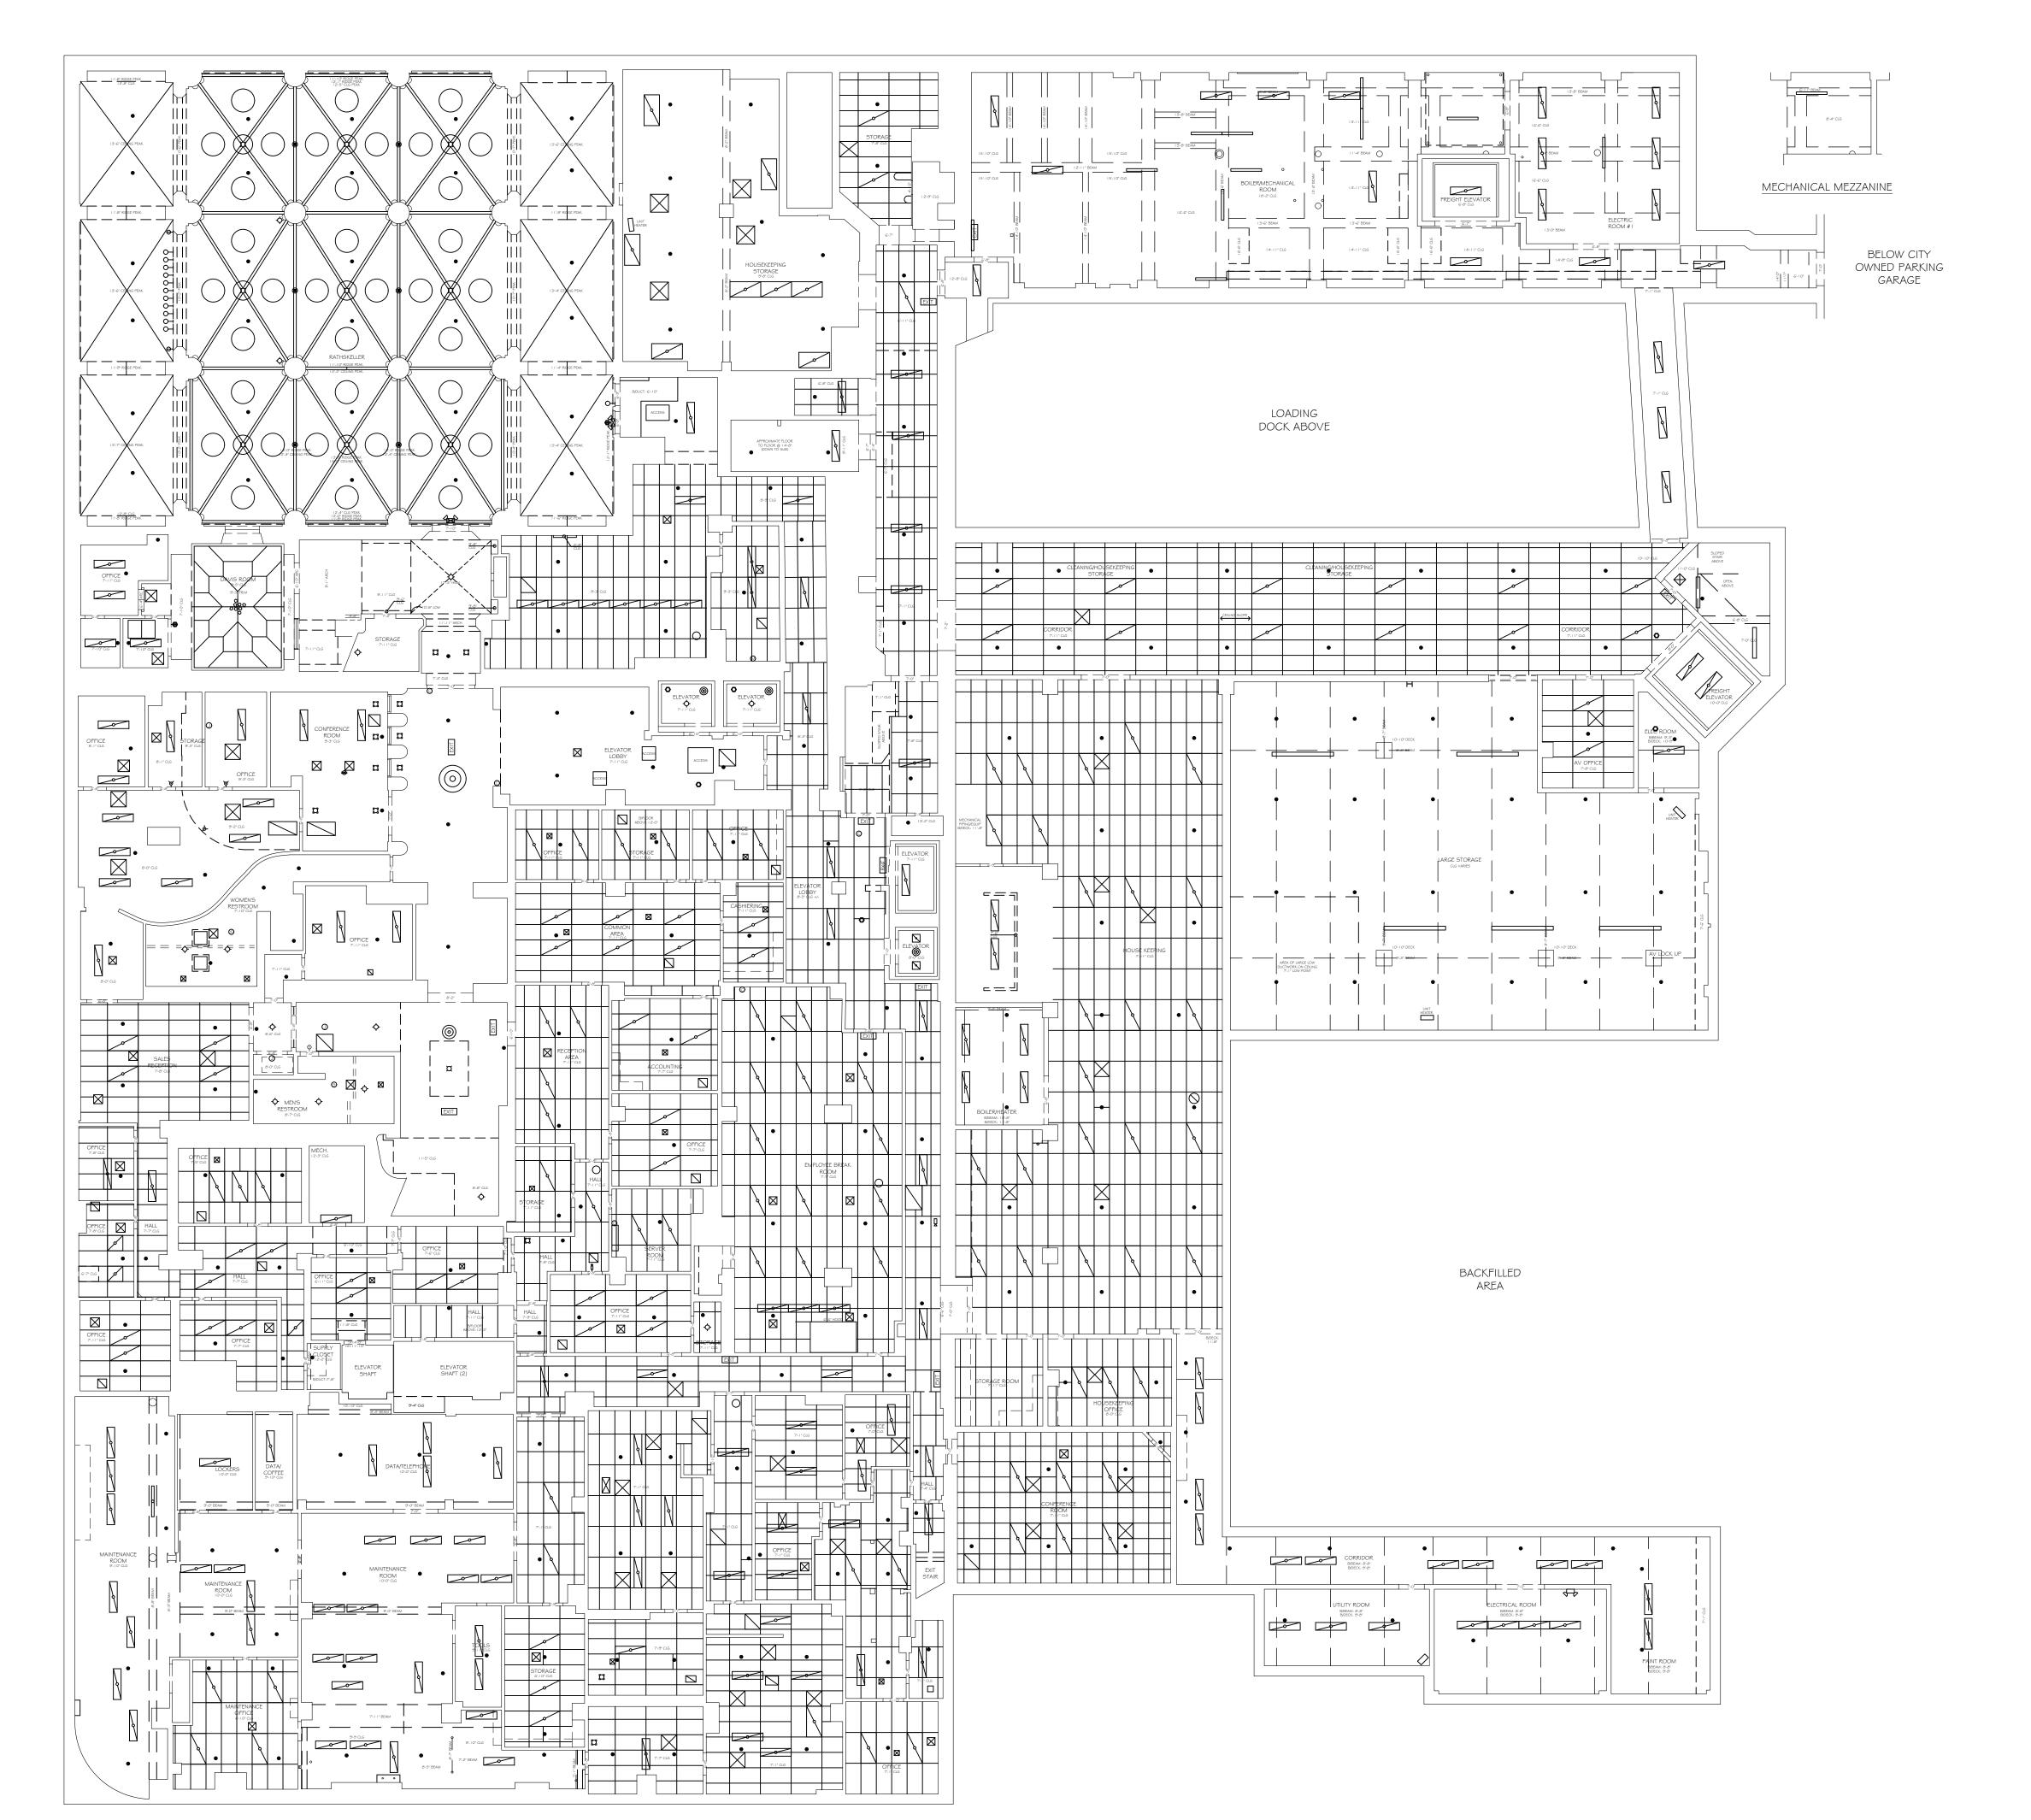



PRECISION PROPERTY MEASUREMENTS

3626 E. PACIFIC COAST HIGHWAY | 2ND FLOOR LONG BEACH CA | 90804 T 562.621.9100 F 888.698.2966 WWW.PPMCO.NET



PREPARED FOR

ARCHITECT PLANNING

PROJECT TYPE

REFLECTED CEILING PLAN

PROJECT NAME

THE PPM PROJECT

PROJECT ADDRESS

I 234 CHERRY TREE BOULEVARD LONG BEACH, CA 90000

All plans created by Precision Property
Measurement Ltd "PPM" are made exclusively
for landscaping purposes (Gal. Bus. & Prof.
Code §8727). All site plans created by PPM do not
involve the determination of any property line, and as
such do not constitute land surveying
(Cal. Bus. & Prof. Code §§6726-8727). In
addition, PPM services and plans do not constitute
civil engineering (Cal. Bus. & Prof. Code §§6772-6704),
and thus should not be used for any studies or activities
defined as civil engineering (Cal. Bus. & Prof. Code
§6731). All floor plans created by PPM are intended to
be used as a reference for design and construction and
should not be considered a substitute for the services of
a licensed structural engineer or licensed architect. PPM
makes every reasonable effort to ensure the accuracy of
the information found in our plans. However, every
As-Built drawing inherently contains errors to some
degree. It is the duty of the architect, contractor,
designer or other licensed professional, as a consultant
to the property owner, to determine the suitability of the
As-Built plans prior to construction. Measurements should
be field confirmed before commencing construction. in th
event that an error is found on a plan, PPMs liability is
limited to the amount of the fee paid to PPM.



SCALE $\frac{3}{32}$ " = 1'-0"

PROJECT
1 2 3 4 5

I 2345
APPROVED BY
CT

date 07/30/18

32 of 47

= CABLE JACK

= CEILING FAN

OH = WALL MOUNTED FIXTURE

OH = CEILING-MOUNTED FIXTURE

OH = RECESSED FIXTURE

OH = WALL MOUNTED FIXTURE


OH = CABLE JACK

HANGING FIXTURE

OH = FLUORESCENT LIGHT

= CEILING ELECTRICAL OUTLET

SMOKE DETECTORCO2 DETECTOR

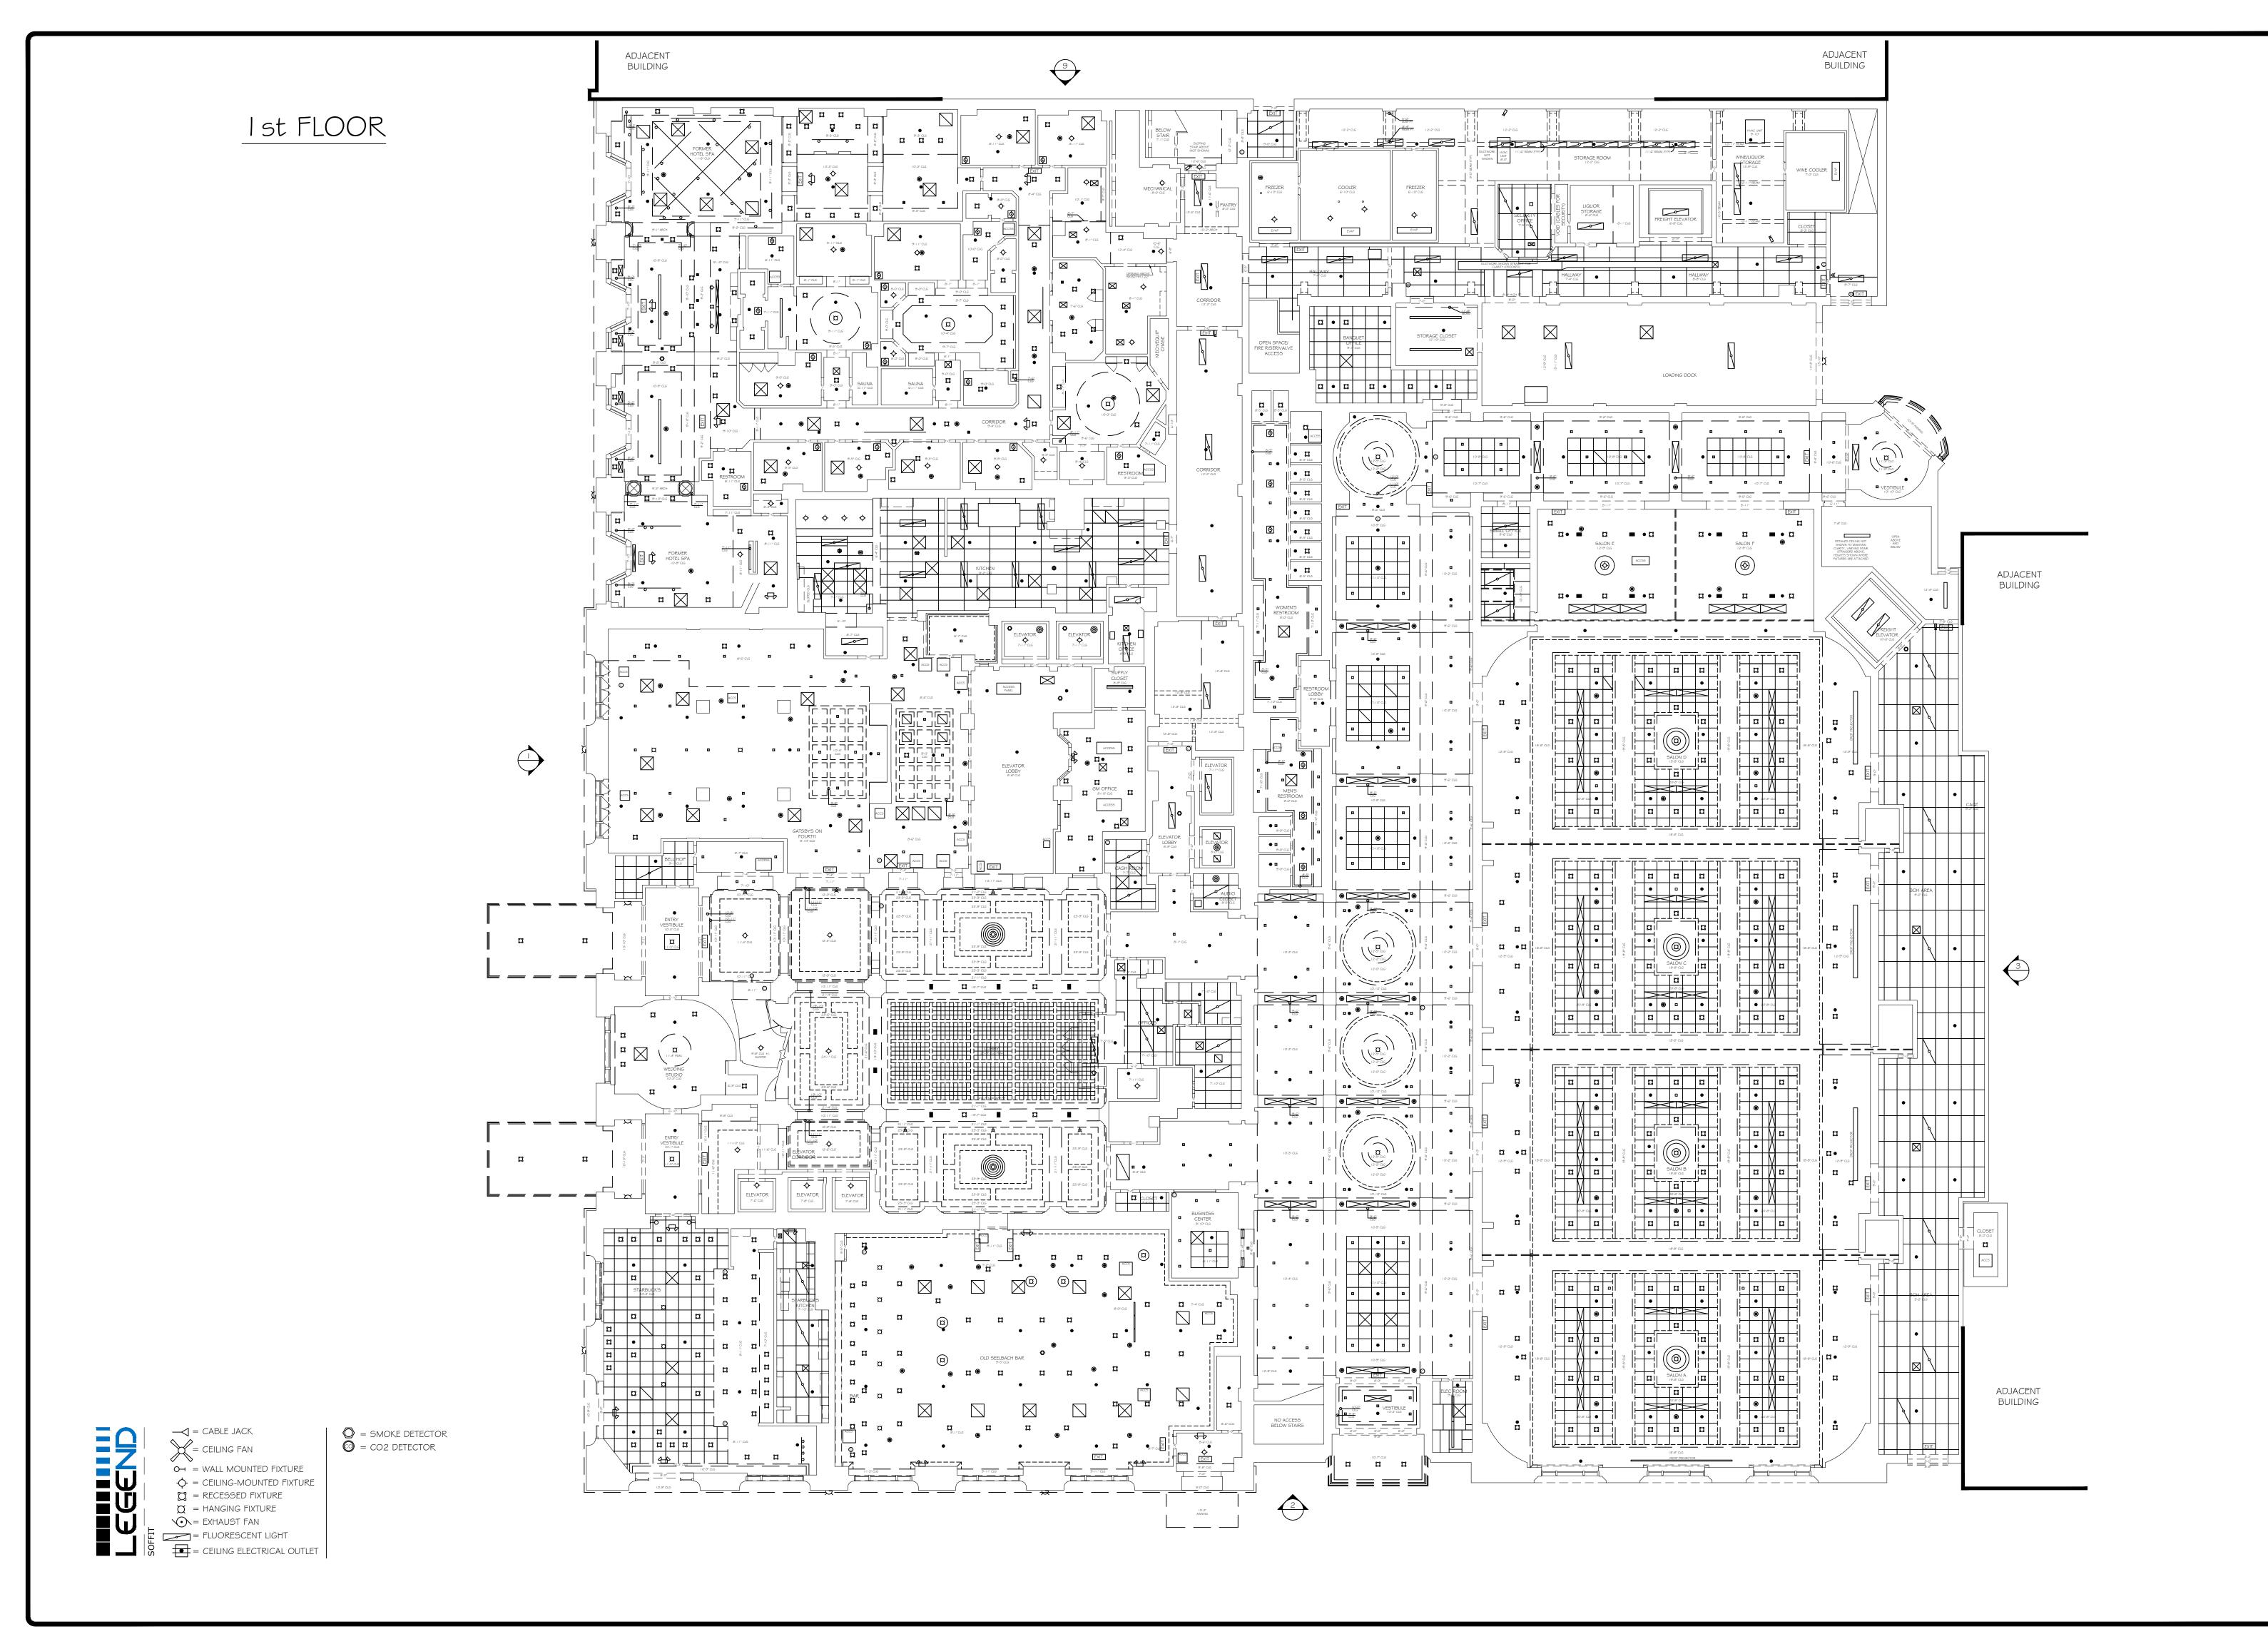



MEASUREMENTS

3626 E. PACIFIC COAST HIGHWAY | 2ND FLOOR LONG BEACH CA | 90804 T 562.621.9100 F 888.698.2966 WWW.PPMCO.NET



PREPARED FOR

ARCHITECT PLANNING

PROJECT TYPE

REFLECTED CEILING PLAN


PROJECT NAME

THE PPM PROJECT

PROJECT ADDRESS

I 234 CHERRY TREE BOULEVARD LONG BEACH, CA 90000

All plans created by Precision Property
Measurement Lid "PPM" are made exclusively
for landscaping purposes (Cal. Bus. \$ Prof.
Code §8727). All site plans created by PPM do not
involve the determination of any property line, and as
such do not constitute land surveying
(Cal. Bus. \$ Prof. Code §§8726-8727). In
addition, PPM services and plans do not constitute
civil engineening (Cal. Bus. \$ Prof. Code §§6730-6704
and thus should not be used for any studies or activitie
defined as civil engineening (Cal. Bus. \$ Prof. Code
§6731). All floor plans created by PPM are intended to
be used as a reference for design and construction and
should not be considered a substitute for the services a
licensed structural engineer or licensed architect. PPM
makes every reasonable effort to ensure the accuracy of
the information found in our plans. However, every
As-Built drawing inherently contains errors to some
degree. It is the duty of the architect, contractor,
designer or other licensed professional, as a consultant
to the property owner, to determine the suitability of
the Built plans prior to construction. Measurements shou
we field confirmed before commencing construction. In

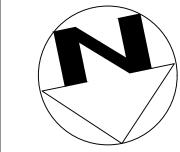

SCALE

3/32" = 1'-0"

PROJECT

1 2345

I 2345

APPROVED BY

CT

DATE

07/30/18 Sheet


33of 47







ELEVATION 3

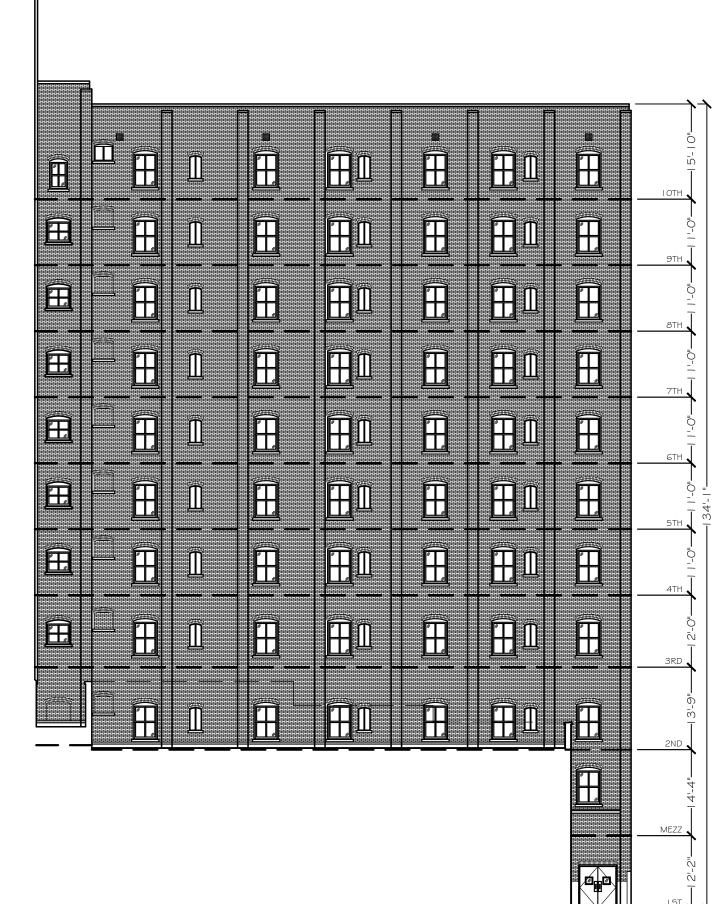

ELEVATION 4

PRECISION PROPERTY

PRECISION PROPERTY MEASUREMENTS

3626 E. PACIFIC COAST HIGHWAY | 2ND FLOOR LONG BEACH CA | 90804 T 562.621.9100 F 888.698.2966 WWW.PPMCO.NET



PREPARED FOR

ARCHITECT PLANNING

PROJECT TYPE

EXTERIOR ELEVATIONS

PROJECT NAME

THE PPM PROJECT

PROJECT ADDRESS

I 234 CHERRY TREE BOULEVARD LONG BEACH, CA 90000

All plans created by Precision Property
Measurement Ltd "PPM" are made exclusively
for landscaping purposes (Cal. Bus. 4 Prof.
Code §8727). All site plans created by PPM do not
involve the determination of any property line, and as
such do not constitute land surveying
(Cal. Bus. 4 Prof. Code §8726-8727). In
addition, PPM services and plans do not constitutive
lengineering (Cal. Bus. 4 Prof. Code §86702-670.
In addition, PPM services and plans do not constitutive
lengineering (Cal. Bus. 4 Prof. Code §86702-670.
In addition, PPM services and plans do not constitutive
lengineering (Cal. Bus. 4 Prof. Code §86702-670.
In addition, PPM services and plans of not constitutive
lengineering (Cal. Bus. 4 Prof. Code
§86702 for any studies or activitive
lenging as reference for design and construction and
rould not be considered a substitute for the services
licensed structural engineer or licensed architect. Pr
lakes every reasonable effort to ensure the accuracy
the information found in our plans. However, every
As-Bull drawing inherently contains errors to some
degree. It is the duty of the architect, contractor,
besigner or other licensed professional, as a consultato the property owner, to determine the suitability of to
-Bullt plans prior to construction. Measurements sho
field confirmed before commencing construction. In

SCALE

16" = 1'-0"

PROJECT

12345

APPROVED BY

CT

DATE

07/30/18

46 of 47