



PREPARED FOR

CLIENT

PROJECT TYPE

EXTERIOR ELEVATIONS

PROJECT NAME

LARGE SFR SAMPLE

PROJECT ADDRESS

1234 PRECISION BOULEVARD
CITY, CA 00000

All plans created by Precision Property Measurements, LLC ("PPM") are made exclusively for landscaping purposes. CA, Title, & Prof. Code 86727. All data plans created by PPM do not make the determination of any property line, and as such do not constitute a survey. CA, Title, & Prof. Code 86727. In addition, PPM services are not intended to constitute an engineering CA, Title, & Prof. Code 86702.4704, and this would not be used for any studies or activities defined as an engineering CA, Title, & Prof. Code 86727. All floor plans created by PPM are intended to be used as a reference for general construction and should not be considered a substitute for the services of a licensed structural engineer or licensed architect. PPM makes every reasonable effort to ensure the accuracy of the information located on these drawings, but does not warrant, represent, or certify that the information is correct in all respects. It is the duty of the architect, contractor, designer or other licensed professional, as a consultant to the property owner, to determine the suitability of the As-Built plans prior to construction. Measurements should be field confirmed before commencing construction, or the extent that an error is based on a plan, PPM's liability is limited to the amount of the fee paid to PPM.

SCALE

1/4" = 1'-0"

PROJECT

XXXX_XX

APPROVED BY


XX

DATE

XX/XX/XX

SHEET

23 of 25

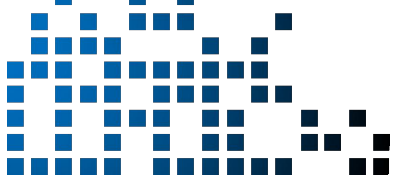

NORTH



EAST



PREPARED FOR

CLIENT

PROJECT TYPE

EXTERIOR ELEVATIONS

PROJECT NAME

LARGE SFR SAMPLE

PROJECT ADDRESS

1234 PRECISION BOULEVARD
 CITY, CA 00000

All plans created by Precision Property Measurements, LLC ("PPM") are made exclusively for landscaping purposes (i.e., this is not a Professional Engineer or Architectural drawing). PPM does not make the determination of any property line, and as such, does not create a legal boundary. (See Civil Code §817.2(a)(2)-(3), in addition, PPM services are not intended to constitute an engineering (i.e., this is not a Professional Engineer or Architectural drawing) or a survey (i.e., this is not a Professional Engineer or Architectural drawing). All floor plans created by PPM are intended to be used as a reference for design and construction and should not be considered a substitute for the services of a licensed structural engineer or licensed architect. PPM makes every reasonable effort to ensure the accuracy of its data and drawings, but does not warrant, represent, or certify that its data or drawings are error-free. PPM is not responsible for any errors or omissions in the drawings or for any consequences that may result from the use of the drawings. PPM's liability is limited to the amount of the fee paid to PPM.

SCALE
 1/4" = 1'-0"

PROJECT
 XXXX_XX

APPROVED BY
 XX

DATE
 XXXX/XX

SHEET

24 of 25



SOUTH



WEST

LEGEND

FINISHED GRADE LINE

FINISHED FLOOR LINE

12
4.5
X
ROOF PITCH LABEL (RISE/RUN)

PPM

PRECISION PROPERTY MEASUREMENTS


3626 E. PACIFIC COAST
HIGHWAY | 2ND FLOOR
LONG BEACH CA | 90804
T 562.621.9100
F 888.698.2966
WWW.PPMCO.NET

WORRY FREE RENOVATIONS


PREPARED FOR

CLIENT

POOL HOUSE

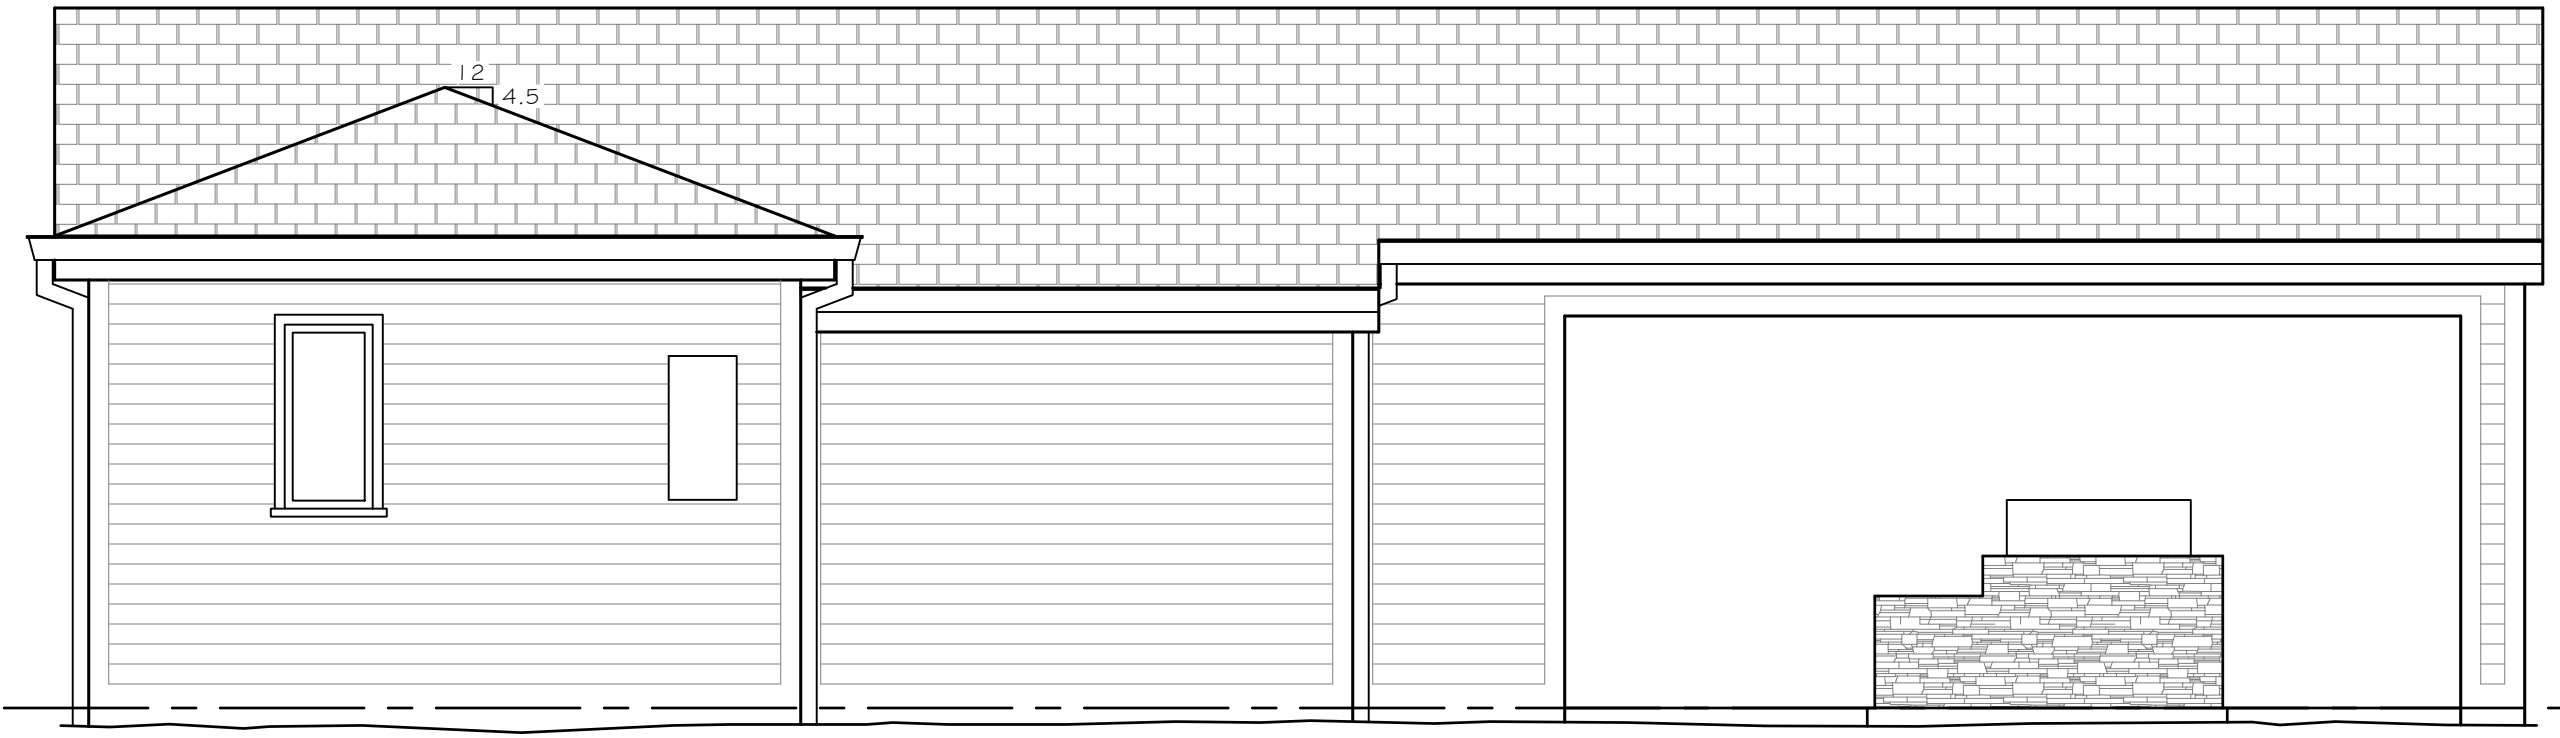


NORTH

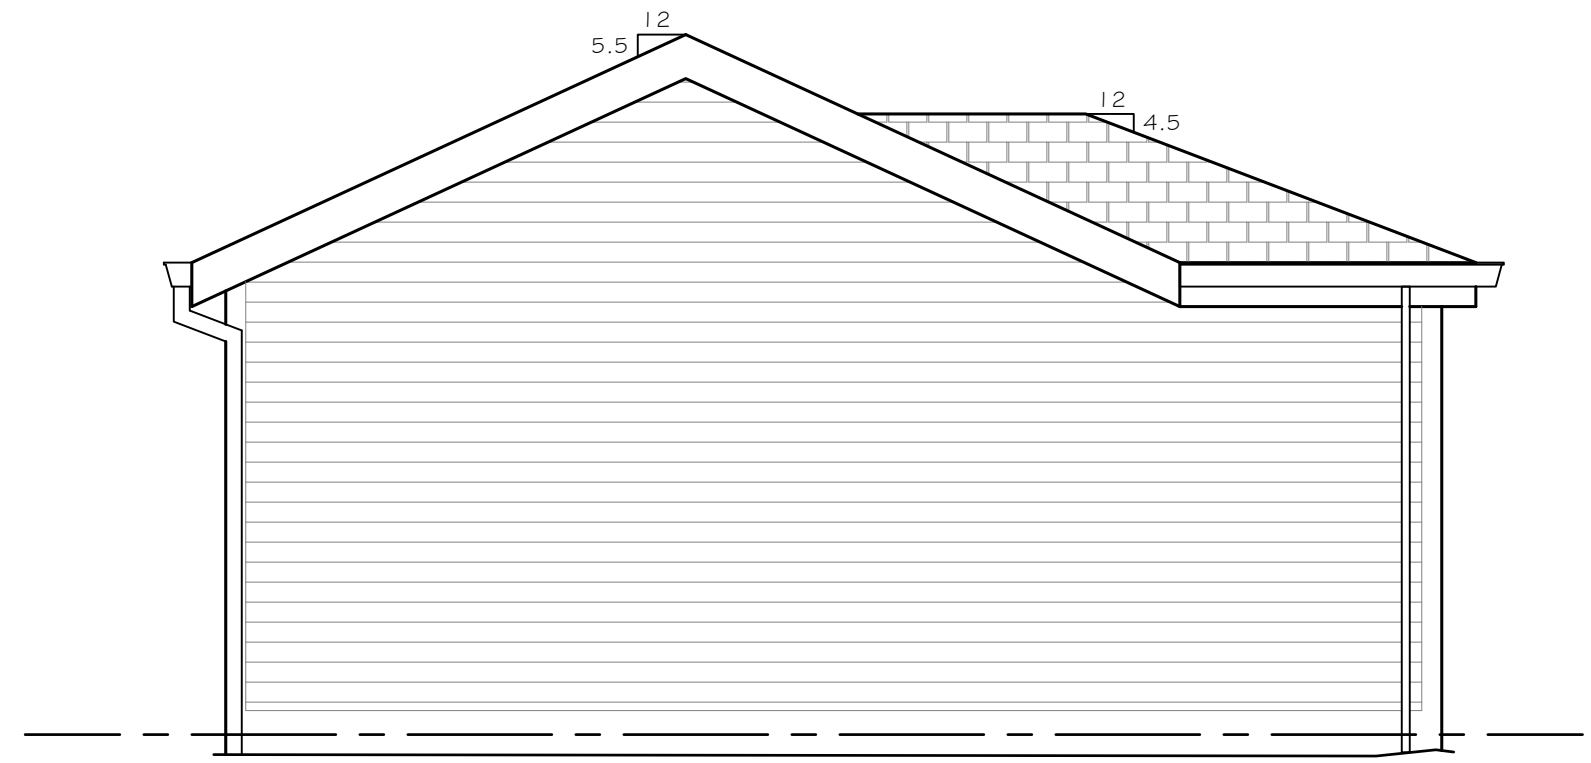

EAST



SOUTH

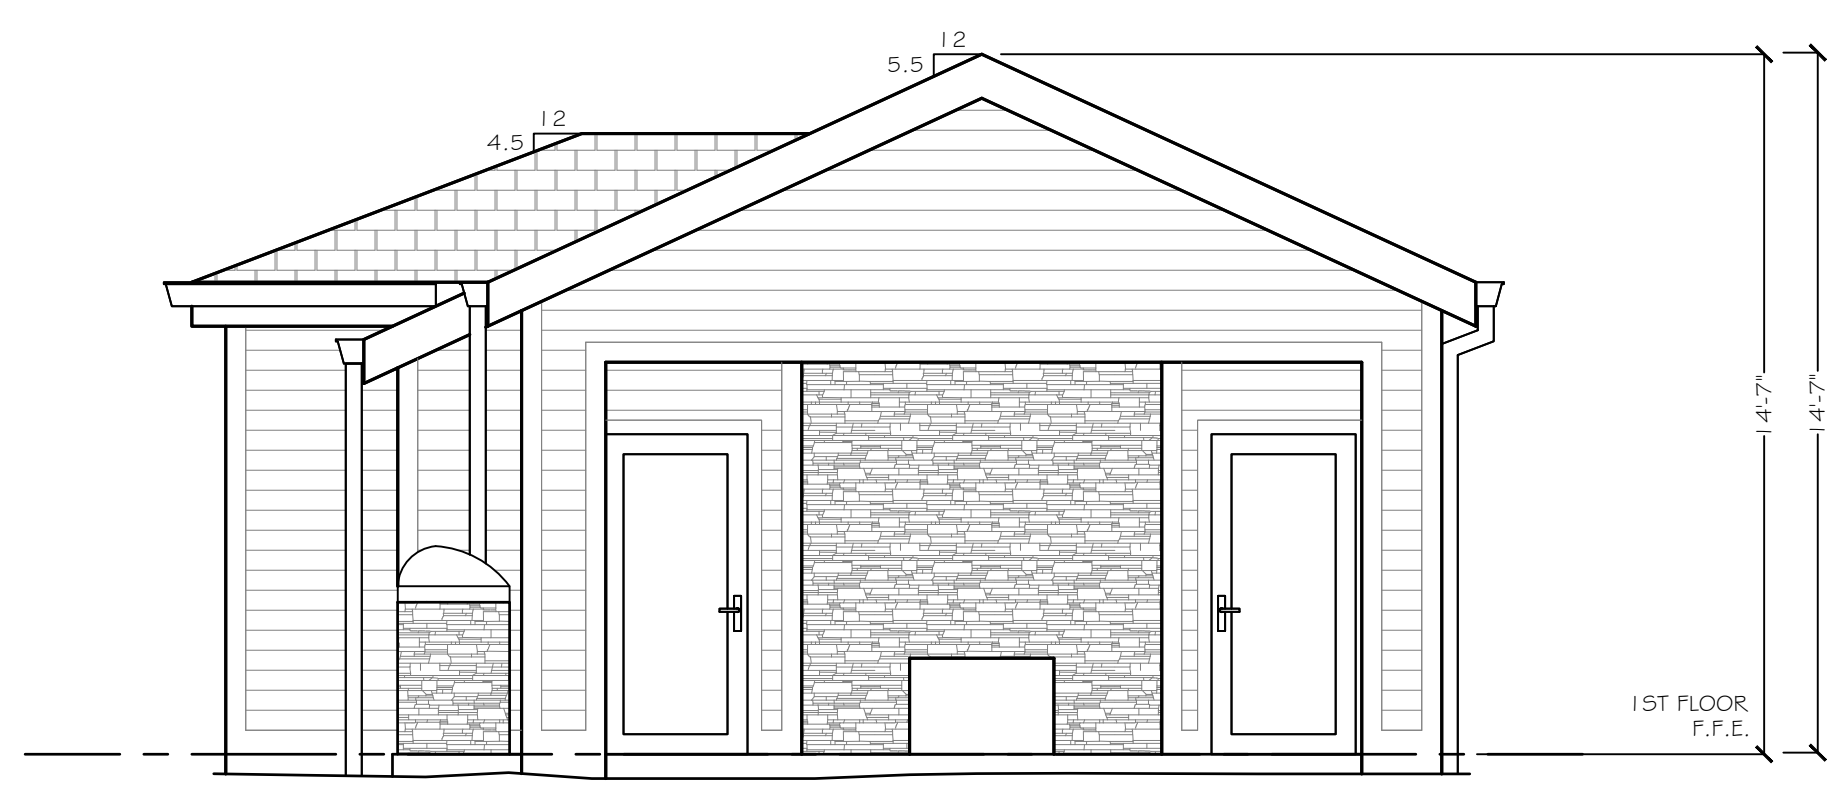

WEST

PROJECT TYPE

EXTERIOR ELEVATIONS

PROJECT NAME

LARGE SFR SAMPLE

PROJECT ADDRESS

1234 PRECISION
BOULEVARD
CITY, CA 00000

All plans created by Precision Property Measurements, LLC (PPM) are made exclusively for landscaping purposes (i.e., this is not a Pool Code (SC72)). All site plans created by PPM do not include the determination of any property line, and as such do not constitute legal documents. (i.e., this is not a Pool Code (SC72) or SC73). In addition, PPM services and plans do not constitute an engineering (i.e., this is not a Pool Code (SC70) or SC71). All floor plans created by PPM are intended to be used as a reference for conceptual construction and should not be considered a substitute for the services of a licensed structural engineer or licensed architect. PPM makes every reasonable effort to ensure the accuracy of the information located on our plans. However, none of our drawings represent a warranty or any other degree. It is the duty of the architect, contractor, designer or other licensed professional, as a consultant to the property owner, to determine the suitability of the As-Built plans prior to construction. Measurements should be field confirmed before commencing construction, in the event that an error is found on a plan, PPM's liability is limited to the amount of the fee paid to PPM.

SCALE
1/4" = 1'-0"

PROJECT
XXXX_XX

APPROVED BY
XX

DATE
XX/XX/XX

SHEET

25 of 25

