




1 GAMEROOM 2 GAME ROOM 3 GAME ROOM 4 GAME ROOM

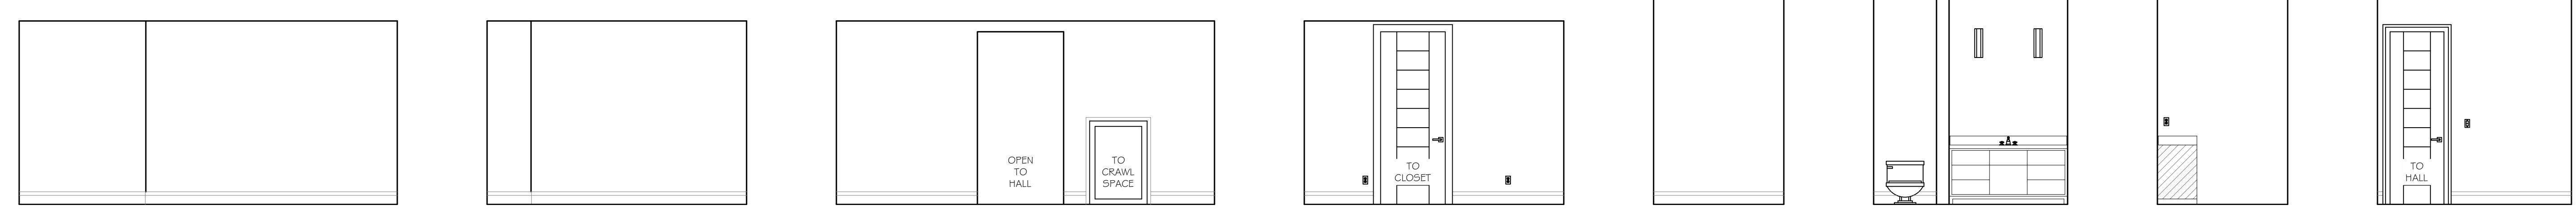


5 STORAGE 6 STORAGE 7 STORAGE 8 STORAGE 9 BATHROOM 10 BATHROOM 11 BATHROOM 12 BATHROOM

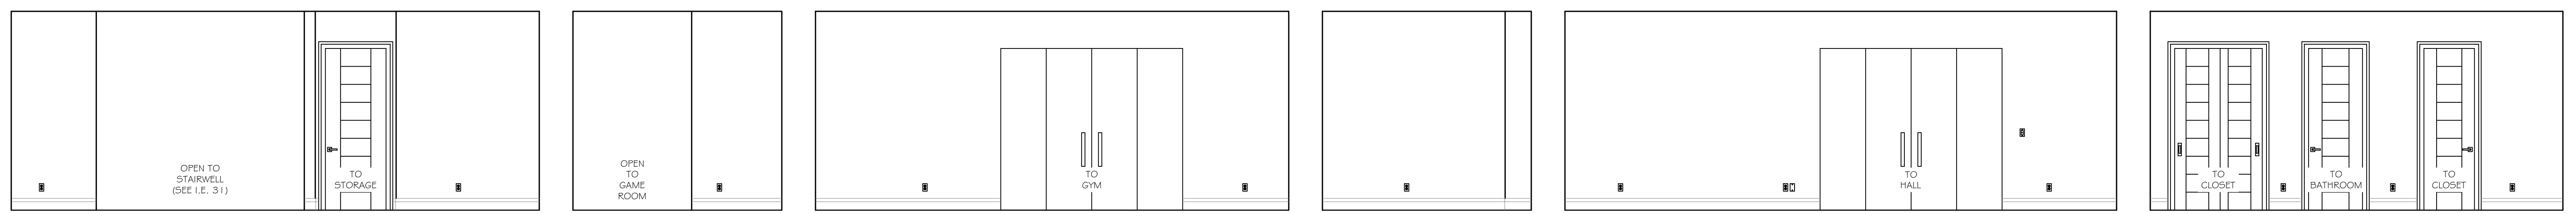


13 HALL 14 HALL 15 HALL 16 HALL 17 GYM 18 GYM

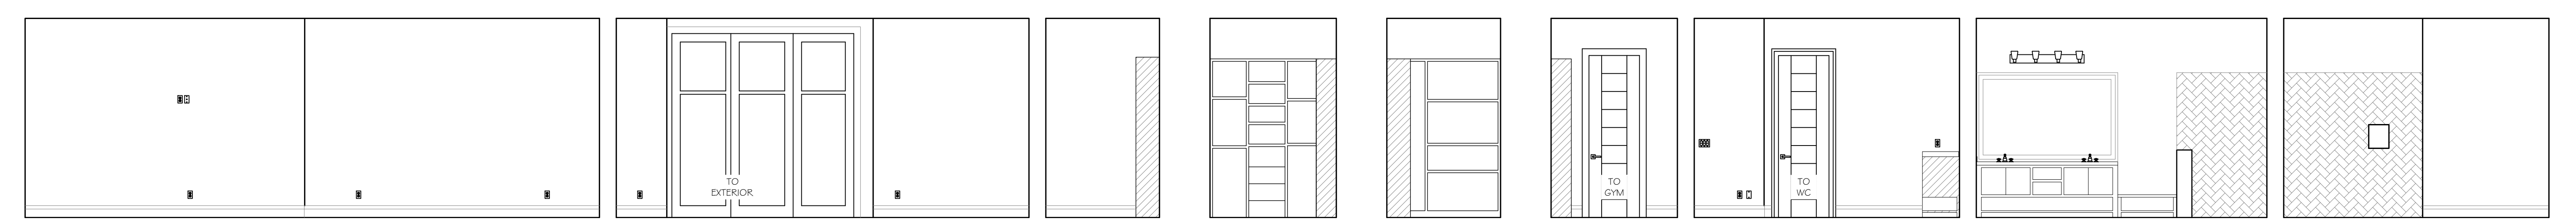

19 GYM 20 GYM 21 CLOSET 22 CLOSET 23 CLOSET 24 CLOSET 25 BATHROOM 26 BATHROOM 27 BATHROOM

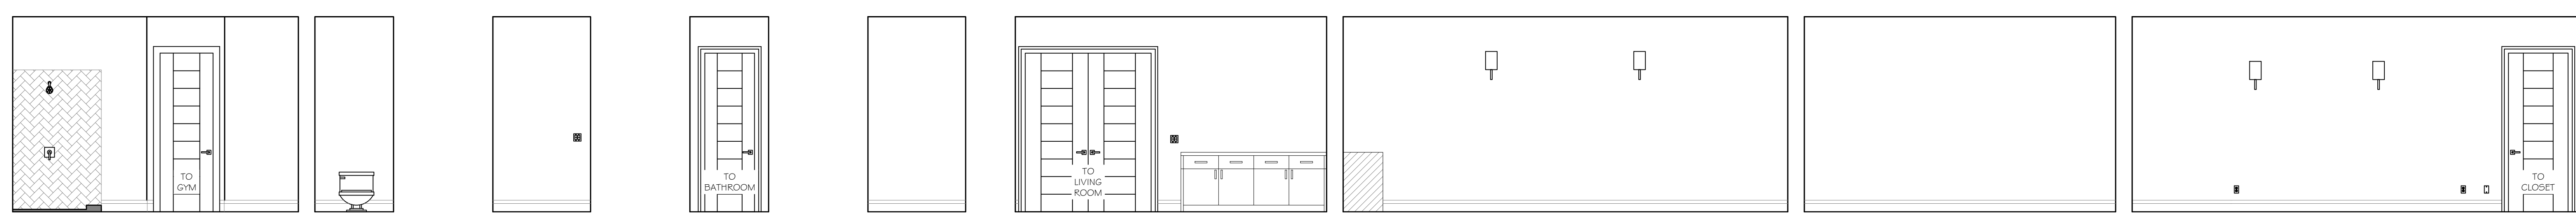

28 BATHROOM 29 WC 30 WC 31 WC 32 WC 33 THEATRE 34 THEATRE 35 THEATRE 36 THEATRE

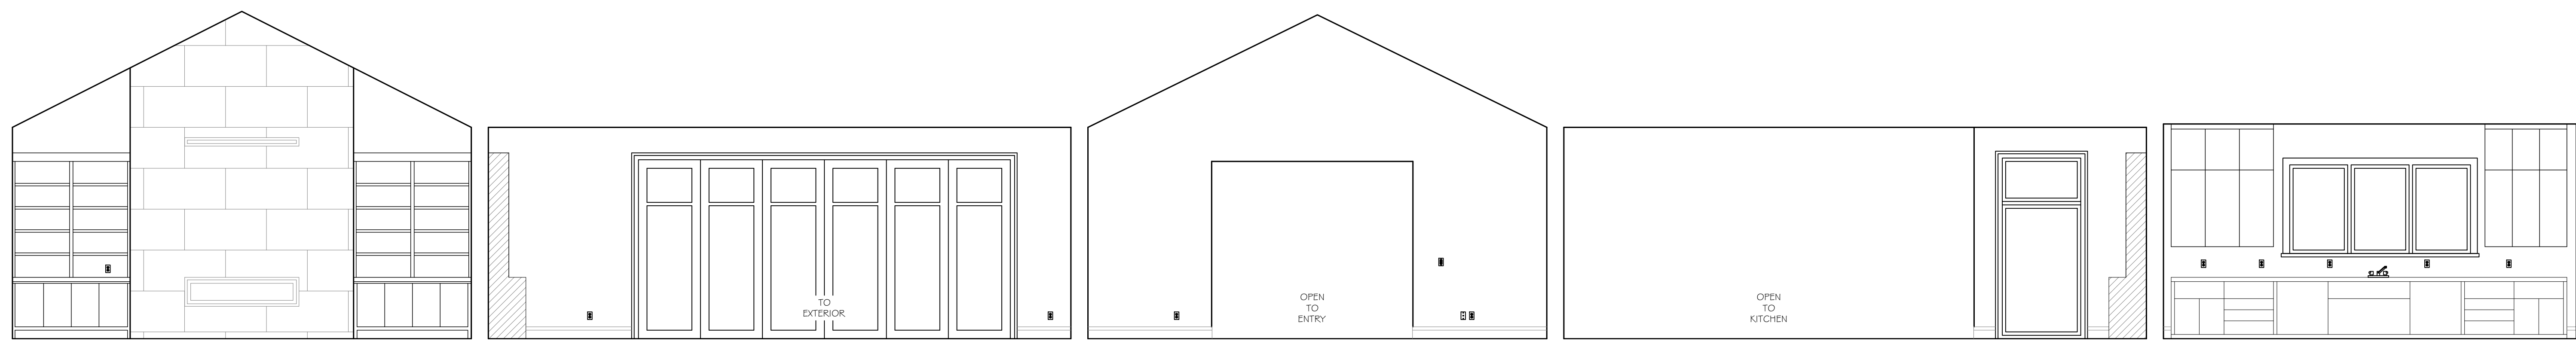


37 FAMILY ROOM

38 FAMILY ROOM

39 FAMILY ROOM

40 FAMILY ROOM

41 KITCHEN

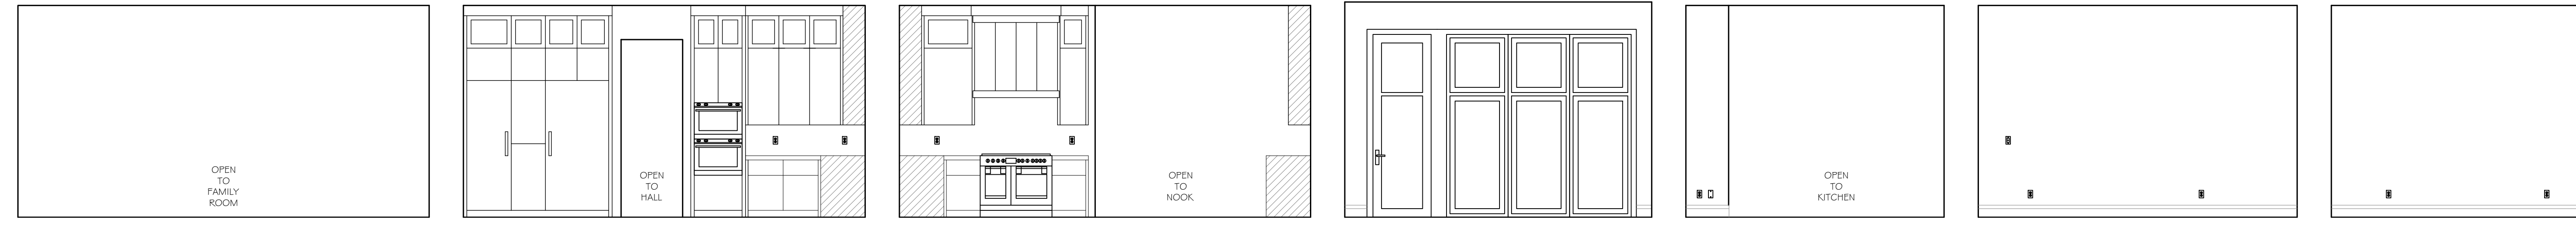

42 KITCHEN

43 KITCHEN


44 KITCHEN

45 NOOK


46 NOOK

47 NOOK


48 NOOK

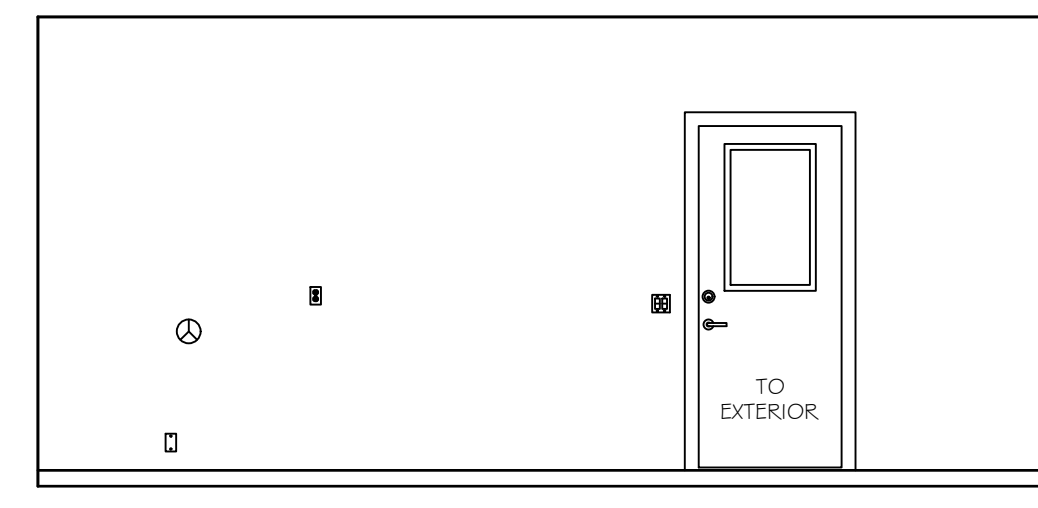


49 GARAGE

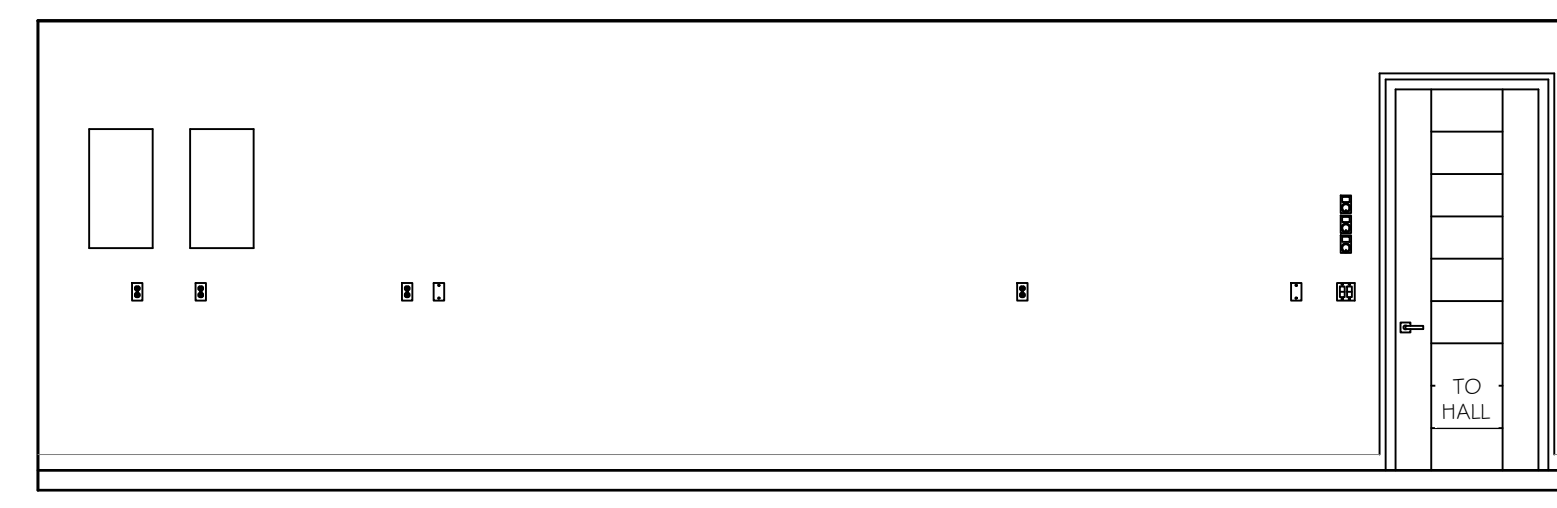


50 GARAGE

 


51 GARAGE

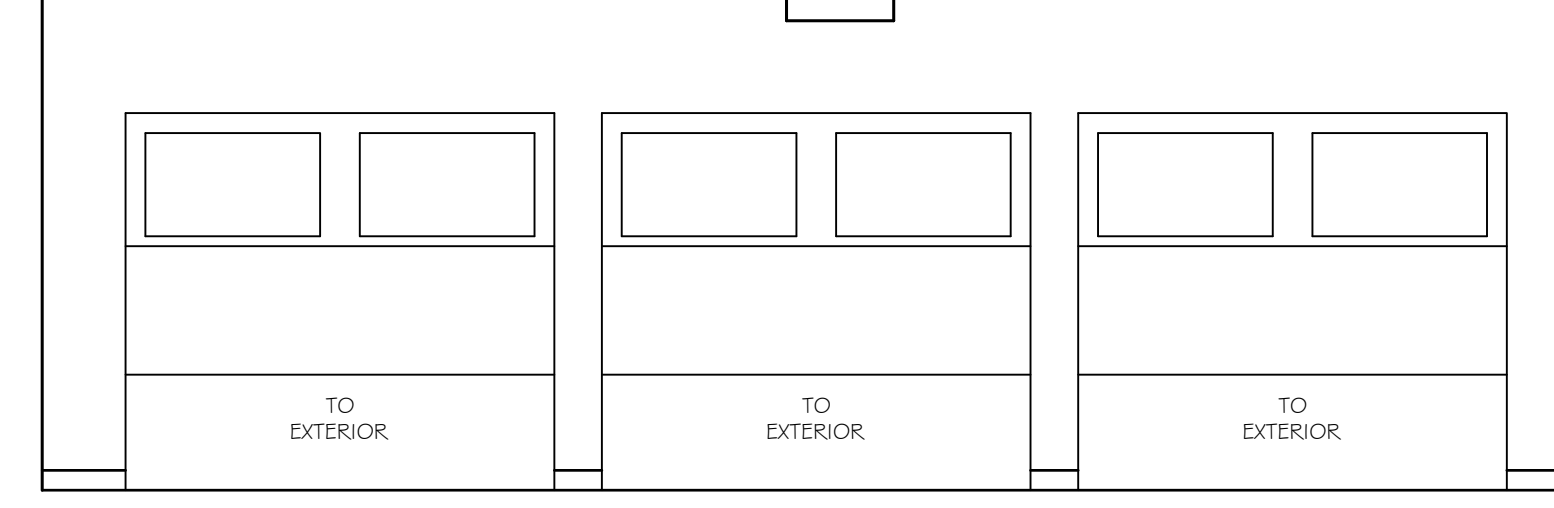


52 GARAGE

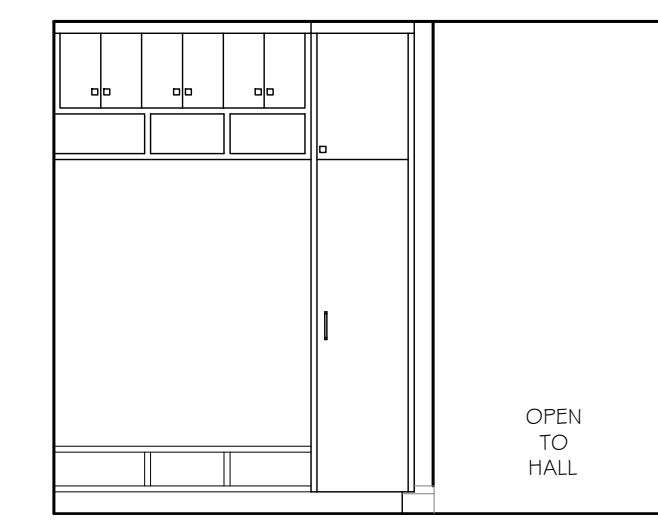


53 MUDROOM

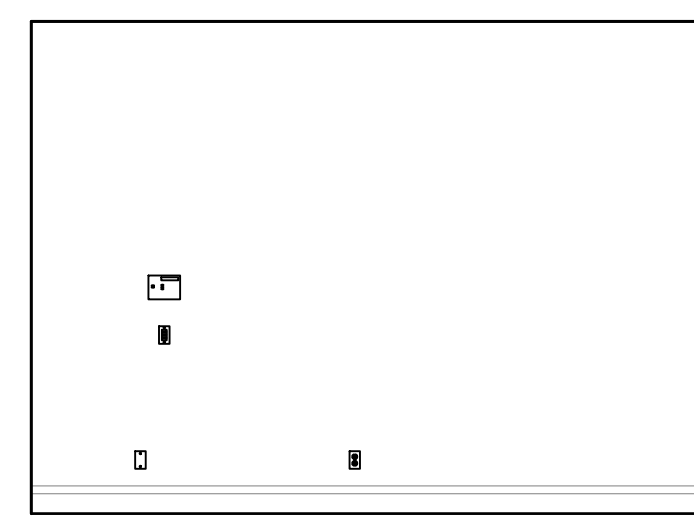


54 MUDROOM

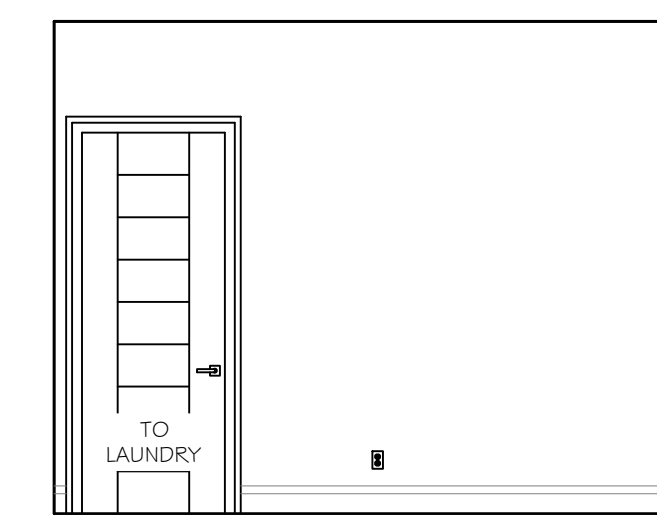


55 MUDROOM

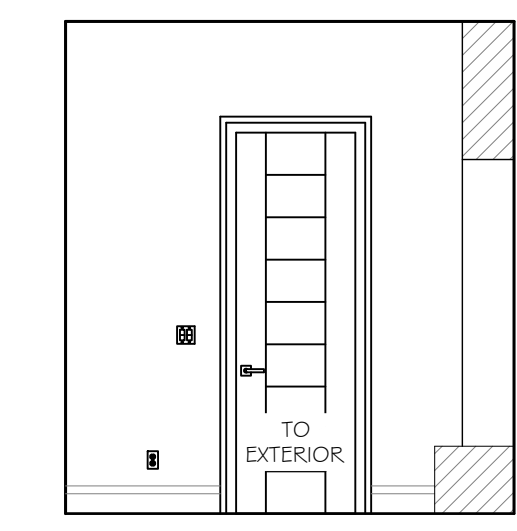


56 MUDROOM

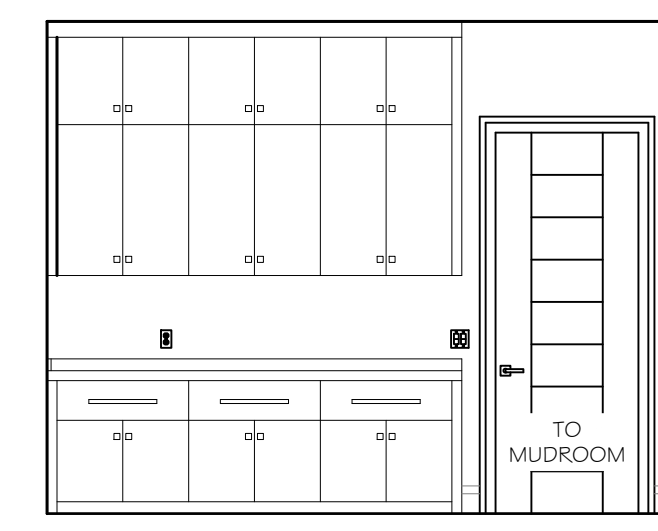


57 LAUNDRY

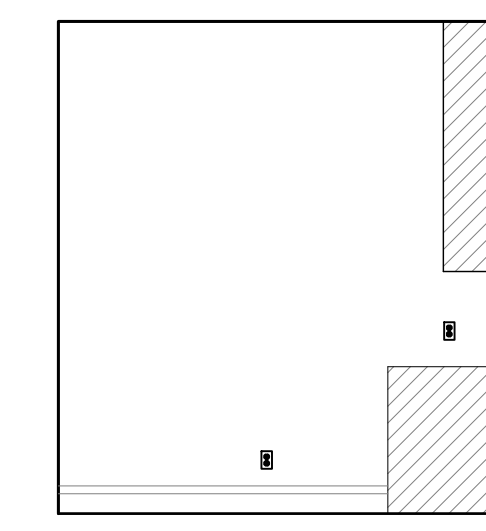


58 LAUNDRY

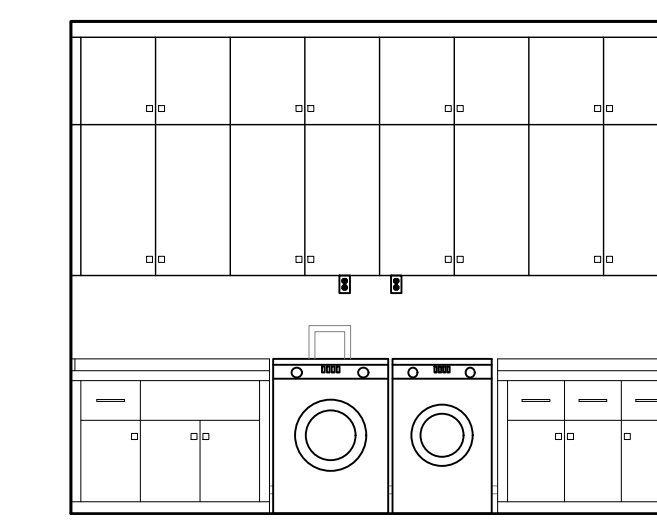


59 LAUNDRY

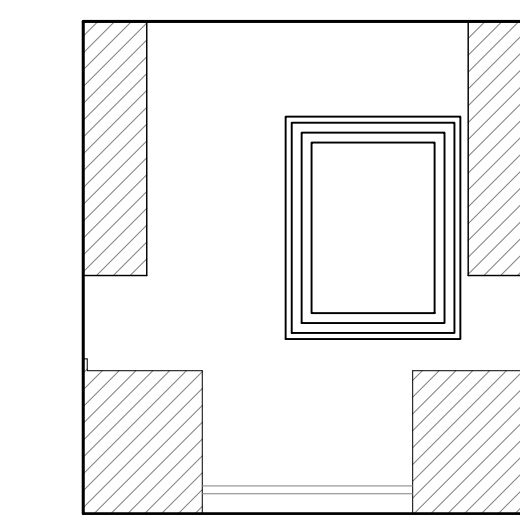


60 LAUNDRY

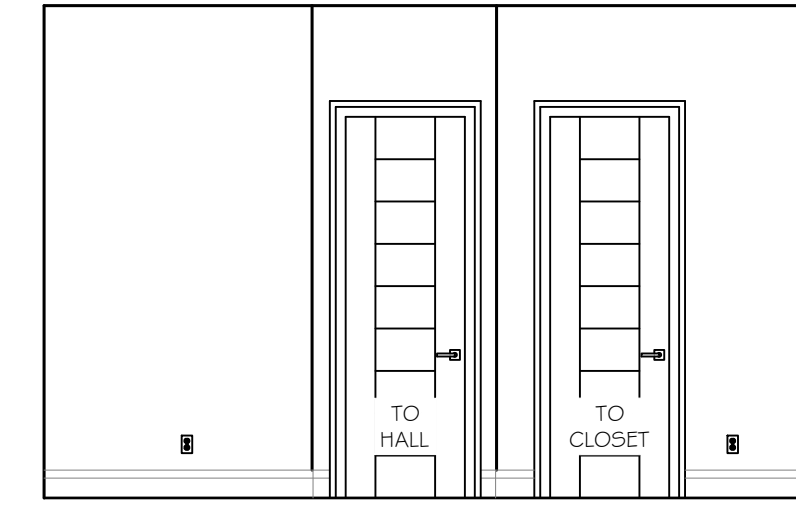


61 GUEST SUITE

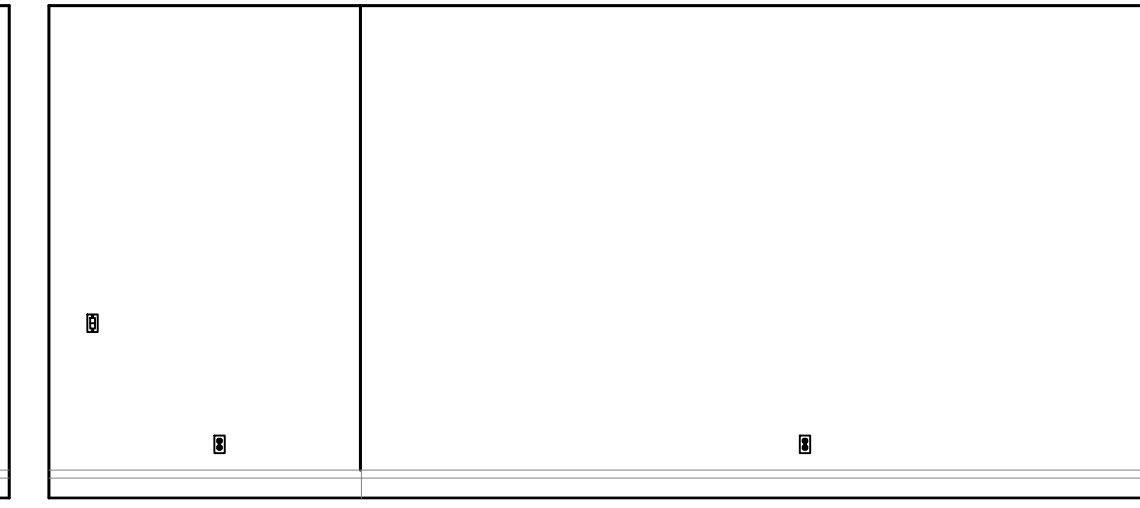


62 GUEST SUITE

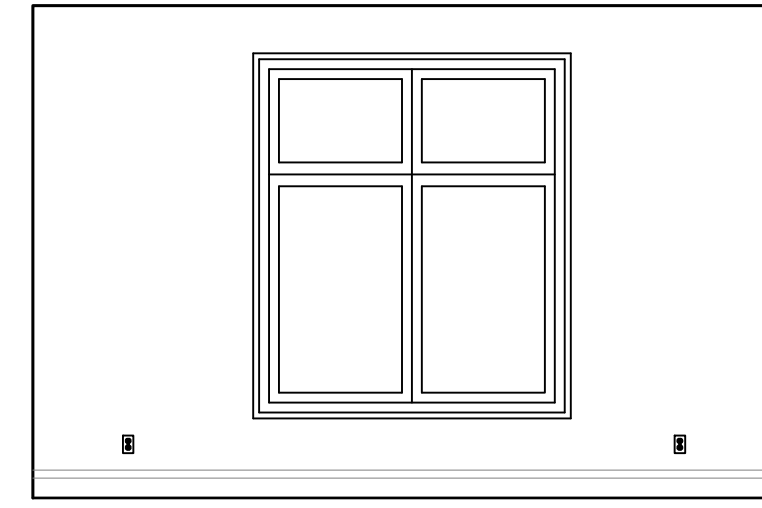


63 GUEST SUITE

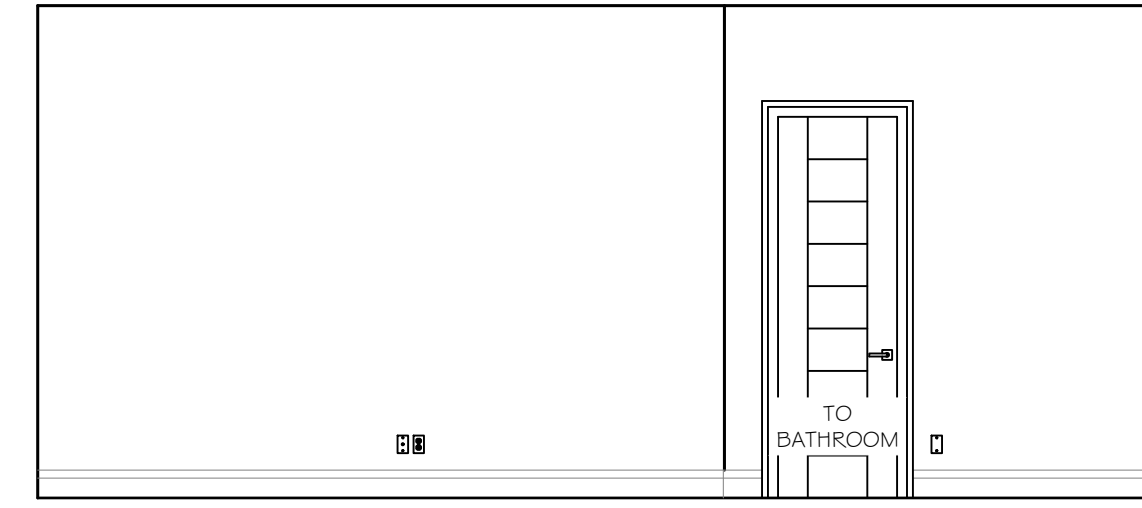


64 GUEST SUITE

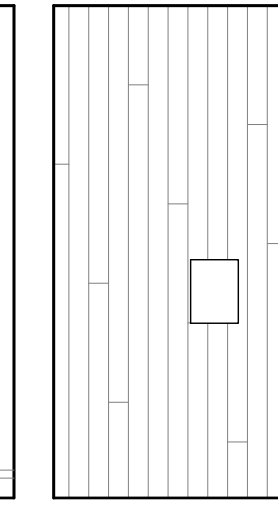


65 BATHROOM

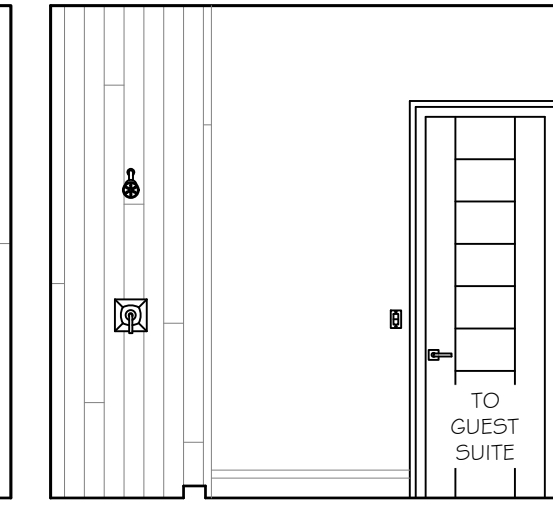

66 BATHROOM

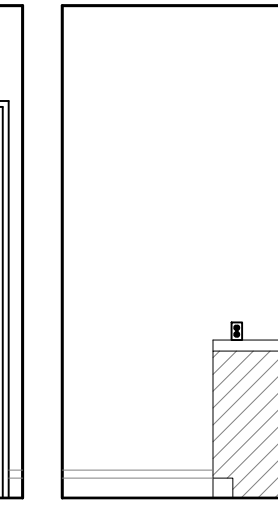

67 BATHROOM

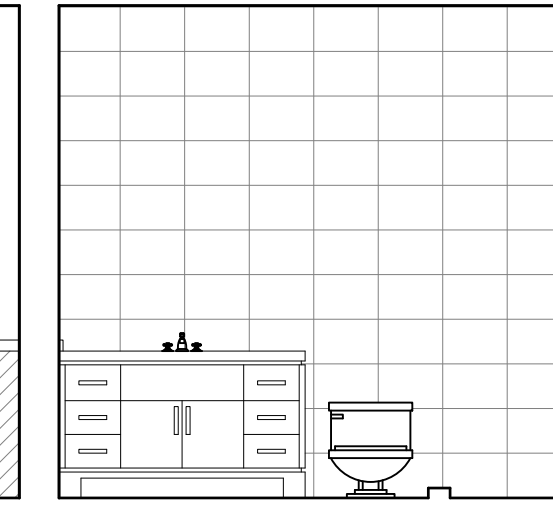

68 BATHROOM



PREPARED FOR

CLIENT

PROJECT TYPE

INTERIOR ELEVATIONS

PROJECT NAME

LARGE SFR SAMPLE

PROJECT ADDRESS

1234 PRECISION BOULEVARD
 CITY, CA 00000

All plans created by Precision Property Measurements. Use of these plans is restricted to the project for which they were prepared. No part of these plans may be reproduced, stored in a retrieval system, or transmitted in any form or by any means, electronic, mechanical, photocopying, recording, or by any information storage and retrieval system, without the prior written permission of Precision Property Measurements. PPM makes every reasonable effort to ensure the accuracy of the information based on the data provided. However, some of the drawings are preliminary and are subject to change. It is the duty of the architect, contractor, designer or other licensed professional, as a consultant to the property owner, to determine the suitability of the As-Built plans prior to construction. Measurements should be field confirmed before commencing construction. In the event that an error is found on a plan, PPM's liability is limited to the amount of the fee paid to PPM.

SCALE
 1/4" = 1'-0"

PROJECT
 XXXX_XX

APPROVED BY
 XX

DATE
 XXX/XX/XX

SHEET
 20 of 25





PREPARED FOR

CLIENT

PROJECT TYPE

INTERIOR ELEVATIONS


PROJECT NAME

LARGE SFR SAMPLE


PROJECT ADDRESS

1234 PRECISION BOULEVARD
 CITY, CA 00000


All plans created by Precision Property Measurements, LLC ("PPM") are made exclusively for the purposes of the project identified in the title block. PPM does not warrant the accuracy of the information provided on these plans, and the user of these plans assumes all liability for any errors or omissions. PPM is not a contractor and does not provide construction services. PPM is not responsible for the accuracy of the information provided on these plans, and the user of these plans assumes all liability for any errors or omissions. PPM is not a contractor and does not provide construction services. PPM is not responsible for the accuracy of the information provided on these plans, and the user of these plans assumes all liability for any errors or omissions. PPM is not a contractor and does not provide construction services.

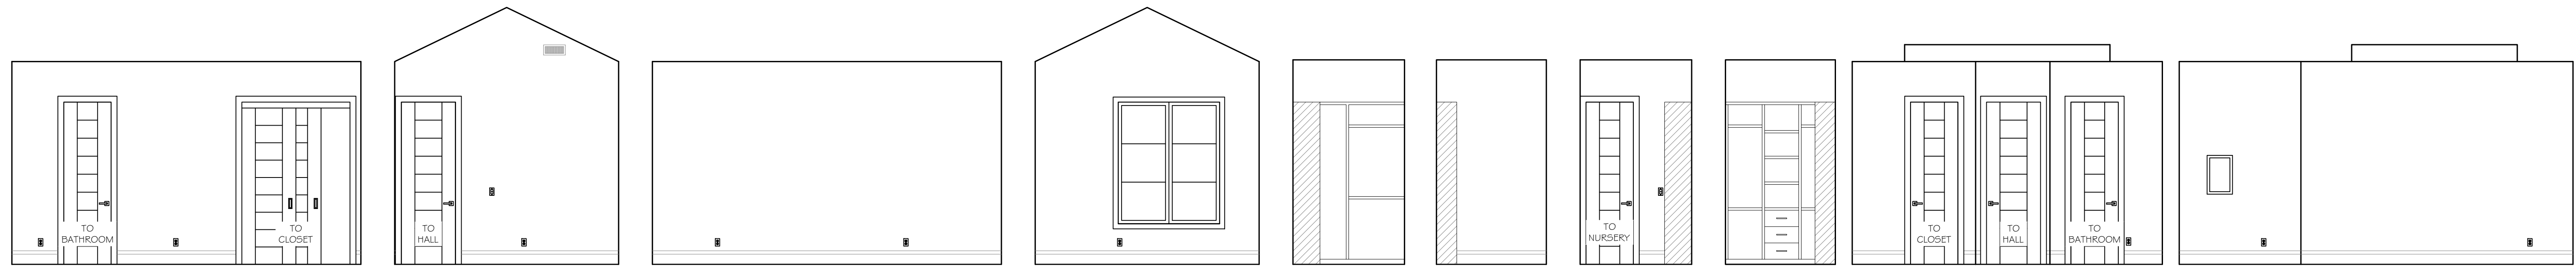


105 GUEST BED 2 106 GUEST BED 2 107 GUEST BED 2 108 GUEST BED 2 109 CLOSET 110 CLOSET 111 CLOSET 112 CLOSET 113 NURSERY 114 NURSERY

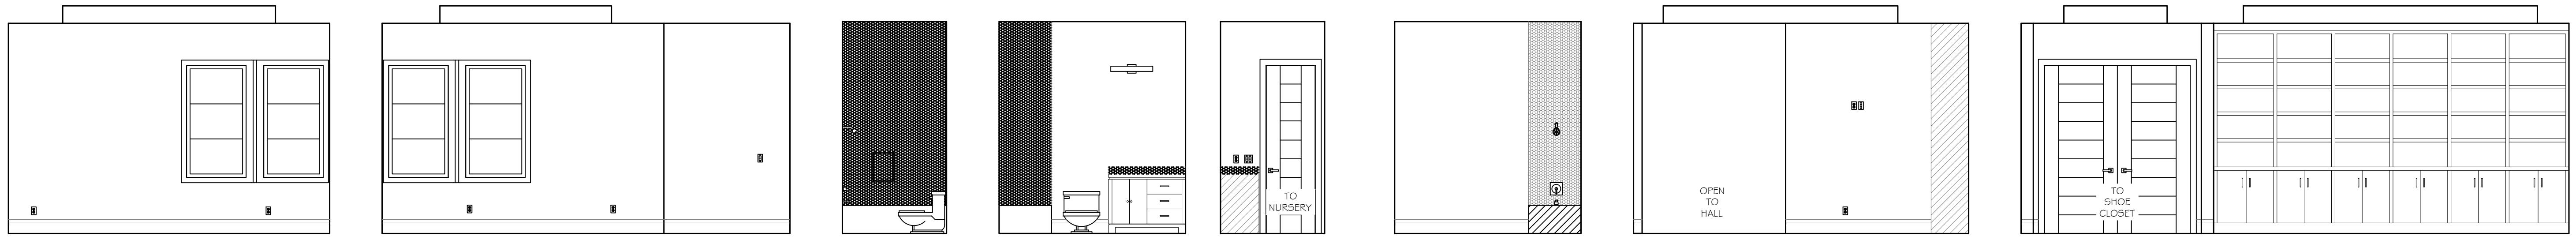


115 NURSERY 116 NURSERY 117 BATHROOM 118 BATHROOM 119 BATHROOM 120 BATHROOM 121 OFFICE 122 OFFICE

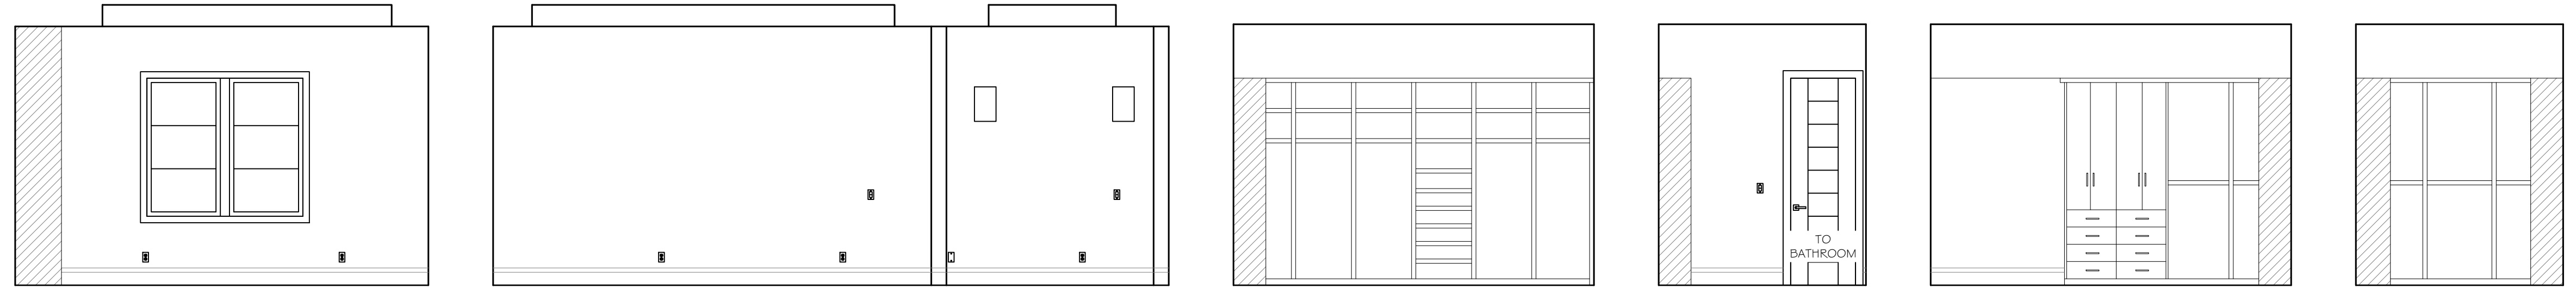


123 OFFICE 124 OFFICE 125 HIS CLOSET 126 HIS CLOSET 127 HIS CLOSET 128 HIS CLOSET

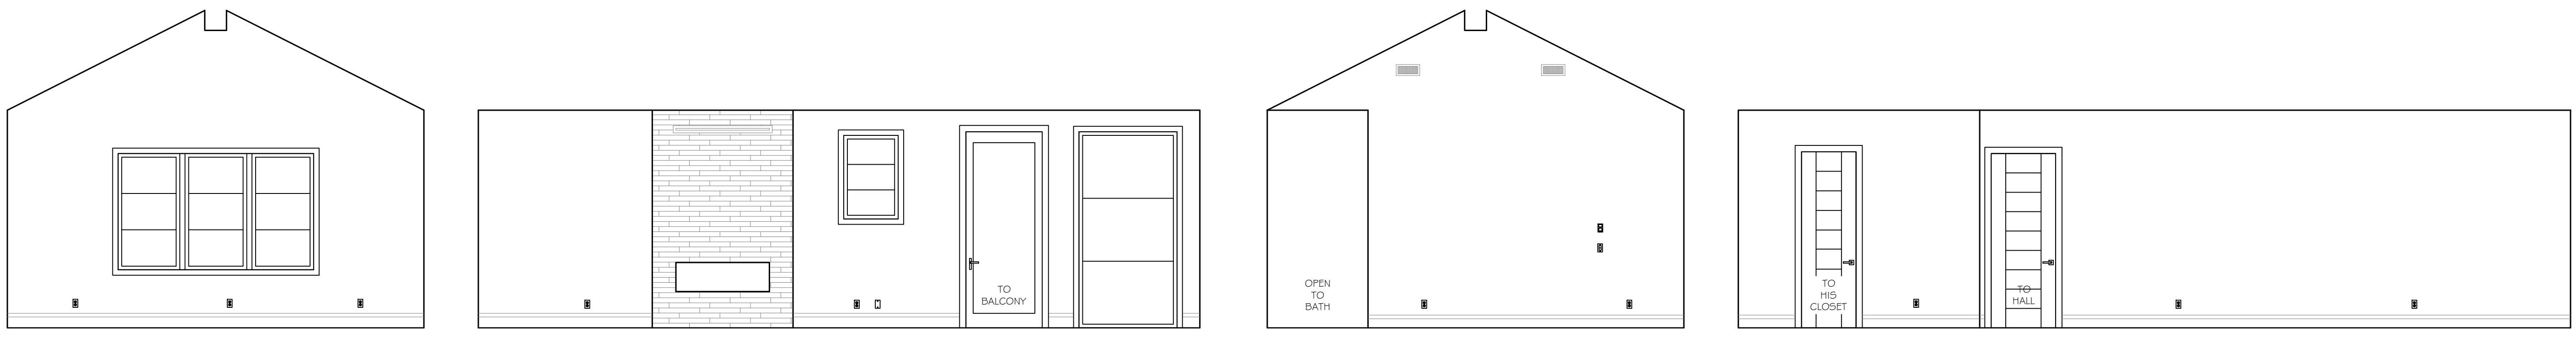

129 MASTER BEDROOM 130 MASTER BEDROOM 131 MASTER BEDROOM 132 MASTER BEDROOM

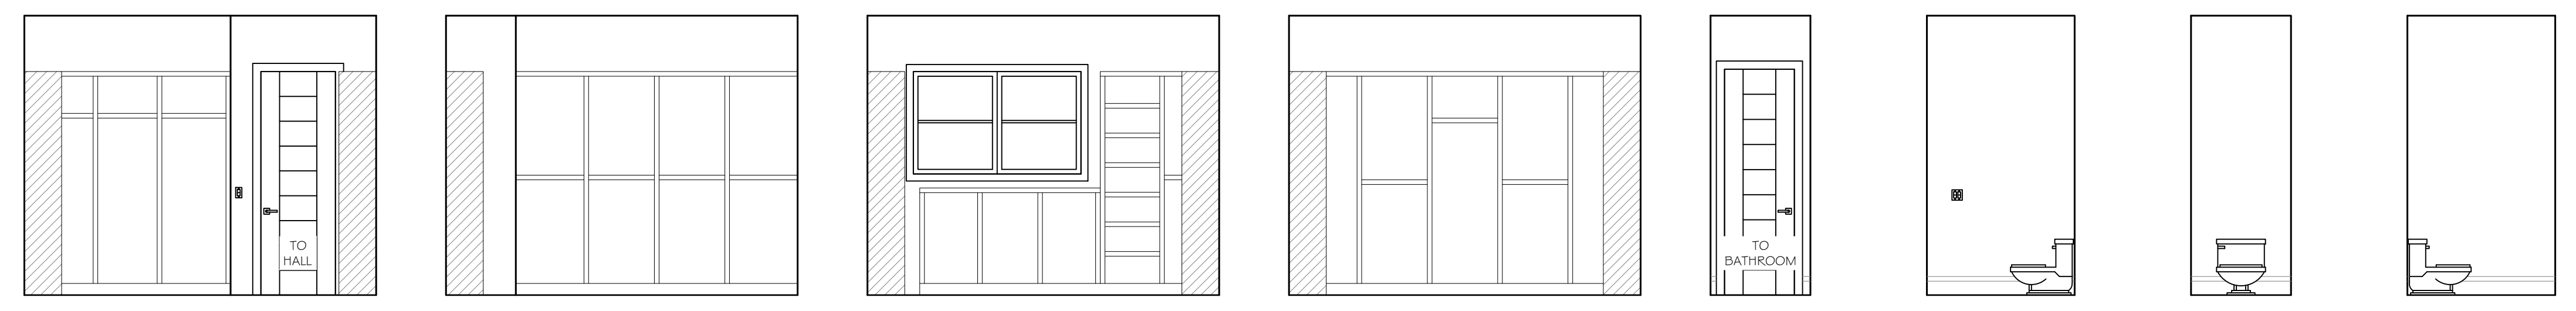

133 HER CLOSET 134 HER CLOSET 135 HER CLOSET 136 HER CLOSET 137 TOILET 138 TOILET 139 TOILET 140 TOILET

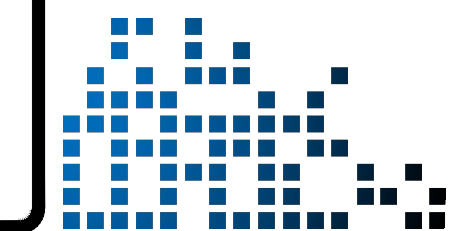

PREPARED FOR

CLIENT

PROJECT TYPE

INTERIOR ELEVATIONS

PROJECT NAME

LARGE SFR SAMPLE

PROJECT ADDRESS

1234 PRECISION BOULEVARD
 CITY, CA 00000

All plans created by Precision Property Measurements, LLC ("PPM") are made exclusively for the purposes of the project and are not to be used for any other purpose. PPM does not warrant the accuracy of the information provided on these plans. PPM makes every reasonable effort to ensure the accuracy of the information provided on these plans. However, some errors may occur. PPM's liability is limited to the amount of the fee paid to PPM.

SCALE
 1/4" = 1'-0"

PROJECT
 XXXX_XX

APPROVED BY
 XX

DATE
 XXXX/XX

SHEET
 22 of 25

1234 PRECISION BOULEVARD
 CITY, CA 00000


1234 PRECISION BOULEVARD
 CITY, CA 00000

1234 PRECISION BOULEVARD
 CITY, CA 00000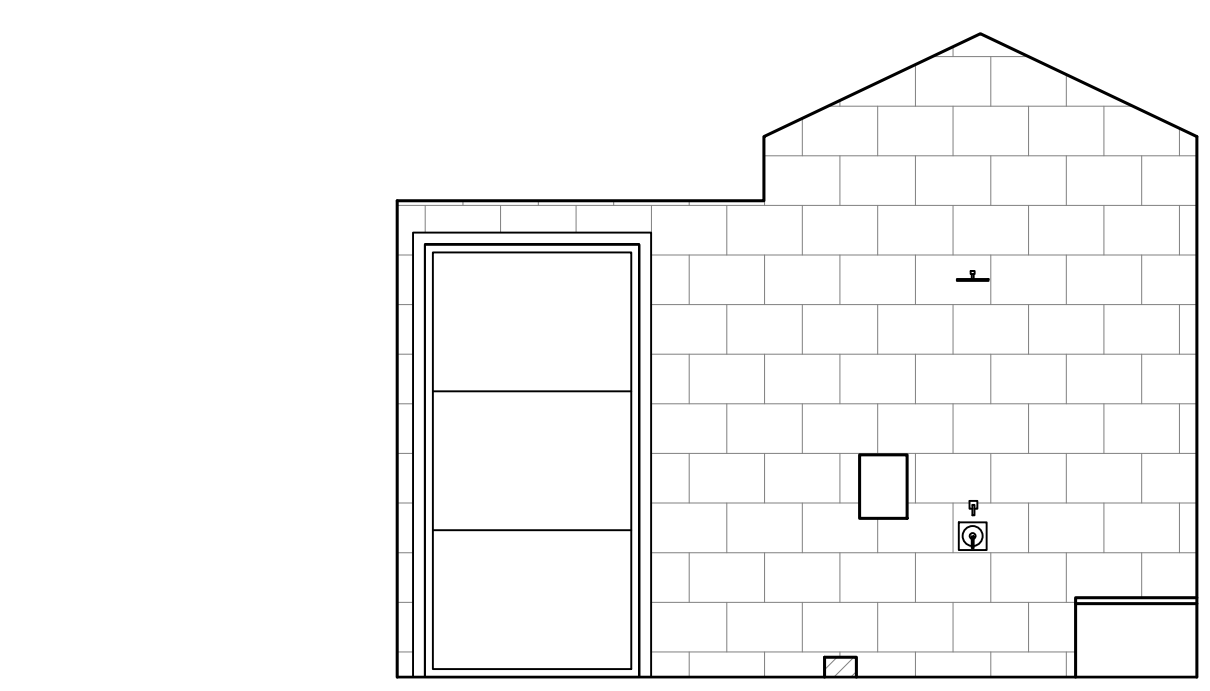


141 MASTER BATH

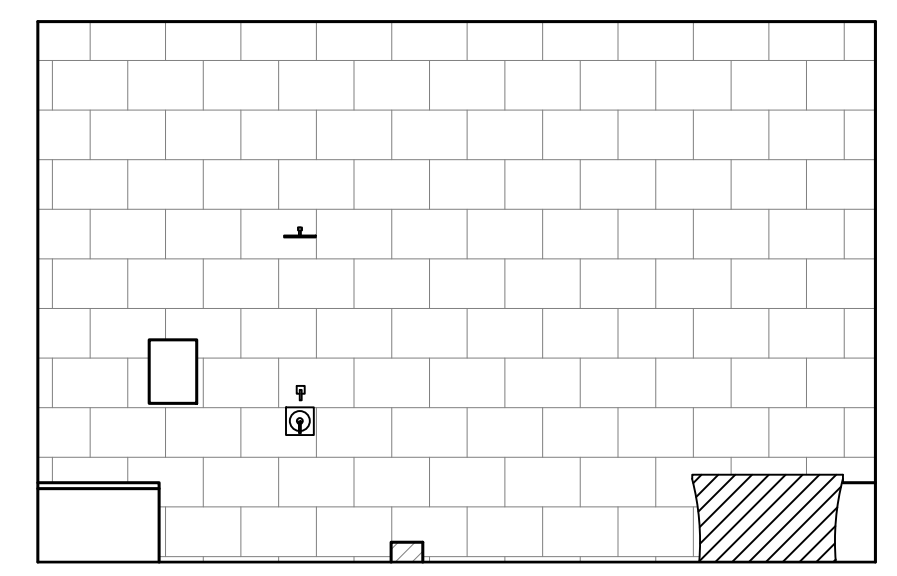


142 MASTER BATH




143 MASTER BATH

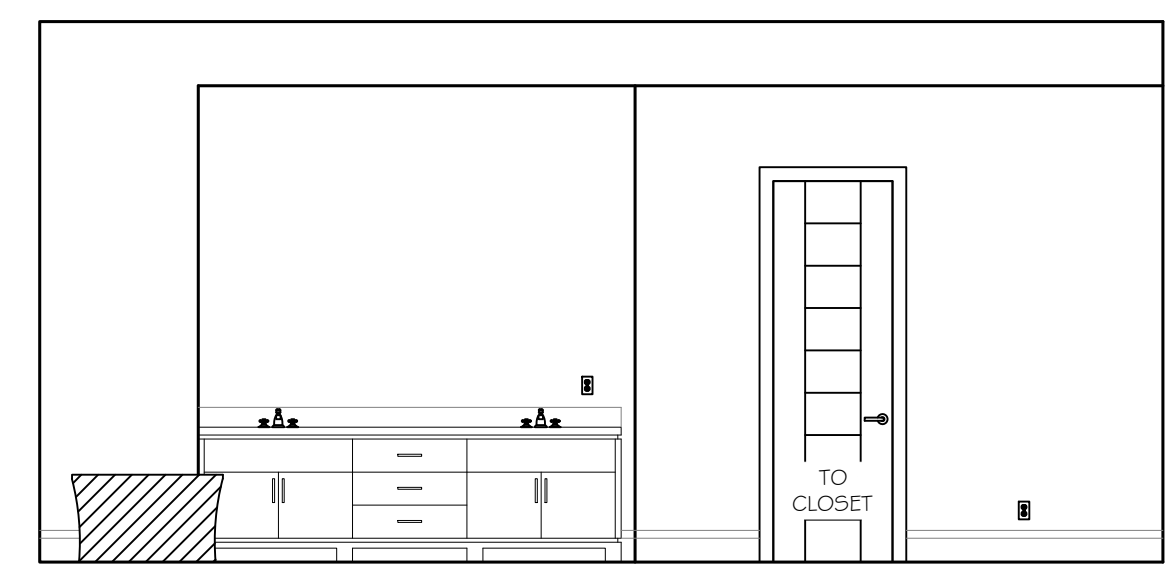


144 MASTER BATH

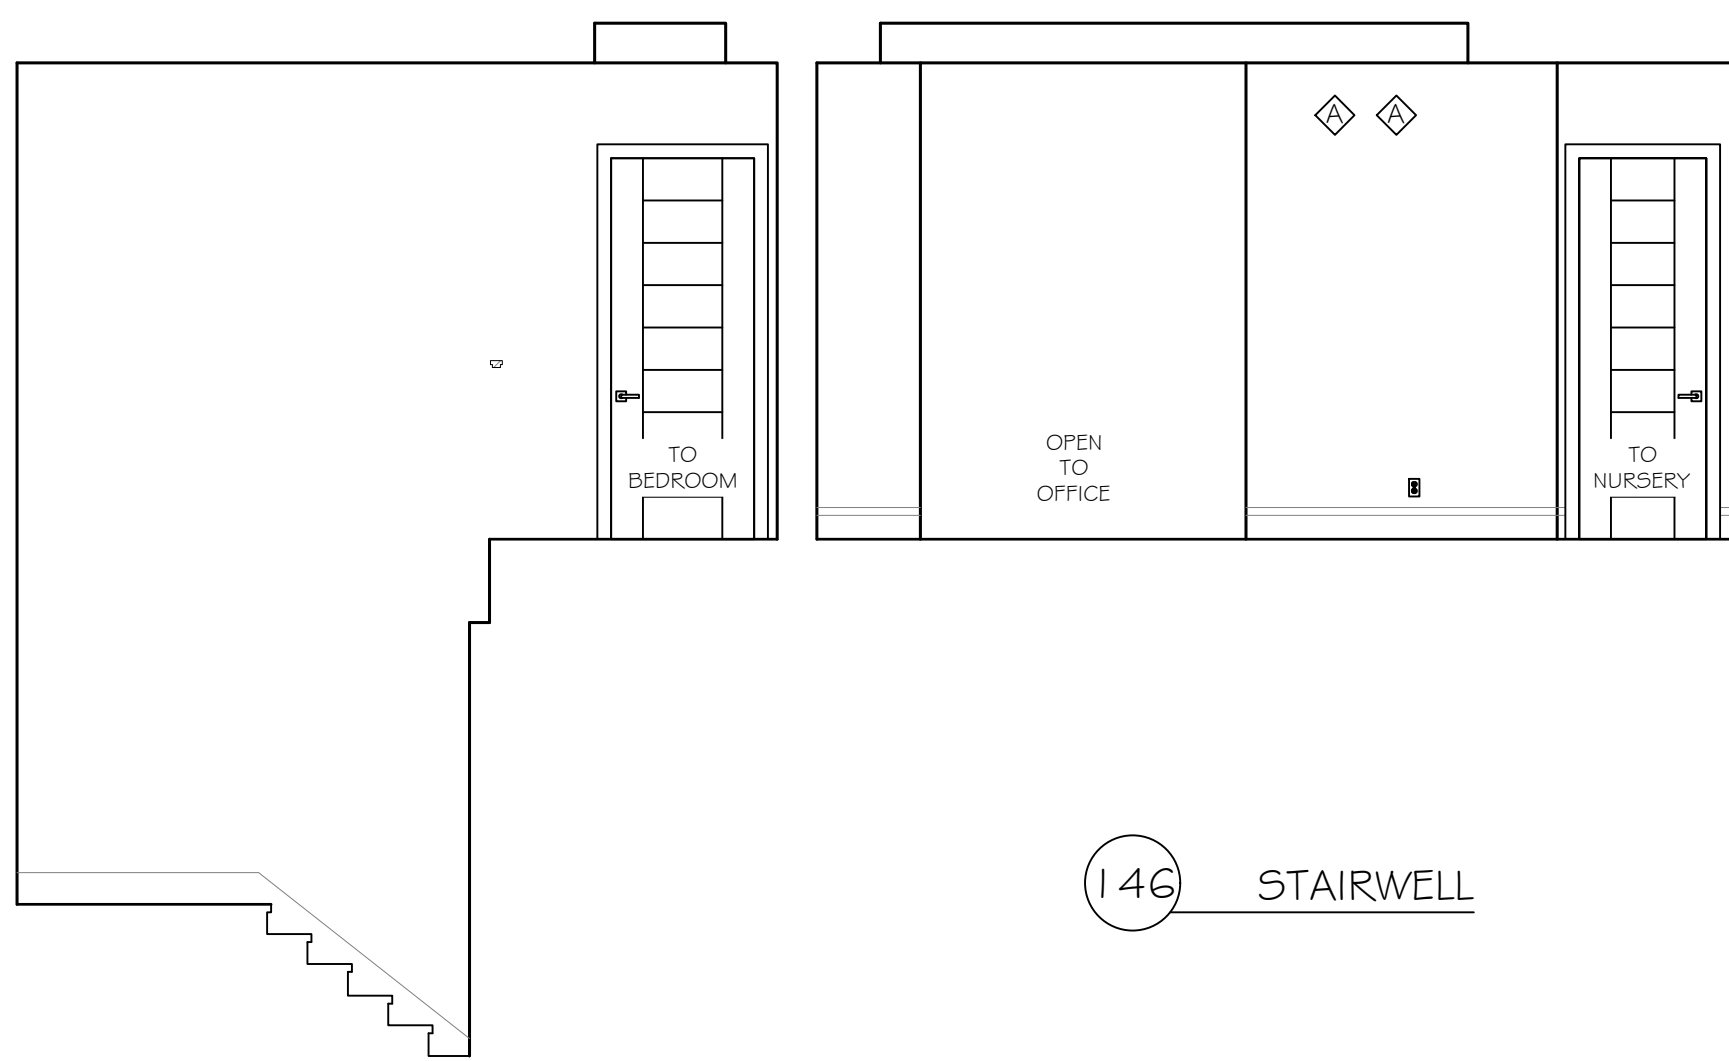


146 STAIRWELL

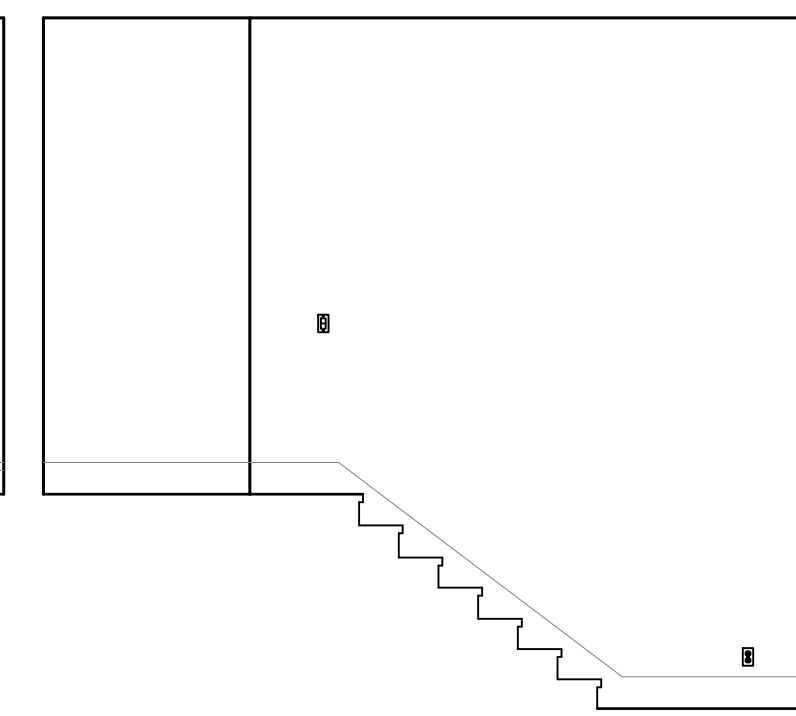


147 STAIRWELL

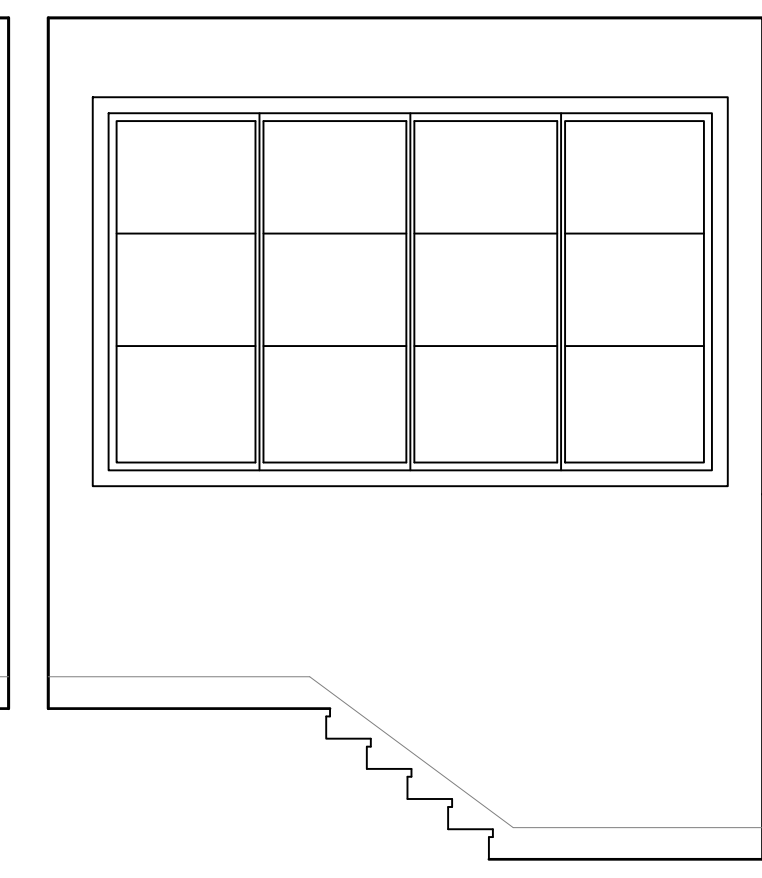


148 STAIRWELL

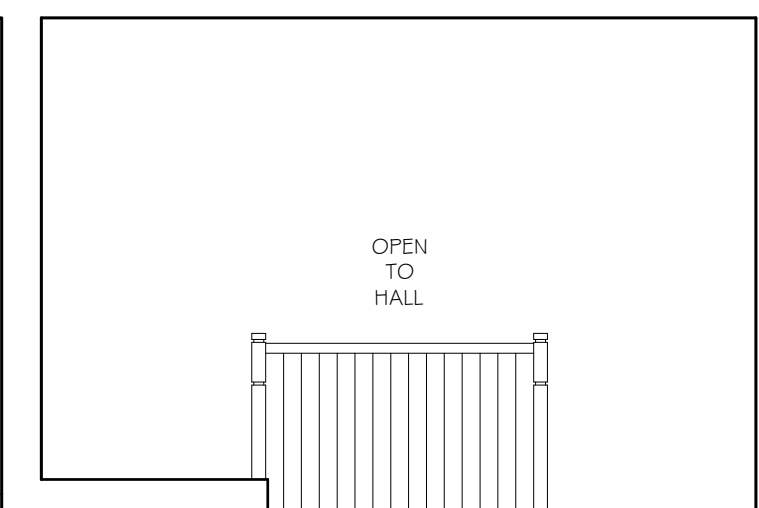


149 STAIRWELL

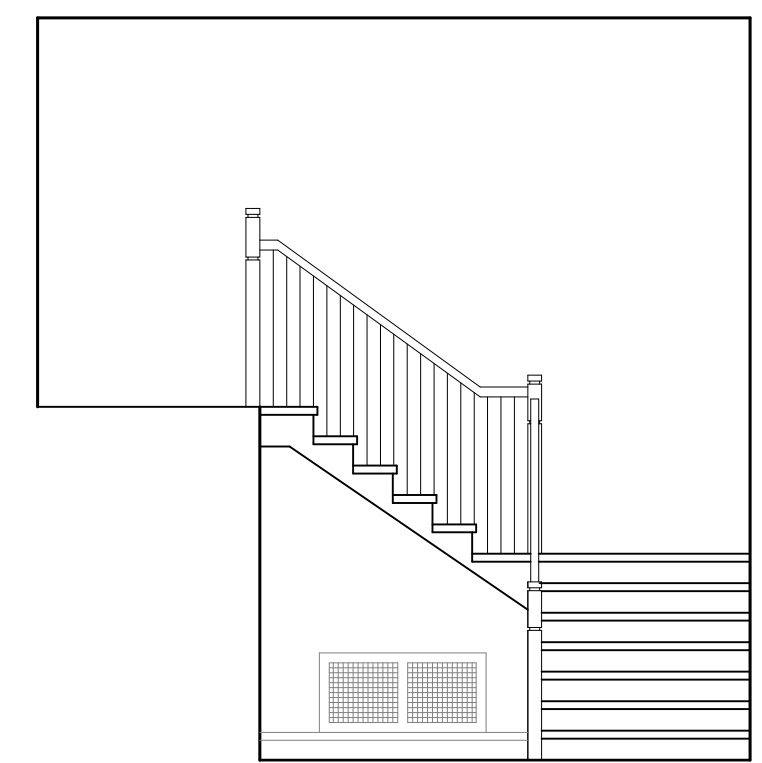


150 STAIRWELL

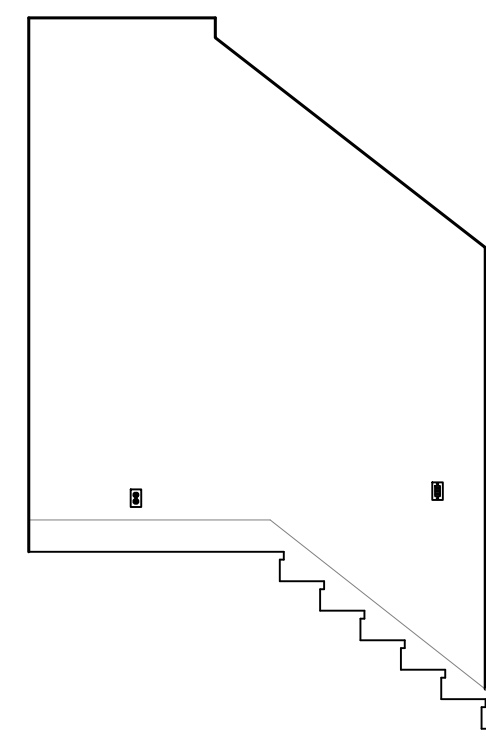


151 STAIRWELL

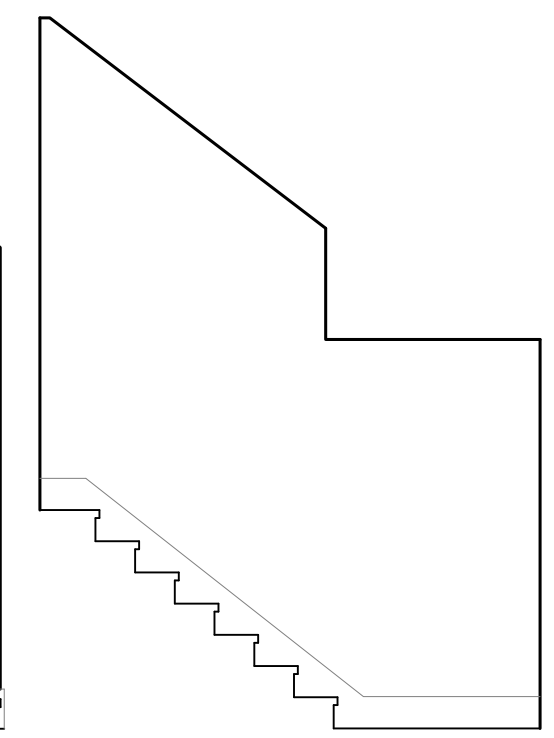


152 STAIRWELL

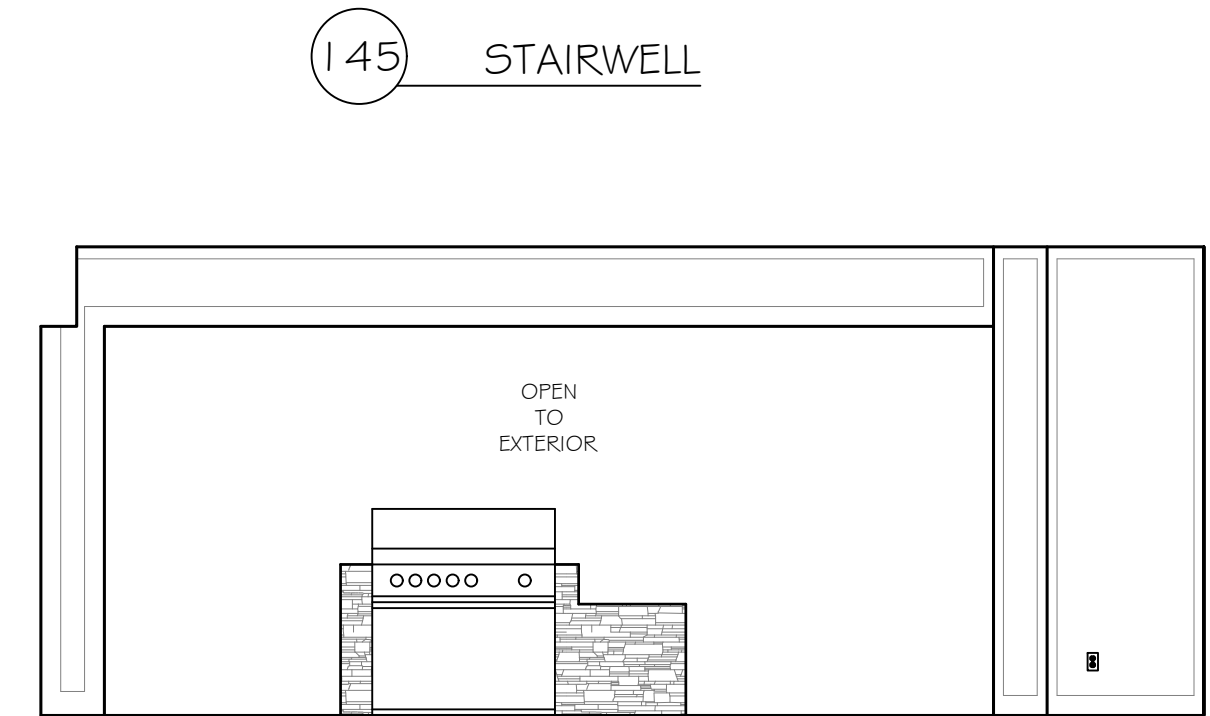


153 POOL HOUSE PATIO

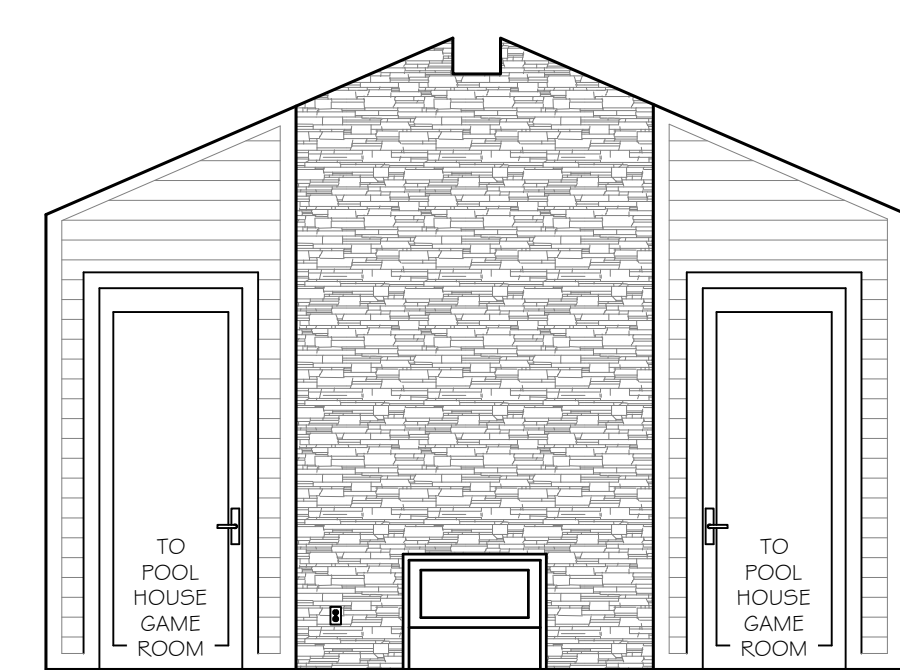


154 POOL HOUSE PATIO

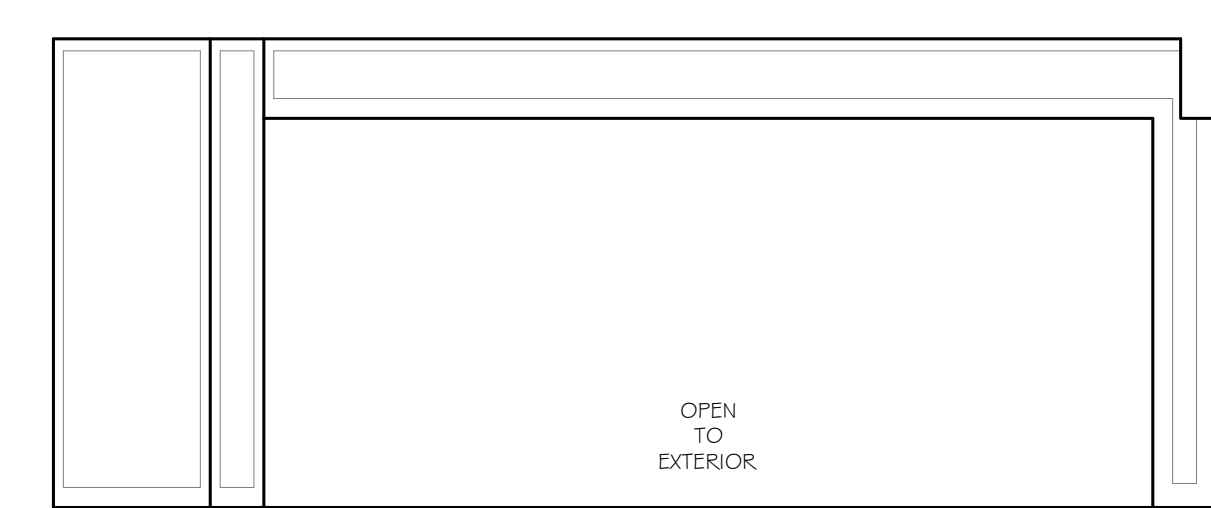


155 POOL HOUSE PATIO

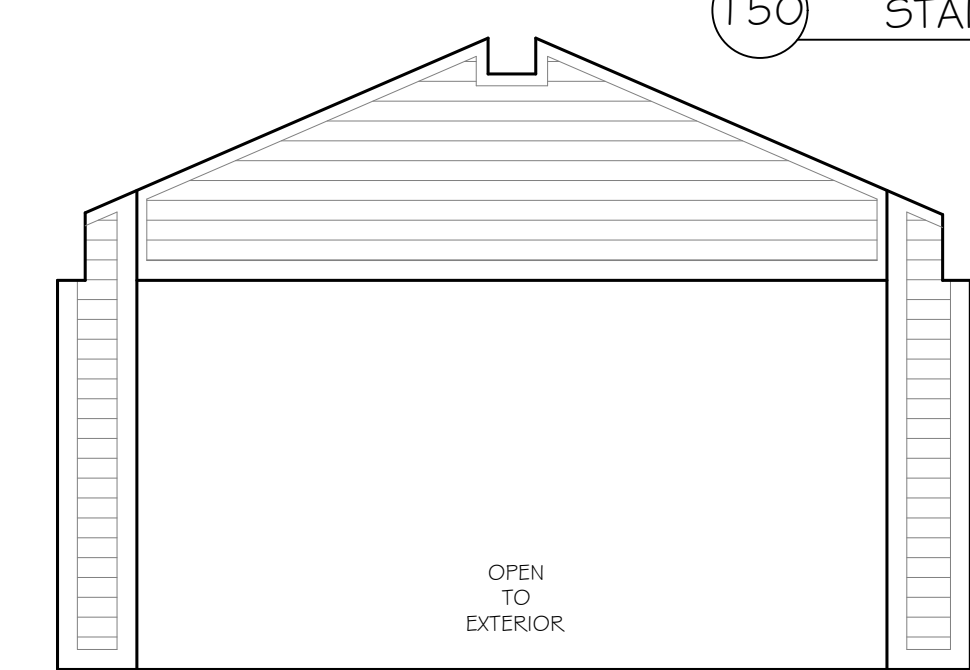


156 POOL HOUSE PATIO

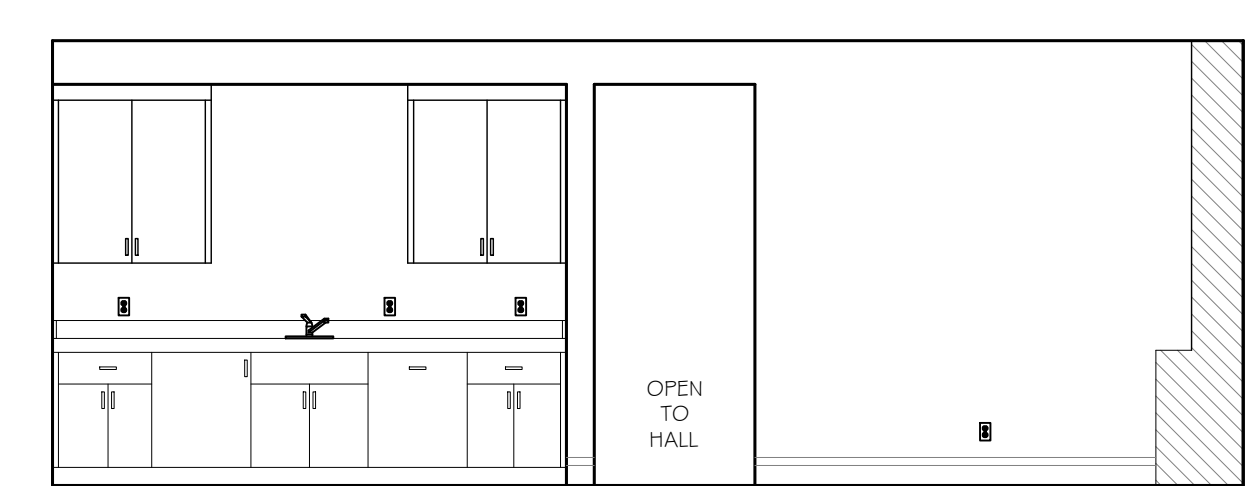


157 POOL HOUSE GAME ROOM

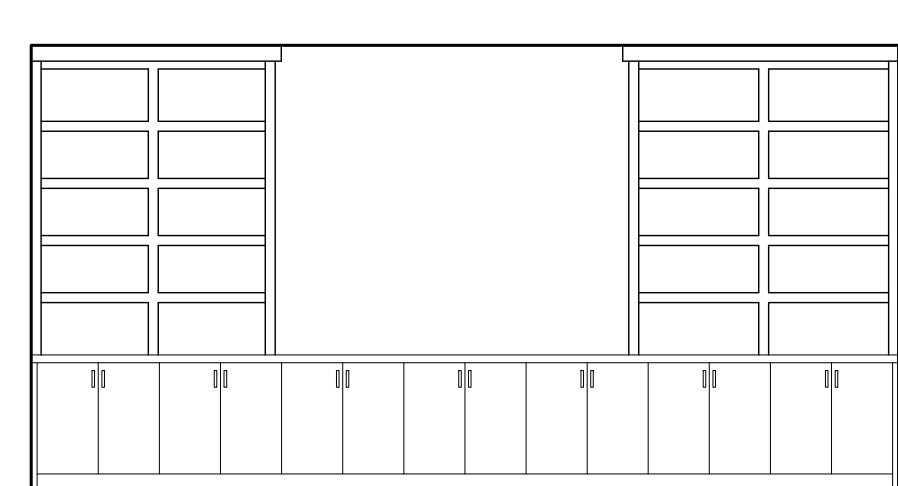


158 POOL HOUSE GAME ROOM

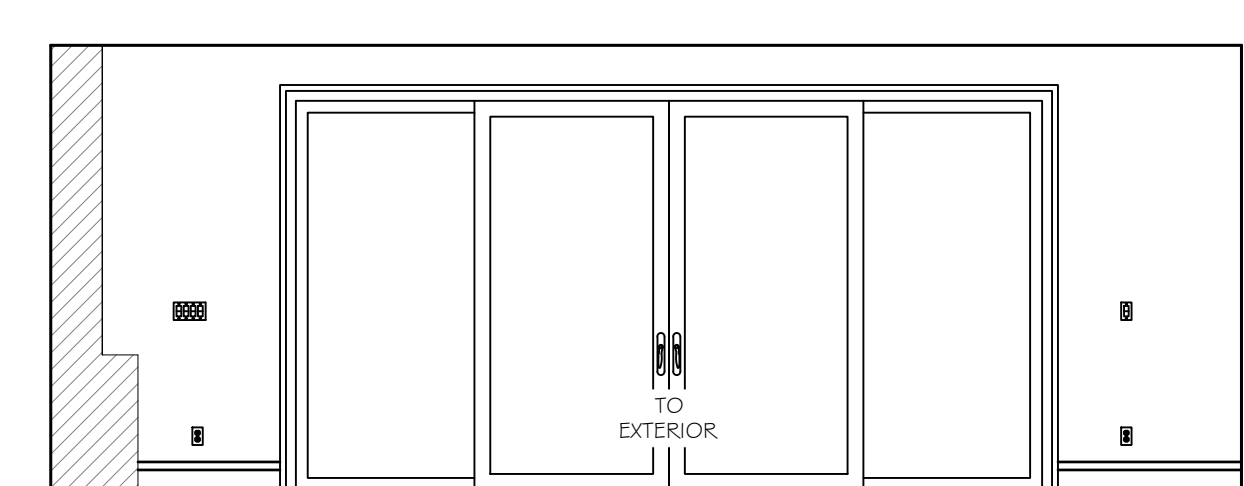


159 POOL HOUSE GAME ROOM

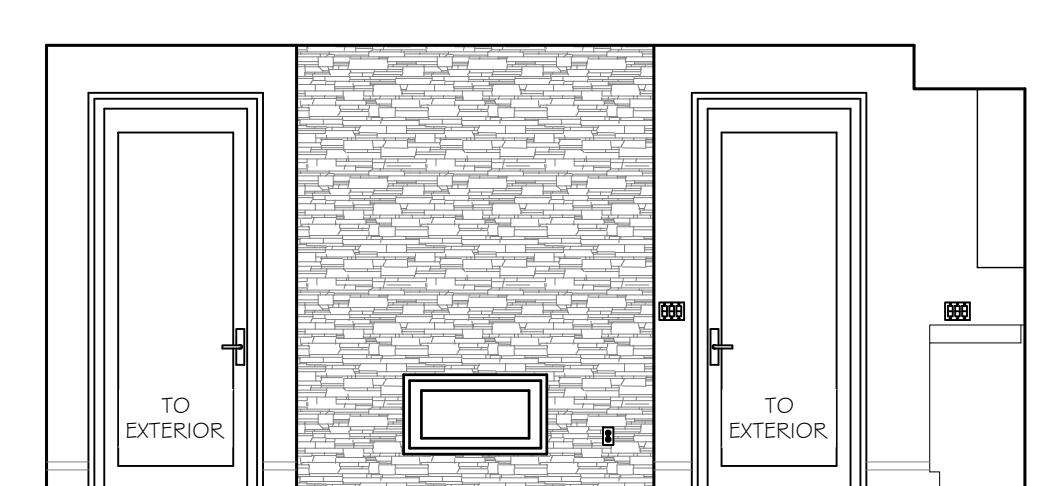


160 POOL HOUSE GAME ROOM

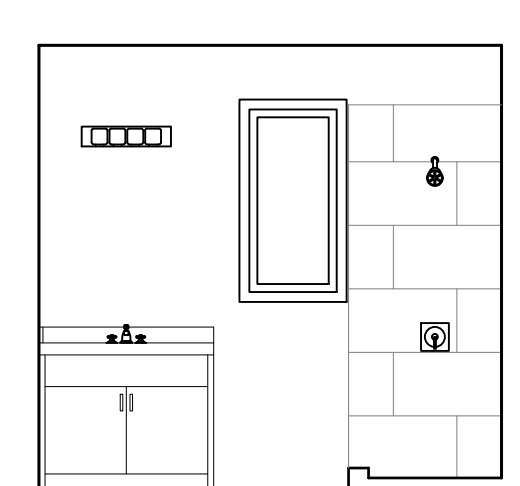


161 BATHROOM

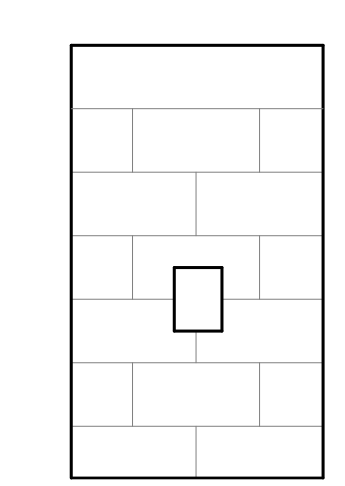

162 BATHROOM

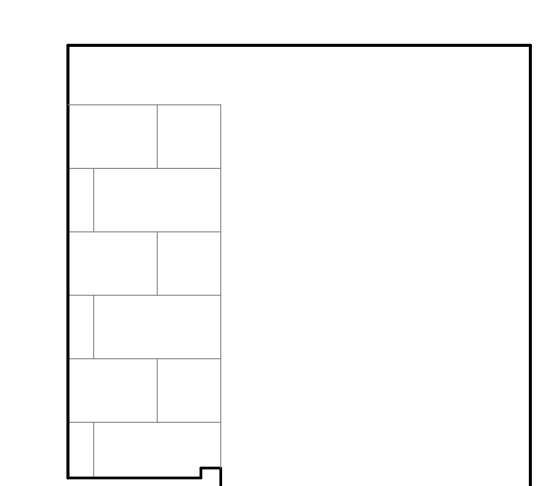

163 BATHROOM

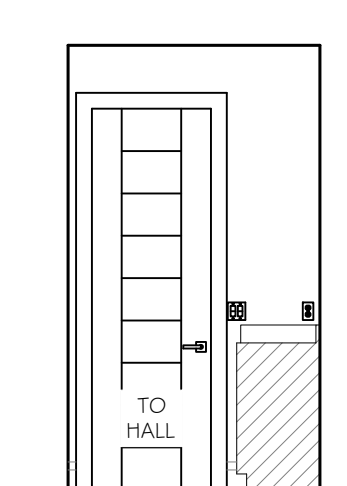

164 BATHROOM