


ALMENDRAL AVE

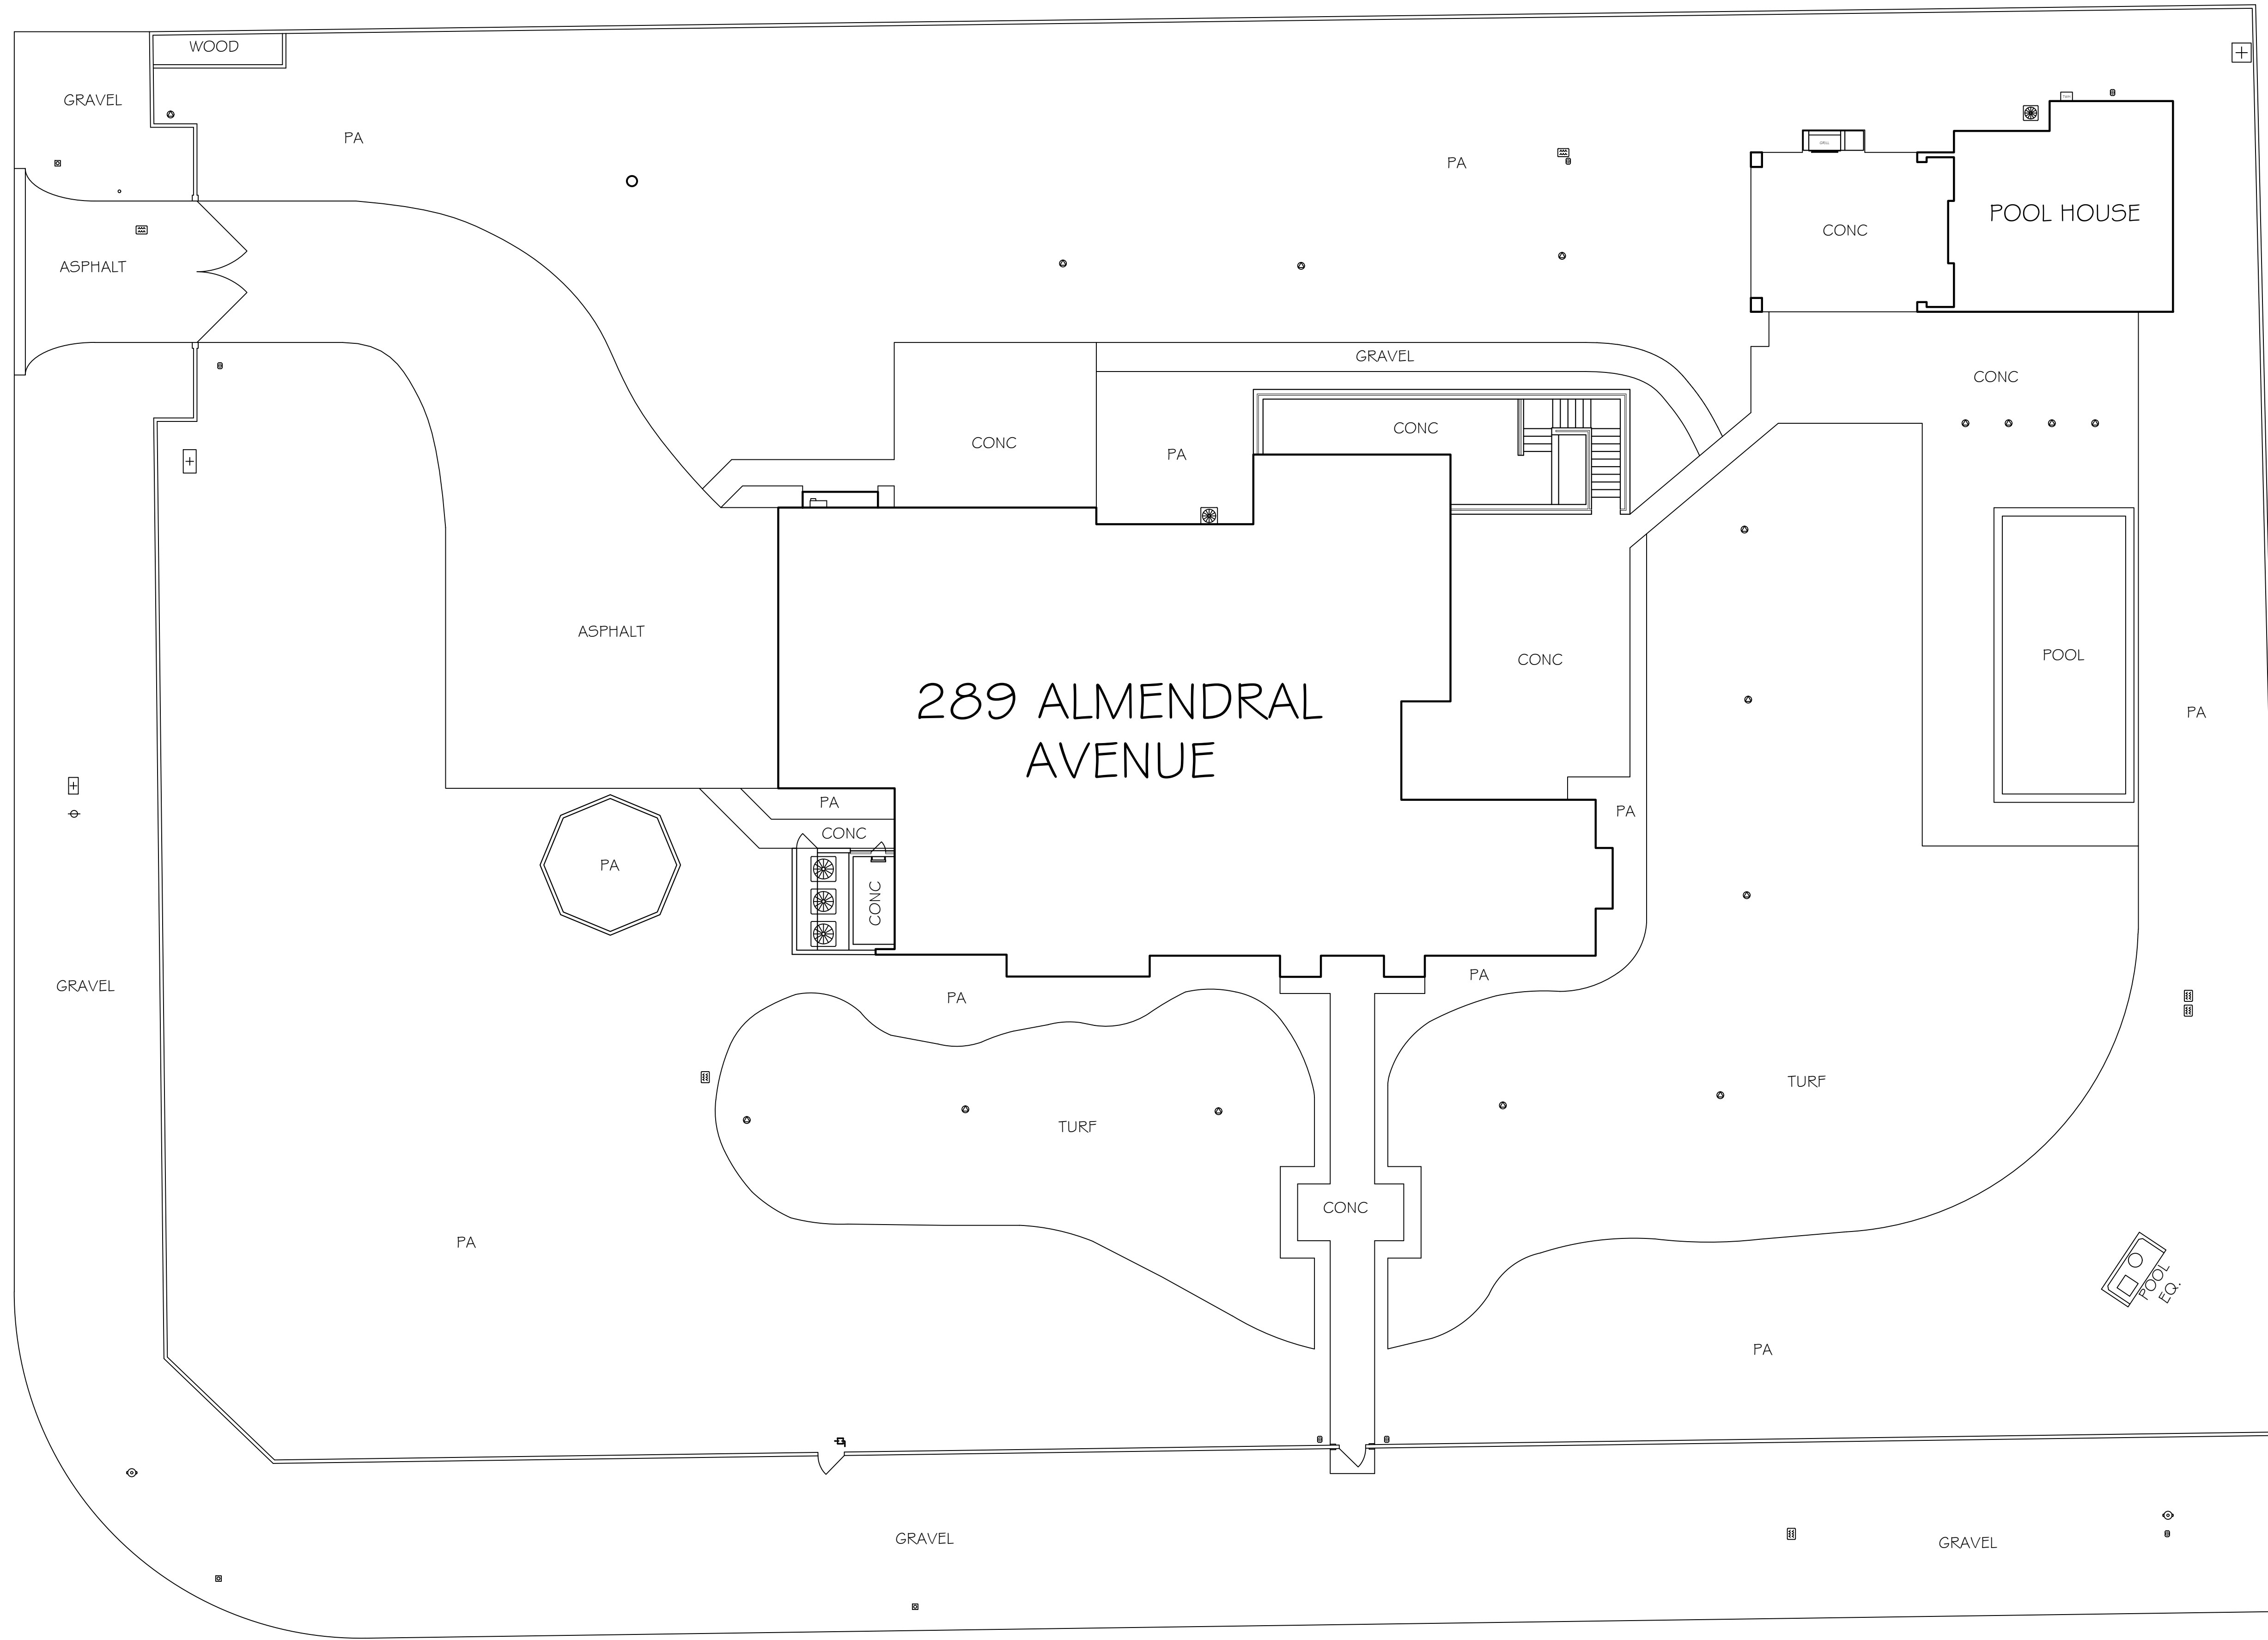

289 ALMENDRAL AVENUE

SELBY LN

LEGEND

FLOWLINE

- = STEP MARKER
- ☼ = STREET LIGHT
- ⊞ = STREET SIGN / POST
- ⊕ = UTILITY POLE
- ⊗ = AIR CONDITIONER
- ⊞ = UTILITY BOX
- ⊞ = WATER METER
- ⊗ = DRAIN
- ⊗ = FIRE HYDRANT
- ⊗ = SEWER / MAN-HOLE COVER
- ⊞ = IRRIGATION CONTROL VALVE
- ⊞ = HOSE BIB
- ⊞ = GAS METER
- ⊞ = ELECTRIC METER
- ⊞ = SOLAR COMPONENTS
- ⊞ = NATURAL GAS LINE
- ⊞ = DOWNSPOUT
- BR = BRICK
- WF = WATER FEATURE
- PA = PLANTING AREA
- EQ = EQUIPMENT
- CONC = CONCRETE

PPM
PRECISION PROPERTY MEASUREMENTS

3626 E. PACIFIC COAST HIGHWAY | 2ND FLOOR
LONG BEACH CA | 90804
T 562.621.9100
F 888.698.2966
WWW.PPMCO.NET

WORRY FREE RENOVATIONS

PREPARED FOR

CLIENT

PROJECT TYPE

SITE PLAN


PROJECT NAME

LARGE SFR SAMPLE

PROJECT ADDRESS

1234 PRECISION BOULEVARD
CITY, CA 00000

All plans created by Precision Property Measurements, LLC ("PPM") are made exclusively for landscaping purposes (i.e., this is a Final Code Book (FCB)). All data points created by PPM do not indicate the determination of any property line, and as such do not constitute legal advice. (See Civil Code § 817.2(a)(2)(2)(F) in addition, PPM services are not intended to constitute an engineering (i.e., this is a Final Code Book (FCB)) and this should not be used for any activity or activities defined as an engineering (i.e., this is a Final Code Book (FCB)). All floor plans created by PPM are intended to be used as a reference for design and construction and should not be considered a substitute for the services of a licensed structural engineer or licensed architect. PPM makes every reasonable effort to ensure the accuracy of the information located on its plans. However, some of the drawings are not intended to be a substitute for the services of an architect, contractor, designer or other licensed professional, and a consultant to the property owner, to determine the suitability of the As-Built plans prior to construction. Measurements should be field confirmed before commencing construction, in the event that an error is found on a plan, PPM's liability is limited to the amount of the fee paid to PPM.

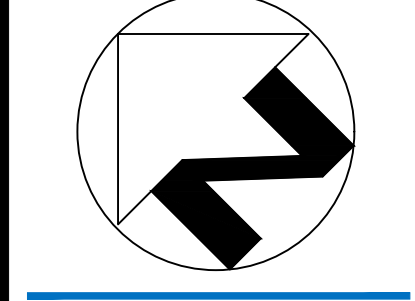

SCALE
3/32" = 1'-0"

PROJECT
XXXX_XX

APPROVED BY
XX

DATE
XX/XX/XX

SHEET