

PREPARED FOR

COMPANY

PLAN TYPE

SECTIONS


PROJECT NAME

CLASS B OFFICE
SAMPLE


PROJECT ADDRESS

STREET NAME
CITY, CA 00000

All plans created by Precision Property Measurements, LLC ("PPM") are made exclusively for landscaping purposes (CA, Title 4 Prof. Code 86727). All other plans created by PPM do not make the determination of any property line, and as such do not constitute land acquisition. (CA, Title 4 Prof. Code 86727.2(b)(2)). In addition, PPM services and plans do not constitute an engineering (CA, Title 4 Prof. Code 86727.2(b)(4)), and this should not be used for any activity or activities defined as an engineering (CA, Title 4 Prof. Code 86727.2(b)(4)). All floor plans created by PPM are intended to be used as a reference for general construction and should not be considered a substitute for the services of a licensed structural engineer or licensed architect. PPM makes every reasonable effort to ensure the accuracy of its calculations based on data. However, some of the drawing information may be in some degree, it is the duty of the architect, contractor, designer or other licensed professional, as a consultant to the property owner, to determine the suitability of the As-Built plans prior to construction. Measurements should be field confirmed before commencing construction, in the event that an error is found on a plan, PPM's liability is limited to the amount of the fee paid to PPM.

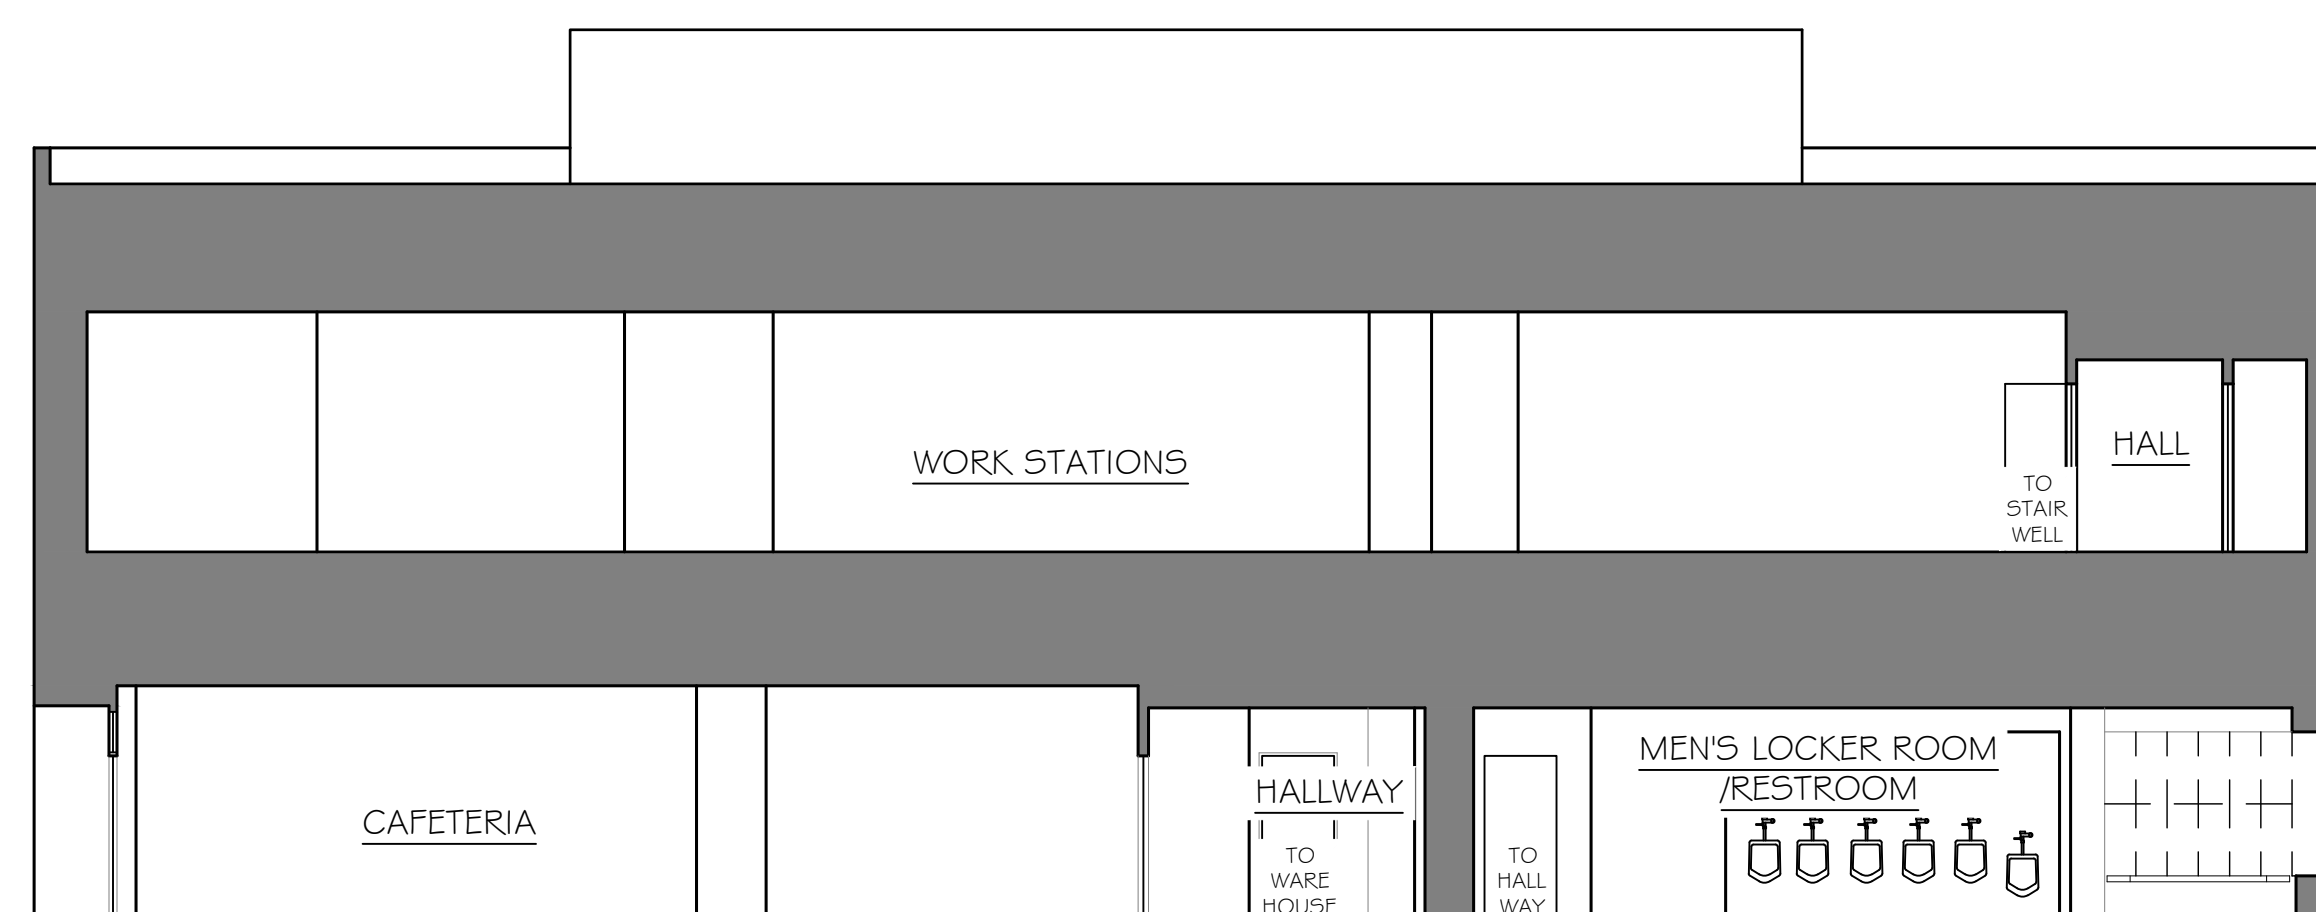

A SECTION

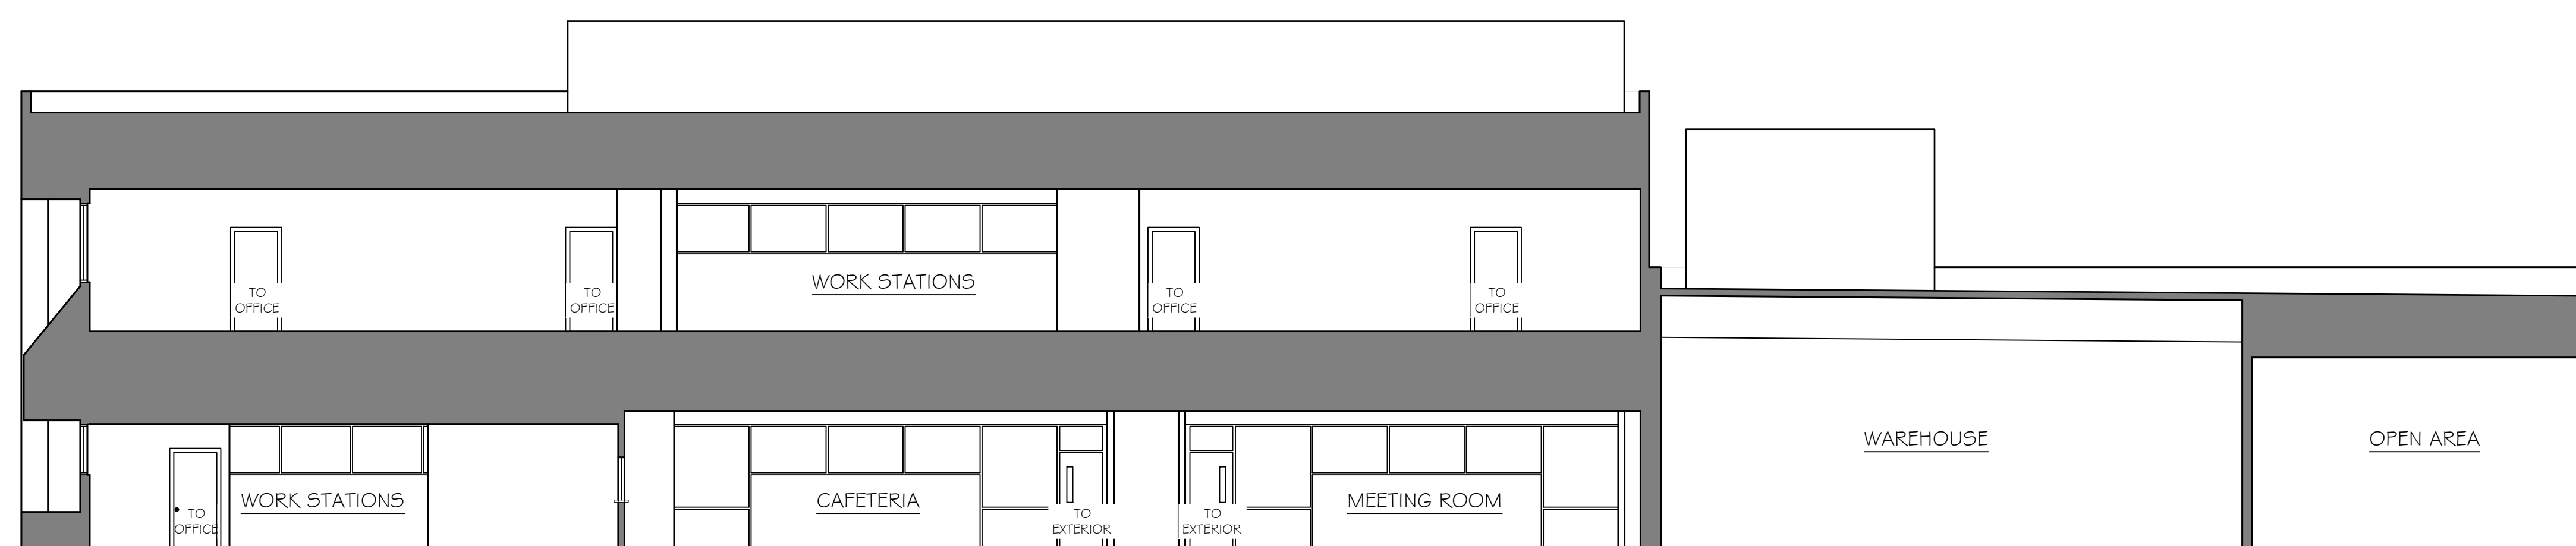

B SECTION

SCALE
1/8" = 1'-0"
PROJECT
XXXX_XX
APPROVED BY
XX
DATE
00/00/00
SHEET

6 of 7

