



COUNTER

UPPER CABINET

FULL HEIGHT CABINET

= WASHER/DRYER COMBO
= WASHER
DRYER
= RANGE

= REFRIGERATOR

OCC = OVEN

OCC = DISH WASHER

OCC = TRASH COLLECTOR

3 = WALL HEATER

D = GAS METER = ELECTRIC METER CLG = CEILING HEIGHT

HH = HEADER HEIGHT

WORRY FREE RENOVATIONS

PRECISION PROPERTY

3626 E. PACIFIC COAST HIGHWAY | 2ND FLOOR

LONG BEACH CA | 90804

MEASUREMENTS

T 562.621.9100 F 888.698.2966 WWW.PPMCO.NET

PREPARED FOR

ARCHITECT PLANNING

PROJECT TYPE

FLOOR PLAN


PROJECT NAME

RESIDENCE

PROJECT ADDRESS

1234 CHERRY TREE BOULEVARD LONG BEACH CITYSCAPE, CA 90000

All plans created by Precision Property
Measurement Ltd "PPM" are made exclusively
for landscaping purposes (Cal. Bus. \$ Prof.
Code §8727). All site plans created by PPM do not
involve the determination of any property line, and as
such do not constitute land surveying
(Cal. Bus. \$ Prof. Code §§8726-8727). In
addition, PPM services and plans do not constitute
civil engineering (Cal. Bus. \$ Prof. Code §§6702-6704),
and thus should not be used for any studies or activities
defined as civil engineering (Cal. Bus. \$ Prof. Code
§6731). All floor plans created by PPM are intended to
be used as a reference for design and construction and
should not be considered a substitute for the services of
a licensed structural engineer or licensed architect. PPM
makes every reasonable effort to ensure the accuracy of
the information found in our plans. However, every
As-Built drawing inherently contains errors to some
degree. It is the duty of the architect, contractor,
designer or other licensed professional, as a consultant
to the property owner, to determine the suitability of the
As-Built plans prior to construction. Measurements should
be field confirmed before commencing construction. In the
event that an error is found on a plan, PPMs liability is
limited to the amount of the fee paid to PPM.

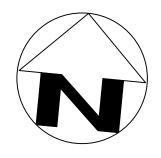



 $\frac{1}{4}$ " = 1'-0" PROJECT

12345 APPROVED BY CT

> DATE 9/18/19

SHEET 4 of 17

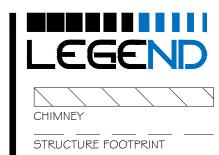

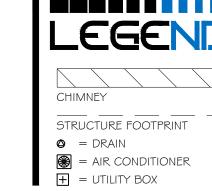



PRECISION PROPERTY **MEASUREMENTS**

3626 E. PACIFIC COAST HIGHWAY | 2ND FLOOR LONG BEACH CA | 90804 T 562.621.9100 F 888.698.2966 WWW.PPMCO.NET



PREPARED FOR

ARCHITECT PLANNING

PROJECT TYPE

ROOF PLAN


PROJECT NAME

RESIDENCE

PROJECT ADDRESS

1234 CHERRY TREE BOULEVARD LONG BEACH, CA 90000

All plans created by Precision Property
Measurement Ltd "PPM" are made exclusively
for landscaping purposes (Cal. Bus. 4 Prof.
Code §8727). All site plans created by PPM do not
involve the determination of any property line, and as
such do not constitute land surveying
(Cal. Bus. 4 Prof. Code §§8726-8727). In
addition, PPM services and plans do not constitute
civil engineering (Cal. Bus. 4 Prof. Code §§6702-6704),
and thus should not be used for any studies or activities
defined as civil engineering (Cal. Bus. 4 Prof. Code
§6731). All floor plans created by PPM are intended to
be used as a reference for design and construction and
should not be considered a substitute for the services of
a licensed structural engineer or licensed architect. PPM
makes every reasonable effort to ensure the accuracy of
the information found in our plans. However, every
As-Built drawing inherently contains errors to some
degree. It is the duty of the architect, contractor,
designer or other licensed professional, as a consultant
to the property owner, to determine the suitability of the
As-Built plans prior to construction. Measurements should
be field confirmed before commencing construction, in the
event that an error is found on a plan, PPM's liability is
limited to the amount of the fee paid to PPM.

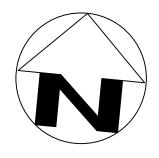


 $\frac{1}{4}$ " = 1'-0" PROJECT

12345 APPROVED BY

CT DATE

9/18/19 14 of 17

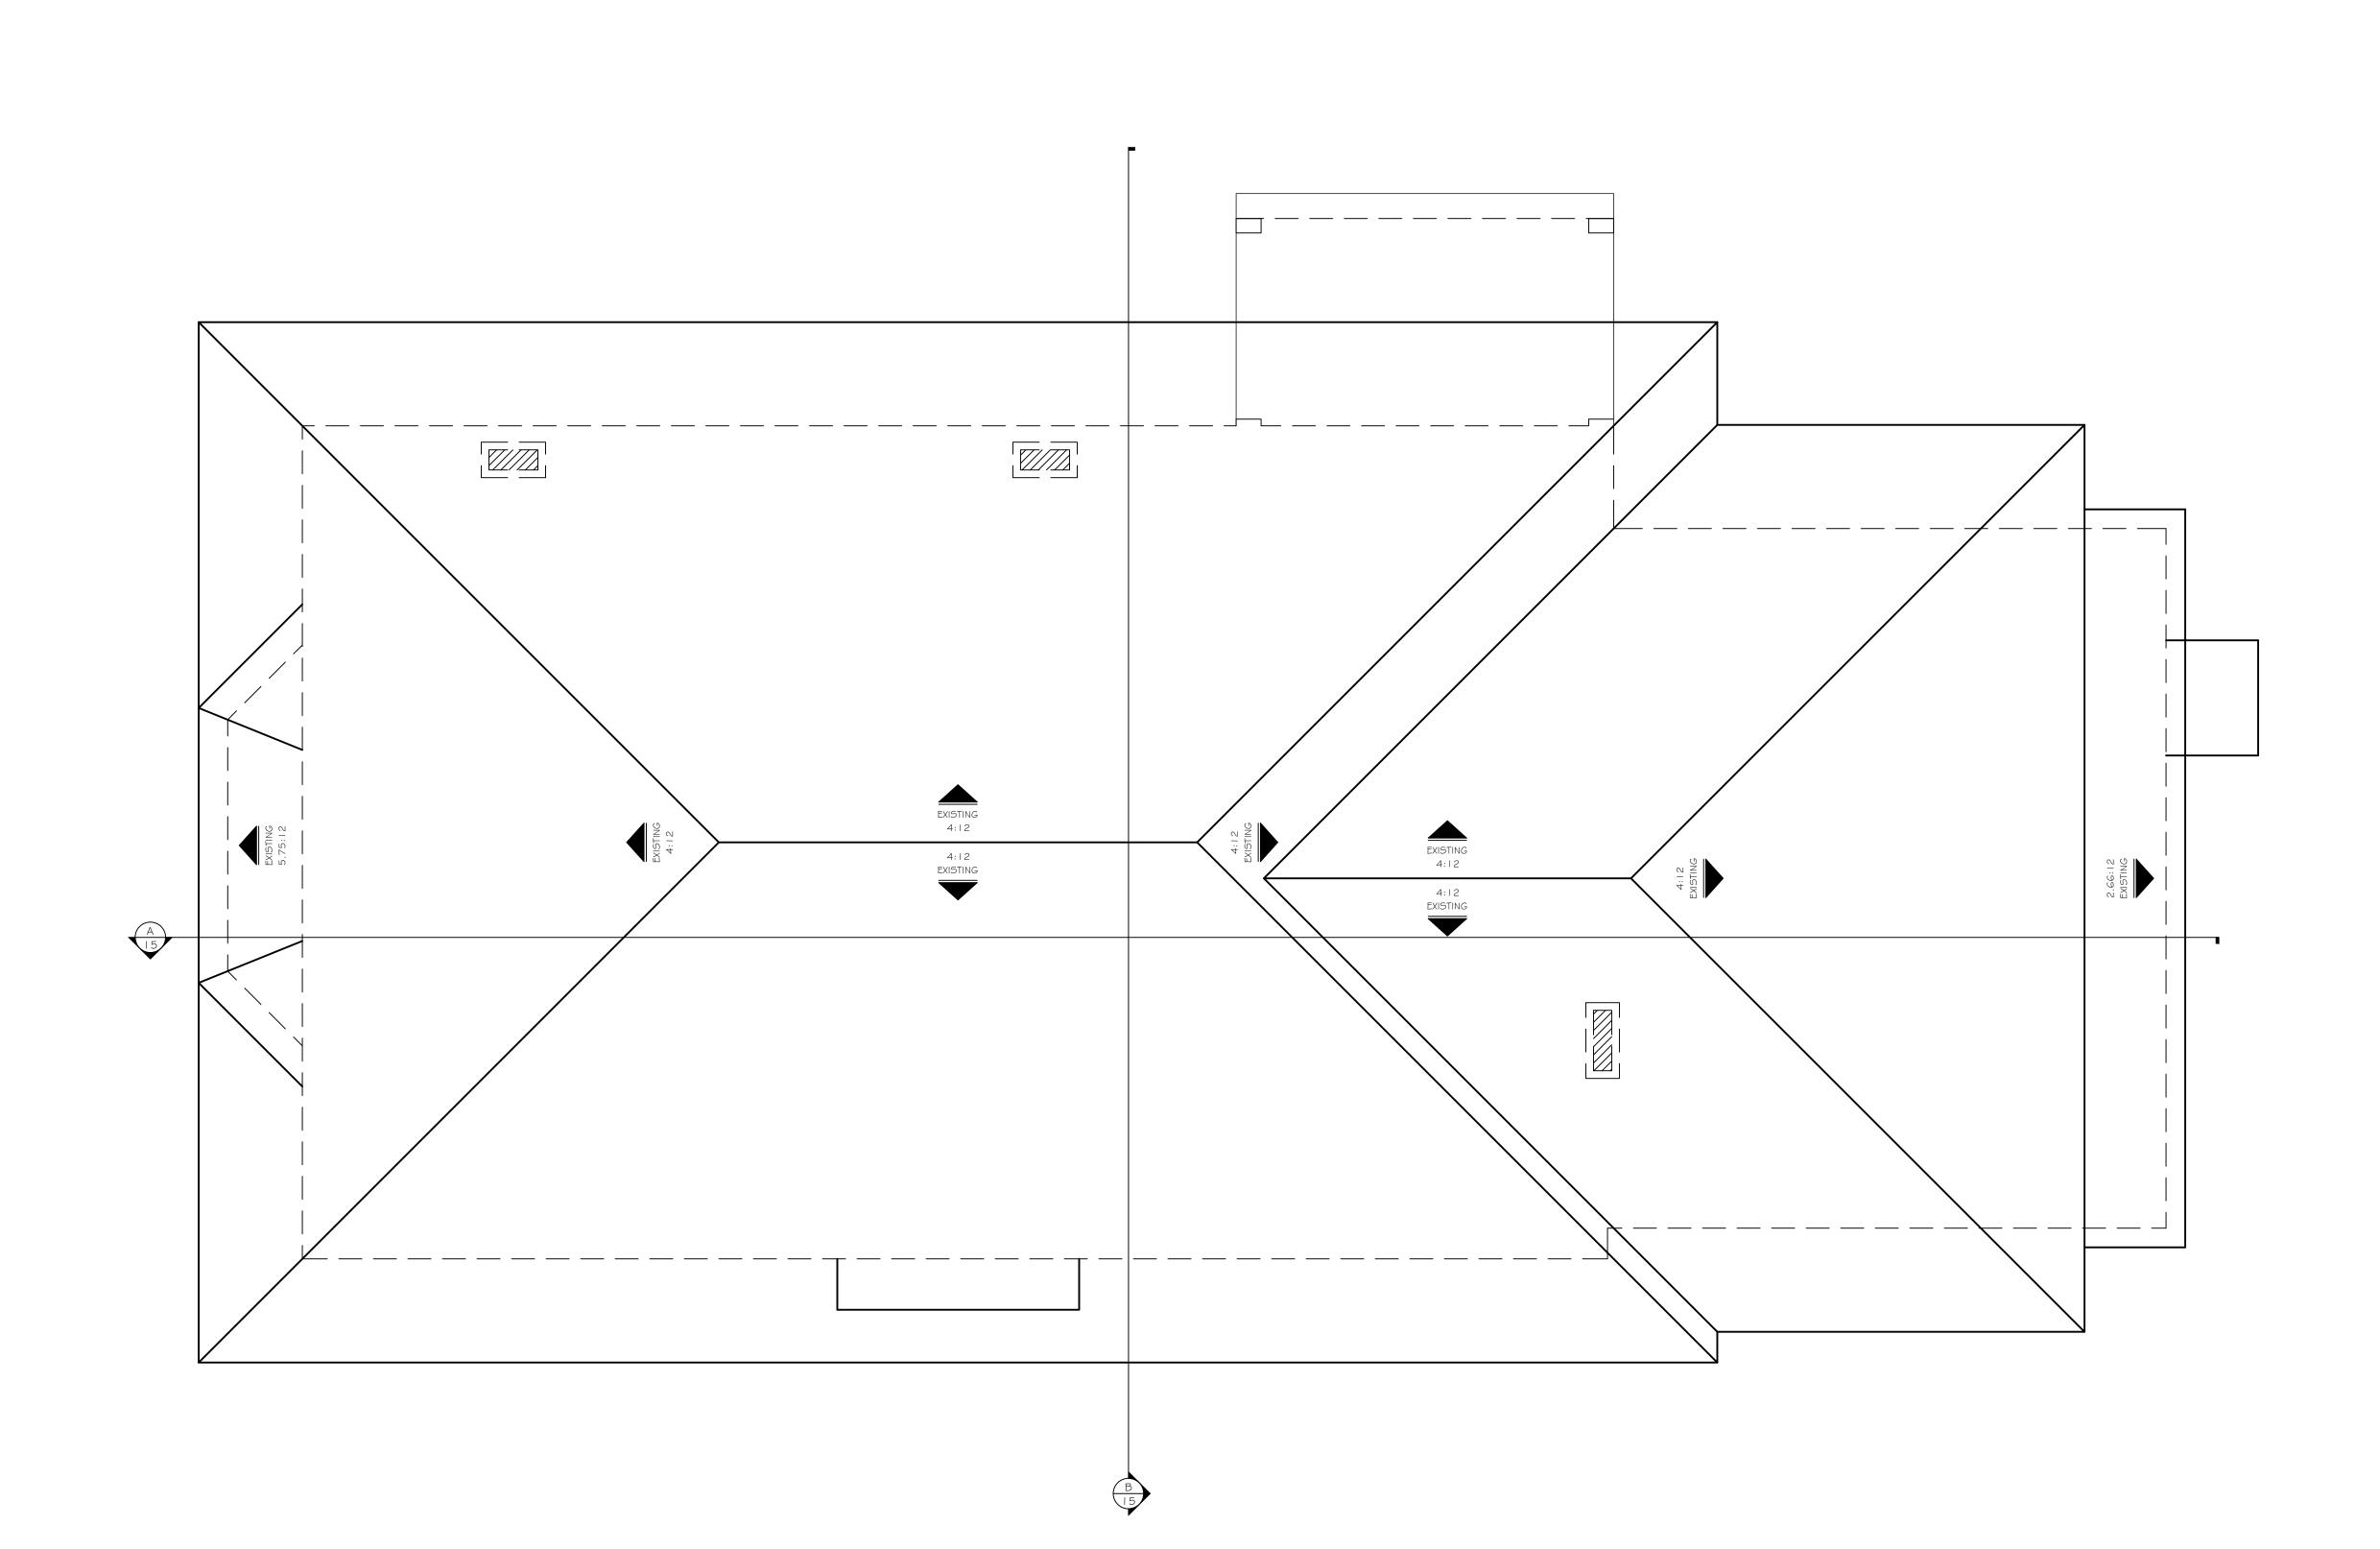





MEASUREMENTS 3626 E. PACIFIC COAST HIGHWAY | 2ND FLOOR LONG BEACH CA | 90804 T 562.621.9100 F 888.698.2966 WWW.PPMCO.NET



PRECISION PROPERTY

PREPARED FOR

ARCHITECT PLANNING

PROJECT TYPE

EXTERIOR ELEVATIONS

PROJECT NAME

RESIDENCE


PROJECT ADDRESS


1234 CHERRY TREE BOULEVARD LONG BEACH CITYSCAPE, CA 90000

All plans created by Precision Property
Measurement Ltd "PPM" are made exclusively
for landscaping purposes (Cal. Bus. 4 Prof.
Code §8727). All site plans created by PPM do not
involve the determination of any property line, and as
such do not constitute land surveying
(Cal. Bus. 4 Prof. Code §§8726-8727). In
addition, PPM services and plans do not constitute
civil engineering (Cal. Bus. 4 Prof. Code §§6702-6704),
and thus should not be used for any studies or activities
defined as civil engineering (Cal. Bus. 4 Prof. Code
§6731). All floor plans created by PPM are intended to
be used as a reference for design and construction and
should not be considered a substitute for the services of
a licensed structural engineer or licensed architect. PPM
makes every reasonable effort to ensure the accuracy of
the information found in our plans. However, every
As-Built drawing inherently contains errors to some
degree. It is the duty of the architect, contractor,
designer or other licensed professional, as a consultant
to the property owner, to determine the suitability of the
As-Built plans prior to construction. Measurements should
be field confirmed before commencing construction. in the
event that an error is found on a plan, PPM's liability is
limited to the amount of the fee paid to PPM.

 $\frac{1}{4}$ " = 1'-0" PROJECT 12345 APPROVED BY CT DATE

9/18/19 16 of 17

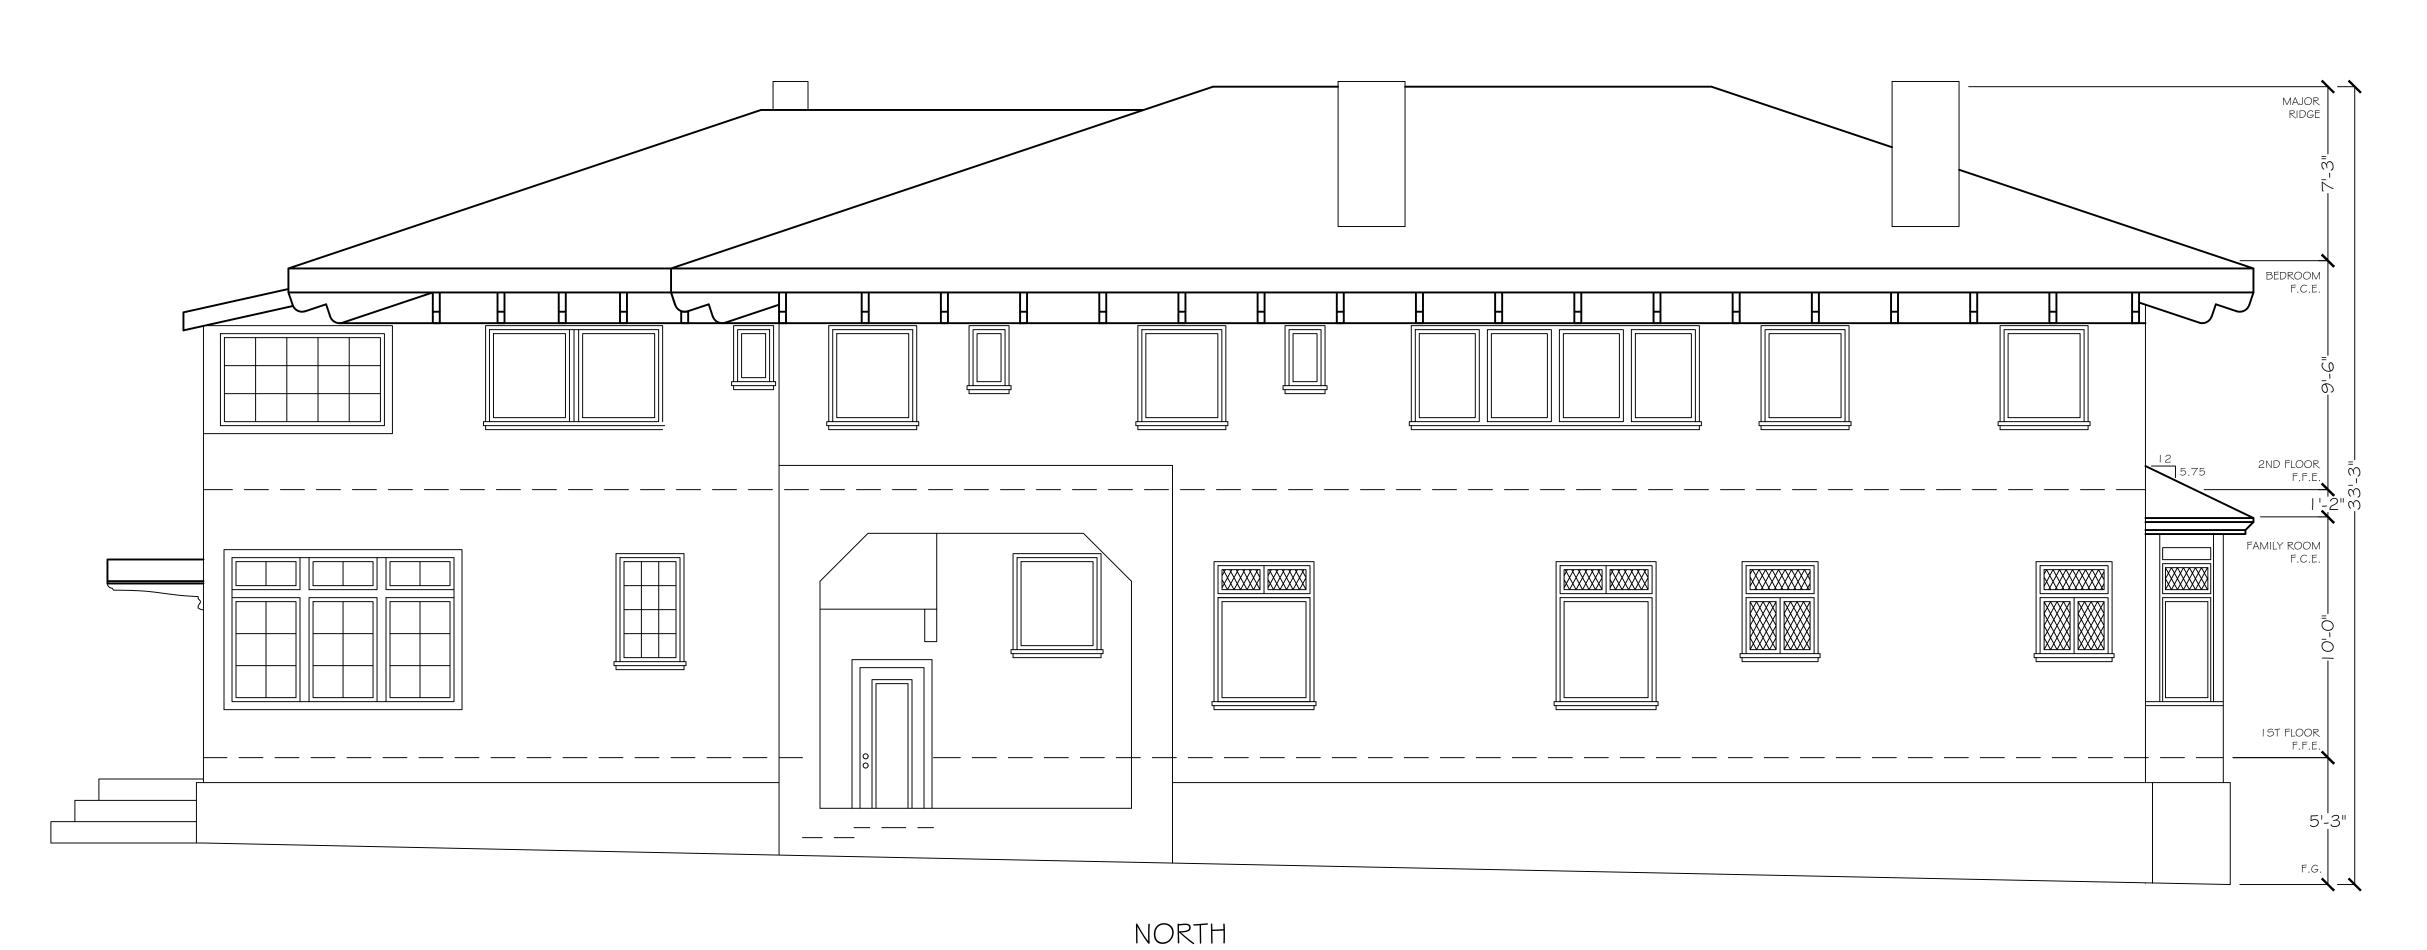


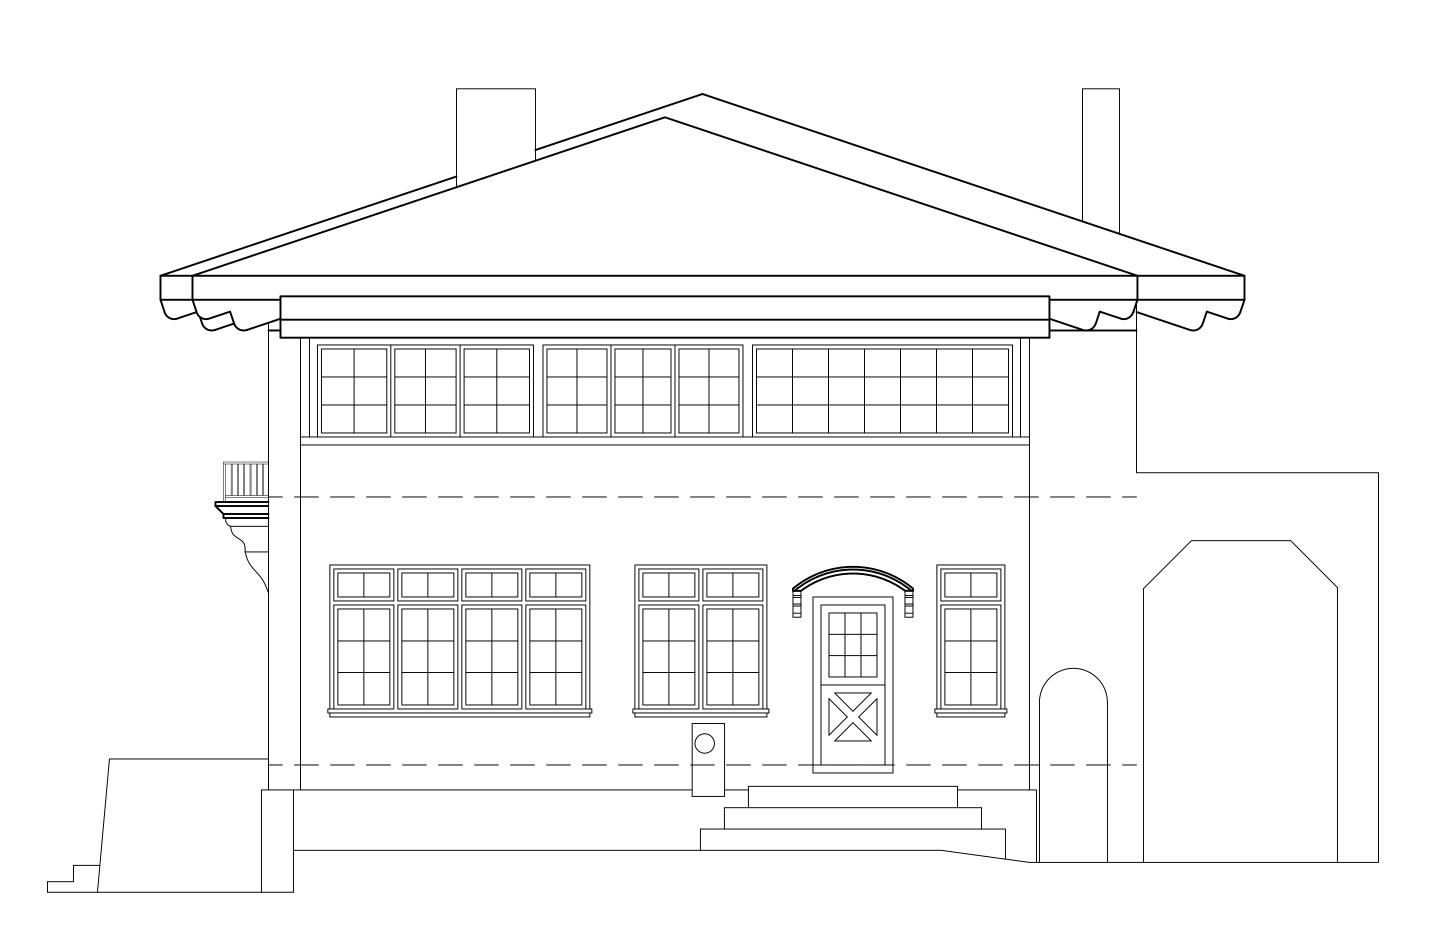





SOUTH

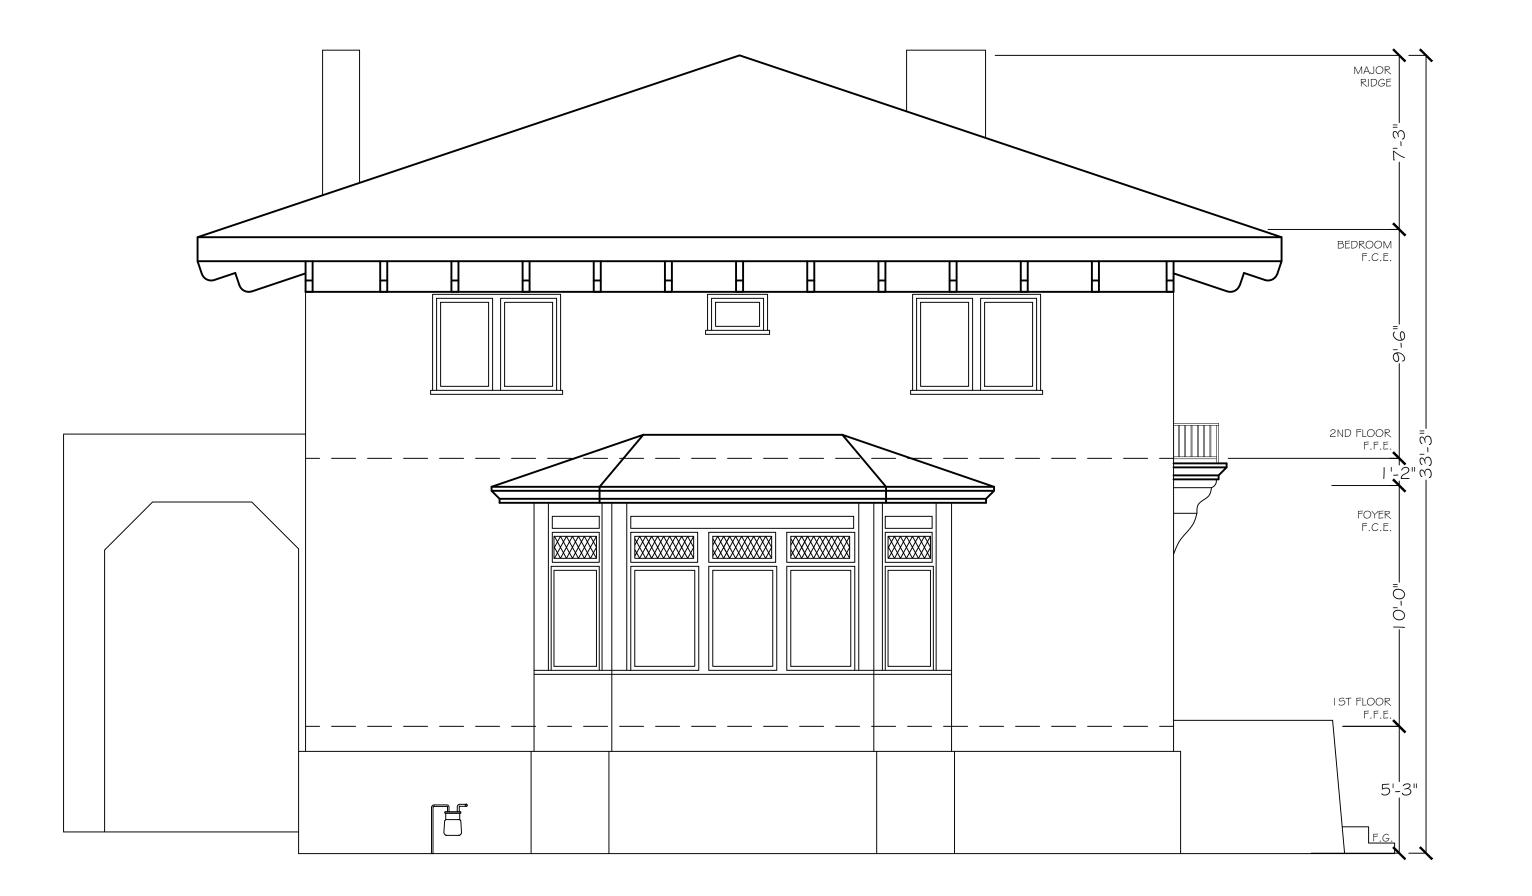

PRECISION PROPERTY

PRECISION PROPE MEASUREMENTS

3626 E. PACIFIC COAST HIGHWAY | 2ND FLOOR LONG BEACH CA | 90804 T 562.621.9100 F 888.698.2966 WWW.PPMCO.NET



PREPARED FOR

ARCHITECT PLANNING

PROJECT TYPE

EXTERIOR ELEVATIONS

PROJECT NAME

SMITH RESIDENCE

PROJECT ADDRESS

I 234 CHERRY TREE BOULEVARD LONG BEACH CITYSCAPE, CA 90000

All plans created by Precision Property
Measurement Ltd "PPM" are made exclusively
for landscaping purposes (Cal. Bus. \$ Prof.
Code §8727). All site plans created by PPM do not
involve the determination of any property line, and as
such do not constitute land surveying
(Cal. Bus. \$ Prof. Code §86726-8727). In
addition, PPM services and plans do not constitute
civil engineering (Cal. Bus. \$ Prof. Code §§6702-6704),
and thus should not be used for any studies or activities
defined as civil engineering (Cal. Bus. \$ Prof. Code
§6731). All floor plans created by PPM are intended to
be used as a reference for design and construction and
should not be considered a substitute for the services of
a licensed structural engineer or licensed architect. PPM
makes every reasonable effort to ensure the accuracy of
the information found in our plans. However, every
As-Built drawing inherently contains errors to some
degree. It is the duty of the architect, contractor,
designer or other licensed professional, as a consultant
to the property owner, to determine the suitability of the
As-Built plans prior to construction. Measurements should
be field confirmed before commencing construction. in the
event that an error is found on a plan, PPMs liability is
limited to the amount of the fee paid to PPM.

SCALE

|_4" = 1'-0"

PROJECT

| 2345


APPROVED BY

CT


DATE

9/18/19 SHEET

17 of 17

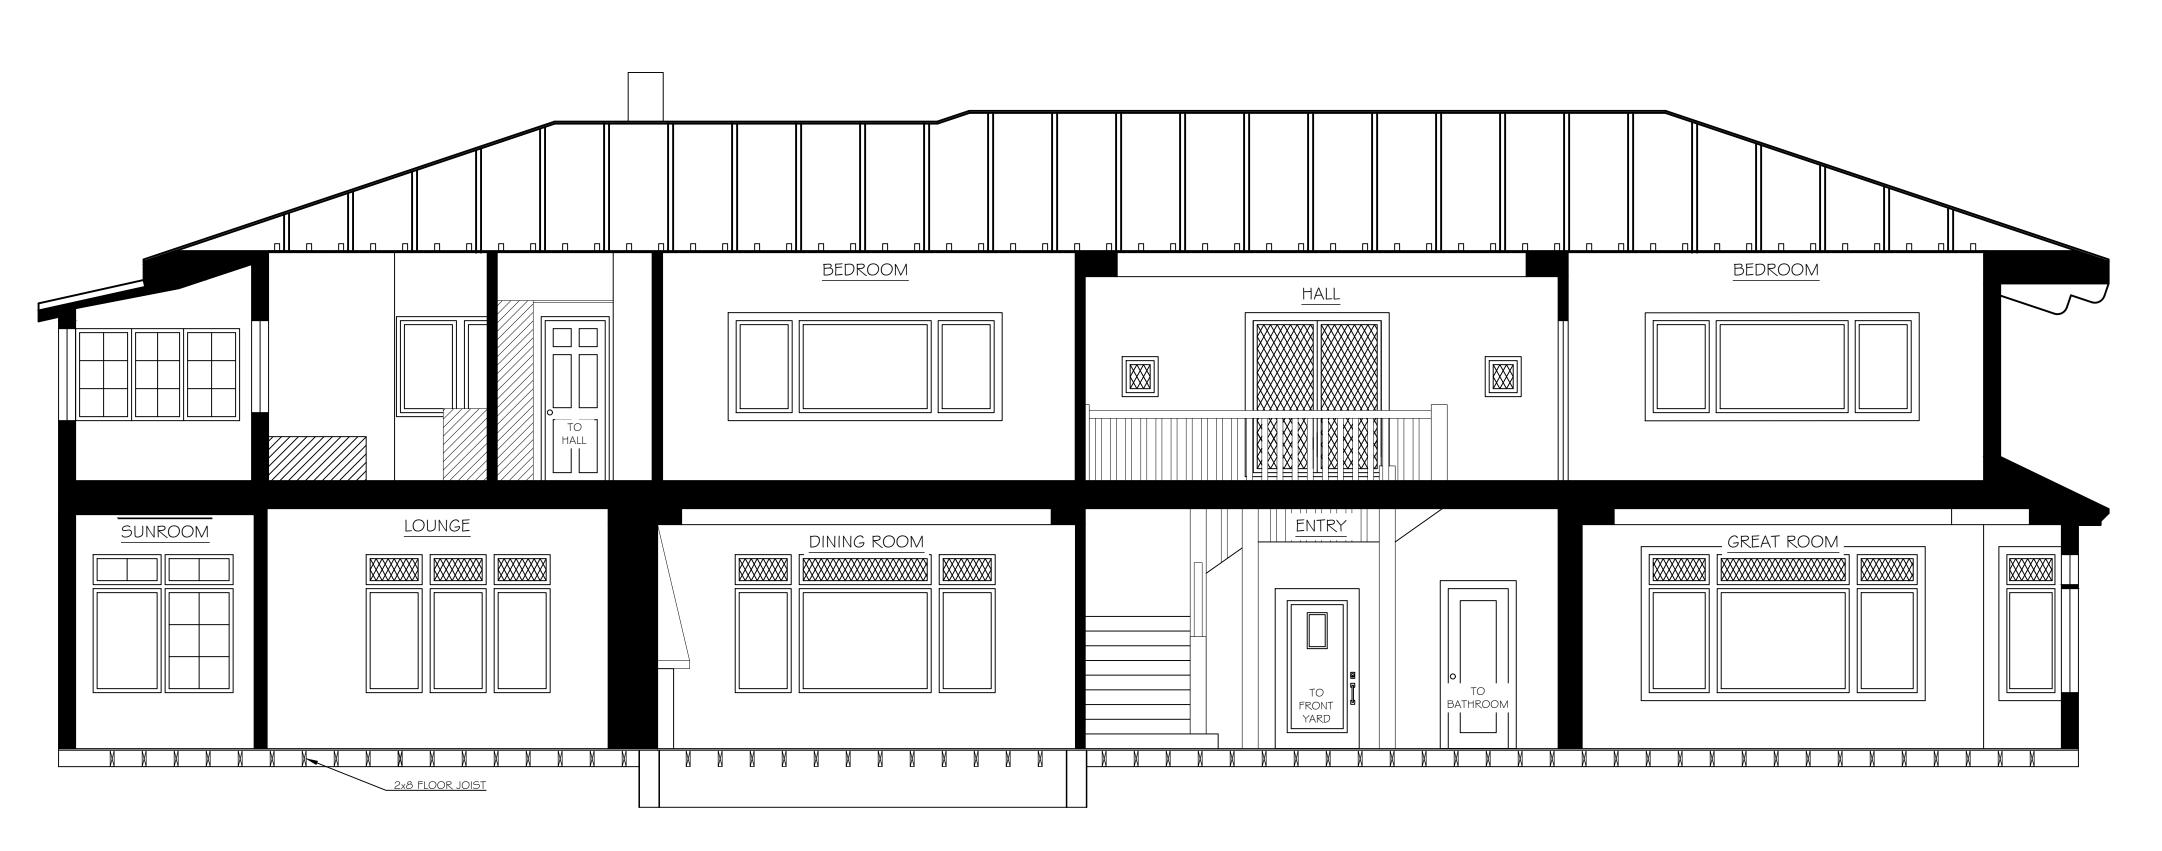



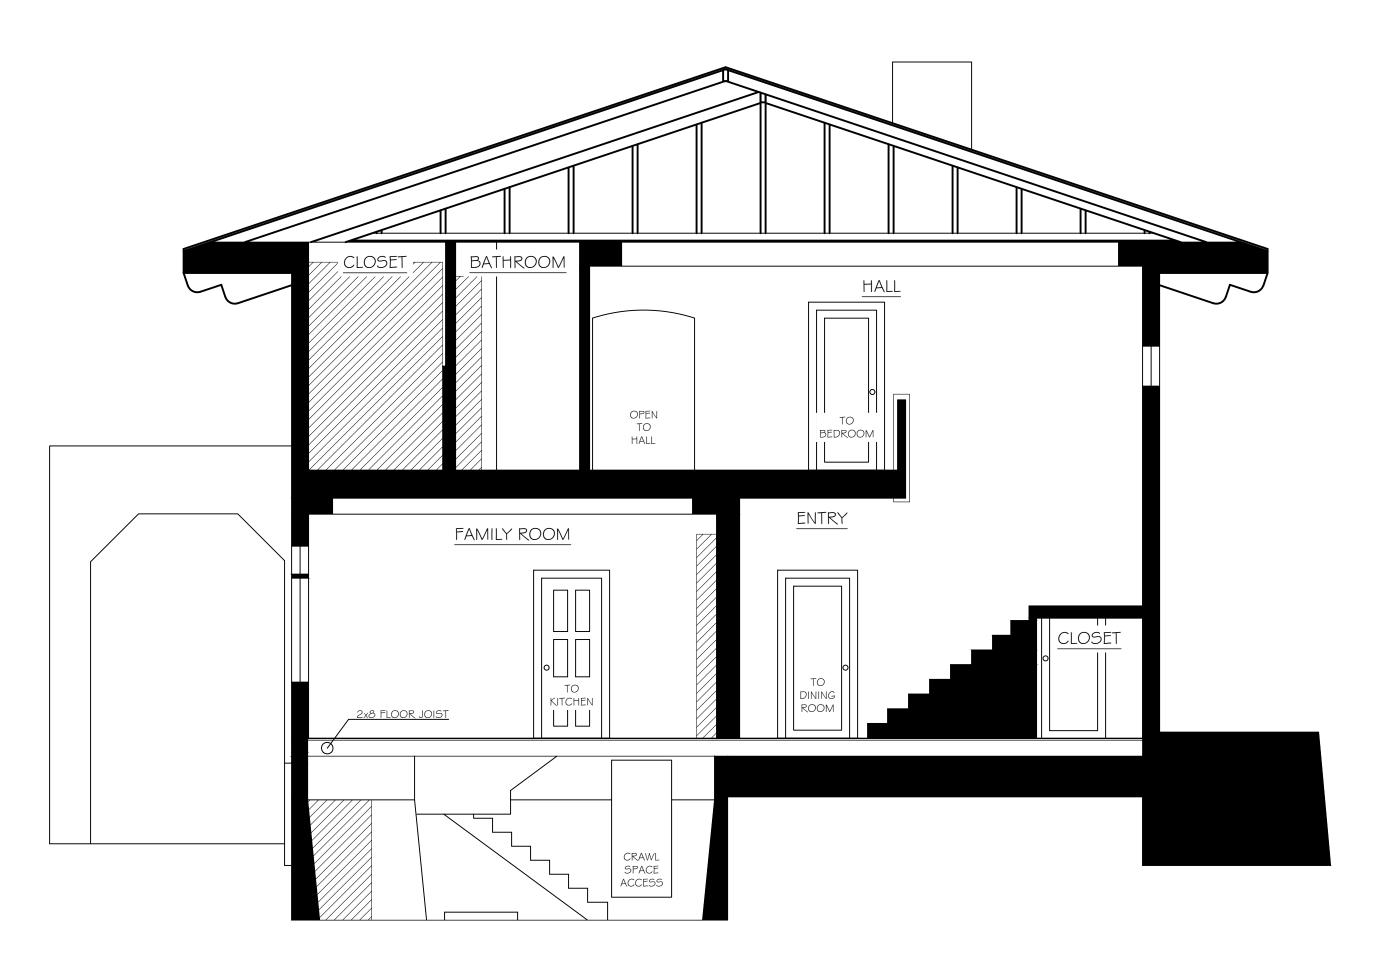

B SECTION

PPM

PRECISION PROPERTY MEASUREMENTS

3626 E. PACIFIC COAST HIGHWAY | 2ND FLOOR LONG BEACH CA | 90804 T 562.621.9100 F 888.698.2966 WWW.PPMCO.NET



PREPARED FOR

ARCHITECT PLANNING

PROJECT TYPE

SECTIONS

PROJECT NAME

SMITH RESIDENCE

PROJECT ADDRESS

I 234 CHERRY TREE BOULEVARD LONG BEACH, CA 90000

All plans created by Precision Property
Measurement Ltd "PPM" are made exclusively
for landscaping purposes (Cal. Bus. 4 Prof.
Code §8727). All site plans created by PPM do not
involve the determination of any property line, and as
such do not constitute land surveying
(Cal. Bus. 4 Prof. Code §§8726-8727). In
addition, PPM services and plans do not constitute
civil engineering (Cal. Bus. 4 Prof. Code §§6702-6704),
and thus should not be used for any studies or activities
defined as civil engineering (Cal. Bus. 4 Prof. Code
§6731). All floor plans created by PPM are intended to
be used as a reference for design and construction and
should not be considered a substitute for the services of
a licensed structural engineer or licensed architect. PPM
makes every reasonable effort to ensure the accuracy of
the information found in our plans. However, every
As-Built drawing inherently contains errors to some
degree. It is the duty of the architect, contractor,
designer or other licensed professional, as a consultant
to the property owner, to determine the suitability of the
As-Built plans prior to construction. Measurements should
be field confirmed before commencing construction. in the
event that an error is found on a plan, PPM's liability is
limited to the amount of the fee paid to PPM.


SCALE $\frac{1}{4}'' = 1'-0''$ PROJECT 12345APPROVED BY CT

APPROVED BY
CT

DATE

9/18/19 SHEET

15 of 17

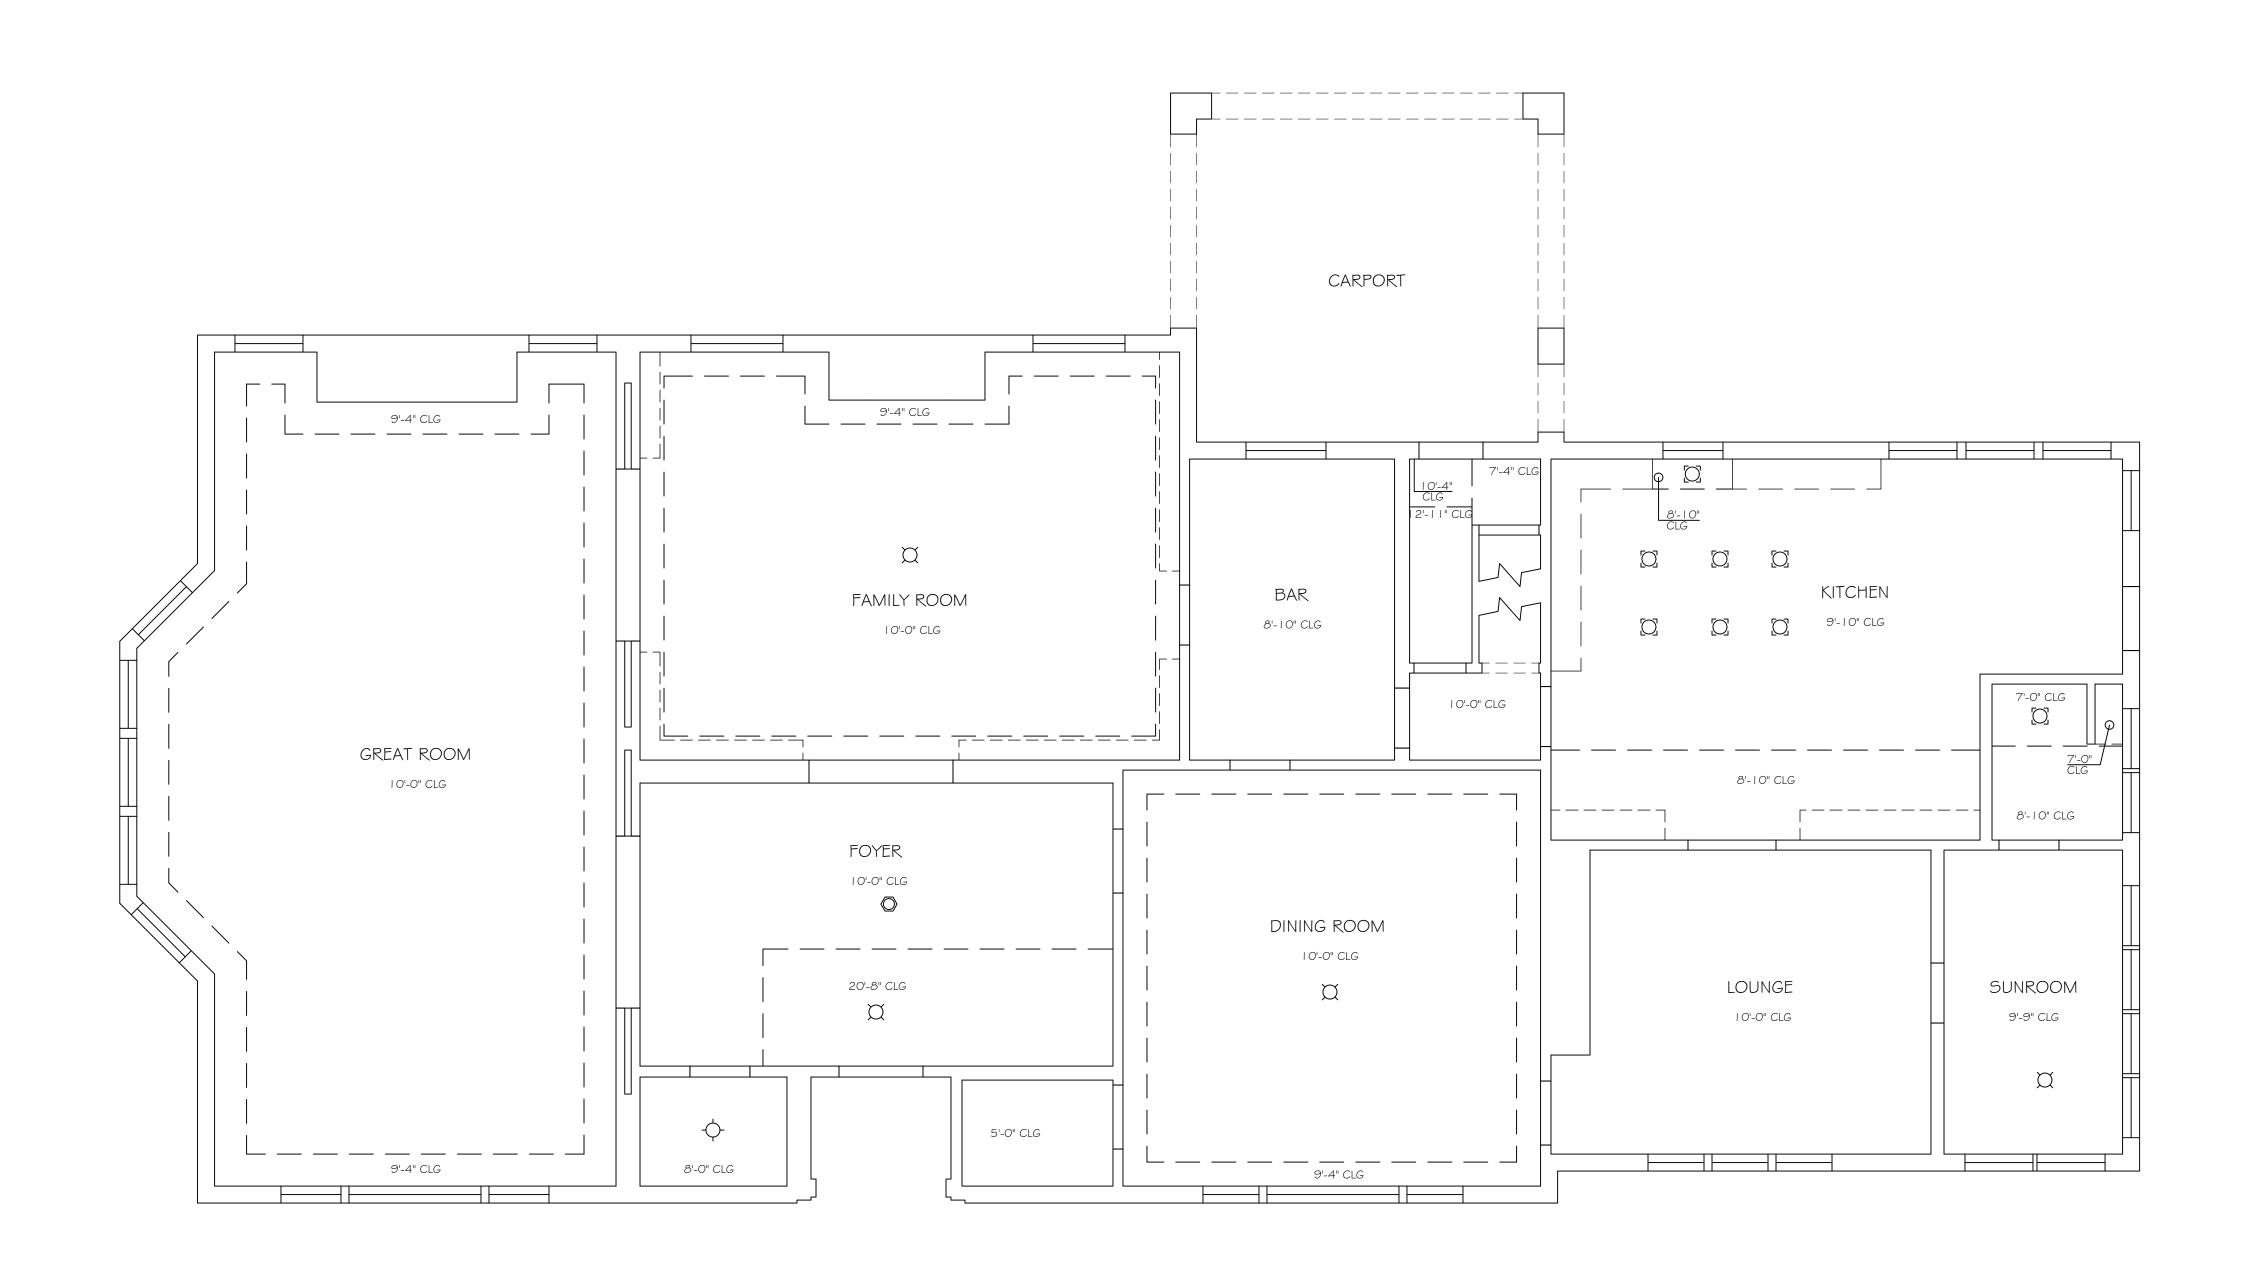



____ __ ___ ___ ___ SOFFIT

- = CEILING DUPLEX
- # = CEILING QUADRUPLEX SPEAKER
- = SQUARE SPEAKER
- ∮ = EXHAUST FAN w/ LIGHT 💠 = CEILING FAN W/o LIGHT
- = CEILING FAN w/ LIGHT = FLUORESCENT LIGHTING
- •• = TRACK LIGHTING
- 🗯 = RECESSED FIXTURE
- x = HANGING FIXTURE⊢O = WALL MOUNTED FIXTURE
- ζ = EXTERIOR WALL LIGHT

- O = DOME SECURITY CAMERA
- = COVER PLATE ■ SUPPLY VENT
- = RETURN VENT
- \bigcirc = ROUND SUPPLY VENT
- = EQUALIZER GRILLE = ROOF HATCH
- = SMOKE ALARM EXIT = EXIT SIGN
- = EMERGENCY LIGHT w/ EXIT
- = EMERGENCY LIGHT
 = SPRINKLER



PRECISION PROPERTY **MEASUREMENTS**

WWW.PPMCO.NET

3626 E. PACIFIC COAST HIGHWAY | 2ND FLOOR LONG BEACH CA | 90804 T 562.621.9100 F 888.698.2966



PREPARED FOR

ARCHITECT PLANNING

PROJECT TYPE

REFLECTED CEILING PLAN


PROJECT NAME

SMITH RESIDENCE

PROJECT ADDRESS

1234 CHERRY TREE BOULEVARD LONG BEACH CITYSCAPE, CA 90000

All plans created by Precision Property
Measurement Ltd "PPM" are made exclusively
for landscaping purposes (Cal. Bus. 4 Prof.
Code §8727). All site plans created by PPM do not
involve the determination of any property line, and as
such do not constitute land surveying
(Cal. Bus. 4 Prof. Code §§8726-6727). In
addition, PPM services and plans do not constitute
civil engineering (Cal. Bus. 4 Prof. Code §§6702-6704),
and thus should not be used for any studies or activities
defined as civil engineering (Cal. Bus. 4 Prof. Code
§6731). All floor plans created by PPM are intended to
be used as a reference for design and construction and
should not be considered a substitute for the services of
a licensed structural engineer or licensed architect. PPM
makes every reasonable effort to ensure the accuracy of
the information found in our plans. However, every
As-Built drawing inherently contains errors to some
degree. It is the duty of the architect, contractor,
designer or other licensed professional, as a consultant
to the property owner, to determine the suitability of the
As-Built plans prior to construction. Measurements should
be field confirmed before commencing construction. In the
event that an error is found on a plan, PPMs liability is
limited to the amount of the fee paid to PPM.

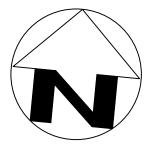

 $\frac{1}{4}$ " = 1'-0"


PROJECT 12345

APPROVED BY CT

DATE

9/18/19

10 of 17

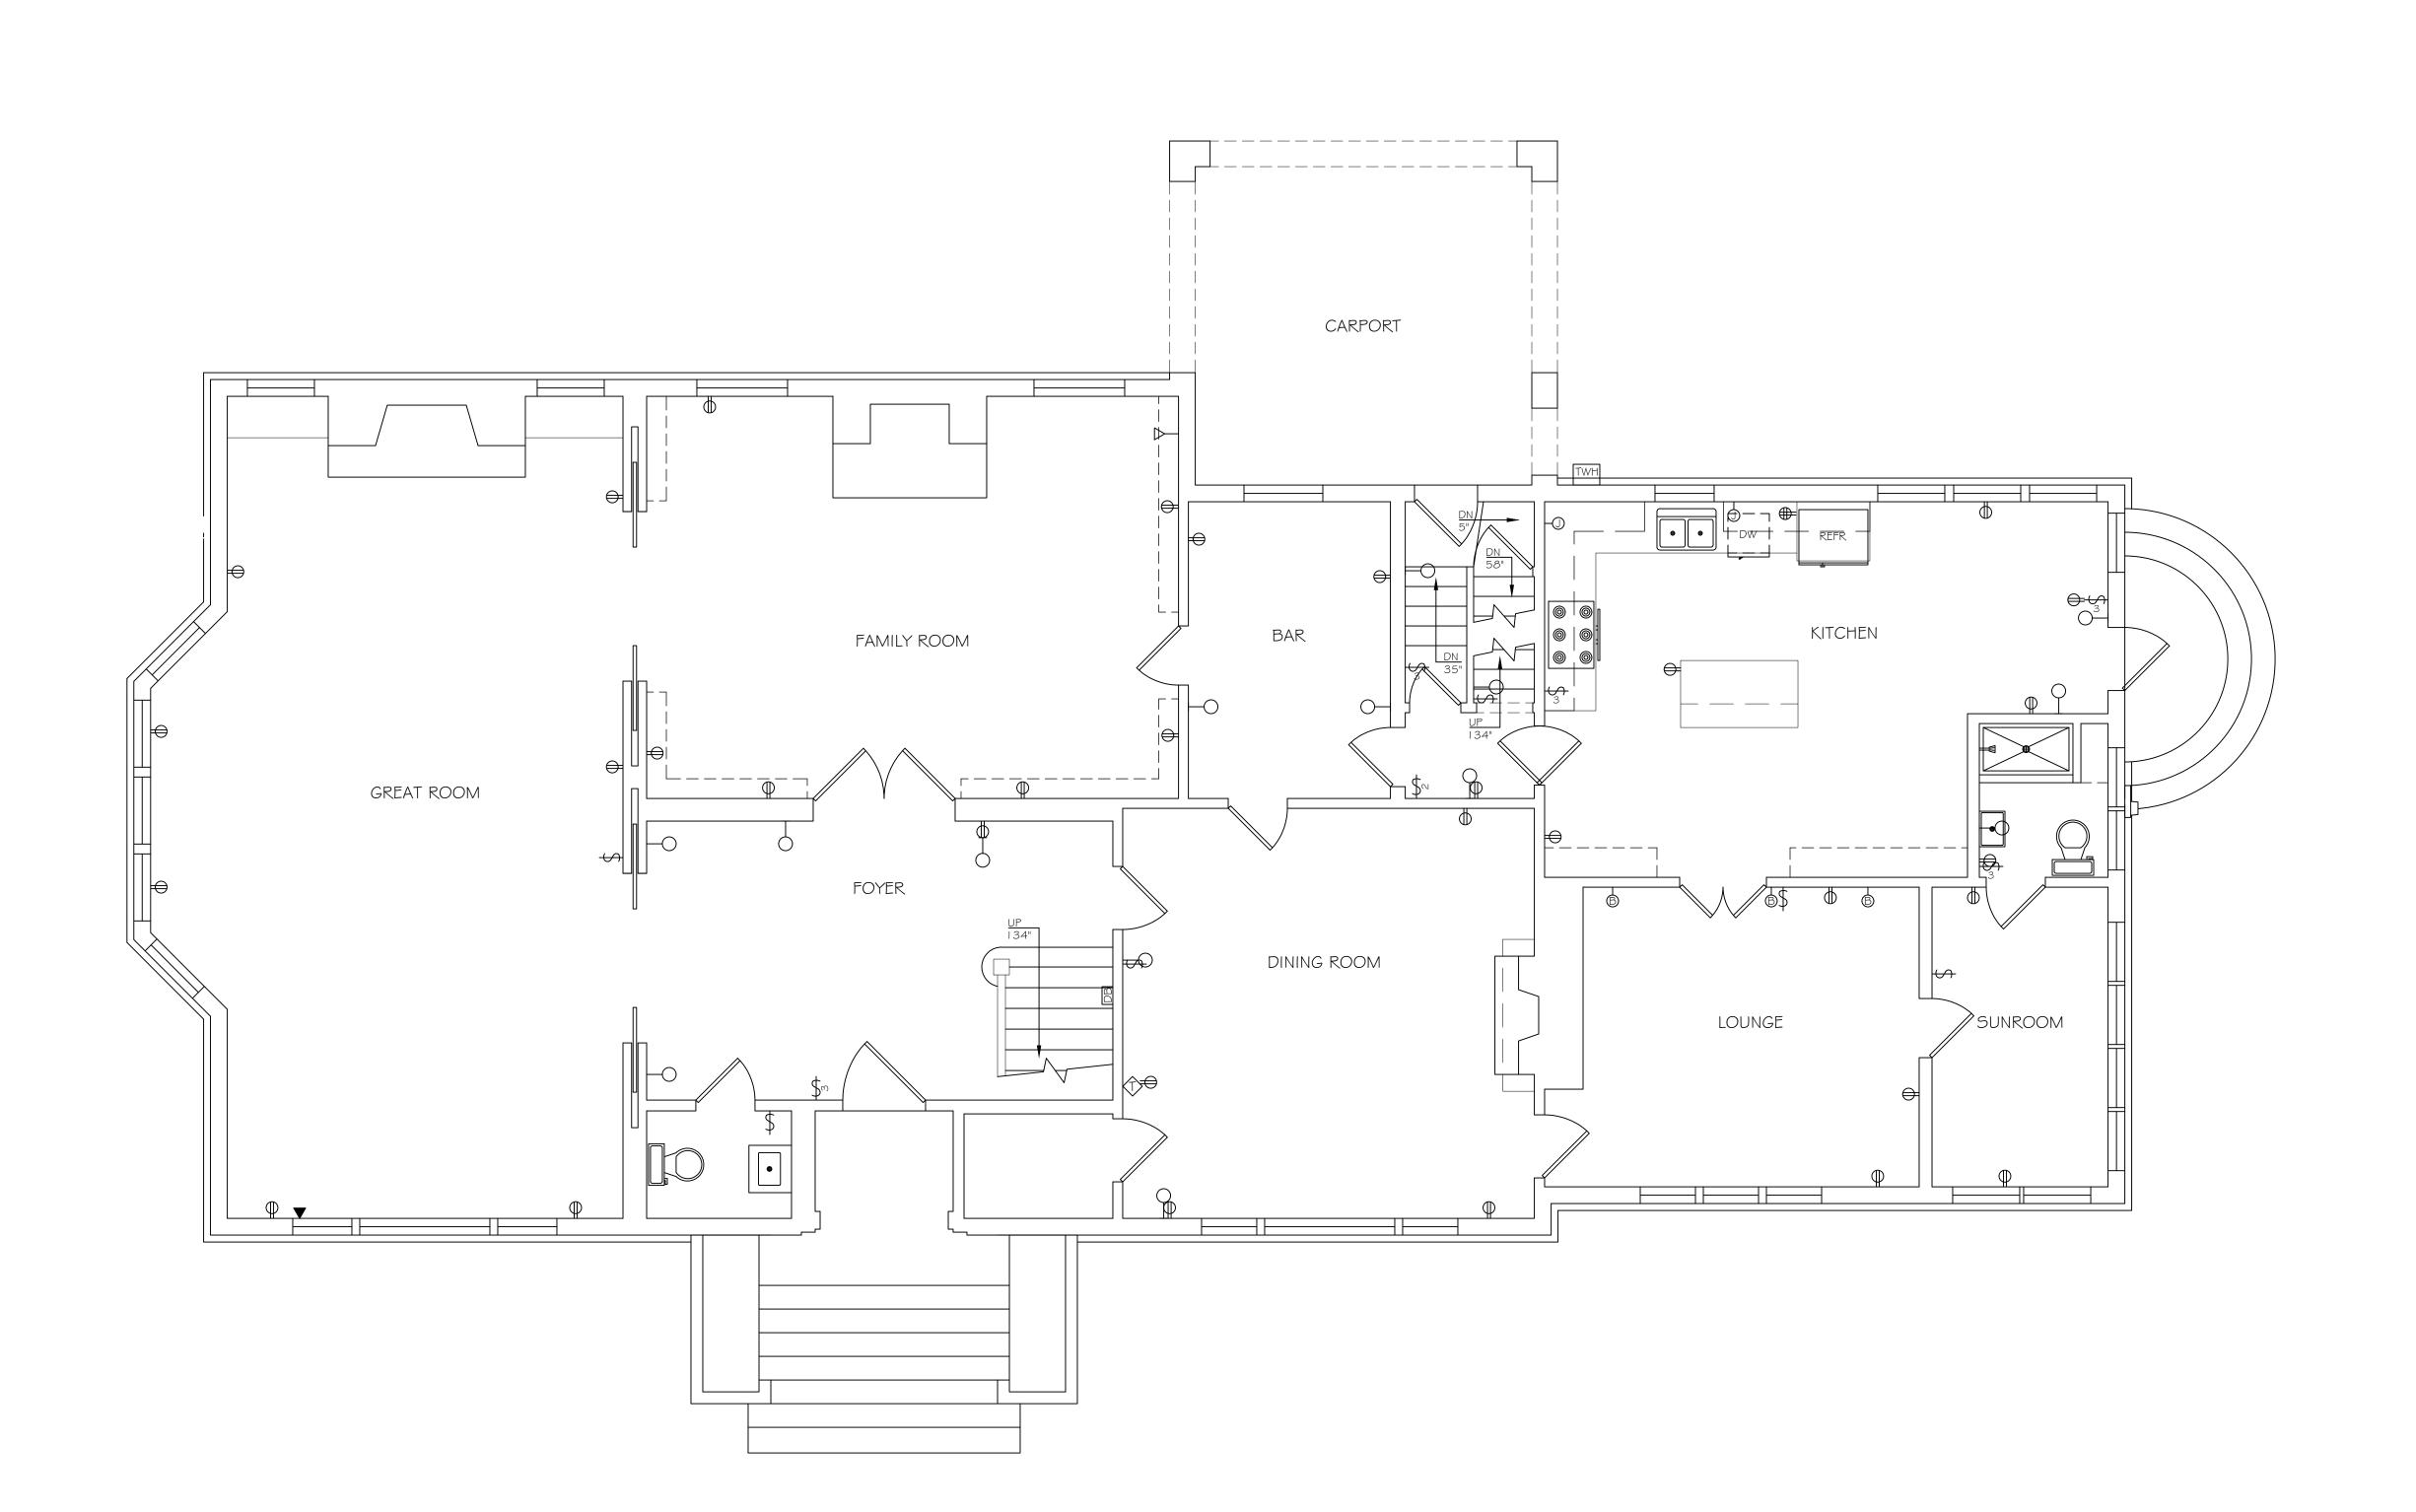



- ← = SWITCH
- → = SINGLE OUTLET
- ⇒ = DUPLEX OUTLET

 ⇒ = QUADRUPLEX OUTLET
- **⊕** = 220V OUTLET
- = FLOOR DUPLEX OUTLET
- = SPECIAL PURPOSE OUTLET
 -□ = WALL MOUNT CAMERA
- -⊗ = COVER PLATE ON WALL
- -⊕ = THERMOSTAT -⊕ = AUDIO VOLUME CONTROLS
- SPEAKER WALL
- ☐ = DISCONNECT SWITCH
- → = WALL-MOUNTED FIXTURE == FLUORESCENT LIGHT - WALL
- = ELECTRICAL PANEL FLUSH = ELECTRICAL PANEL - MOUNTED
- TELEPHONE JACK
- → = CABLE JACK■ = DATA/INTERNET JACK
- POWER POLE
- -® = BLANK -® = AUDIO / VIDEO
- -0 = ROUTER
- -Ø = SECURITY KEY PAD-Ø = REMOTE DOOR RELEASE
- -S = SENSOR
- -⊚ = CONDUIT
- **-○** = J-BOX



PRECISION PROPERTY MEASUREMENTS

WWW.PPMCO.NET

3626 E. PACIFIC COAST HIGHWAY | 2ND FLOOR LONG BEACH CA | 90804 T 562.621.9100 F 888.698.2966



PREPARED FOR

ARCHITECT PLANNING

PROJECT TYPE

ELECTRICAL PLAN


PROJECT NAME

SMITH RESIDENCE

PROJECT ADDRESS

I 234 CHERRY TREE BOULEVARD LONG BEACH, CA 90000

All plans created by Precision Property
Measurement Ltd "PPM" are made exclusively
for landscaping purposes (Cal. Bus. 4 Prof.
Code \$6727). All site plans created by PPM do not
involve the determination of any property line, and as
such do not constitute land surveying
(Cal. Bus. 4 Prof. Code \$58726-8727). In
addition, PPM services and plans do not constitute
civil engineering (Cal. Bus. 4 Prof. Code \$56702-6704),
and thus should not be used for any studies or activities
defined as civil engineering (Cal. Bus. 4 Prof. Code
\$6731). All floor plans created by PPM are intended to
be used as a reference for design and construction and
should not be considered a substitute for the services of
a licensed structural engineer or licensed architect. PPM
makes every reasonable effort to ensure the accuracy of
the information found in our plans. However, every
As-Built drawing inherently contains errors to some
degree. It is the duty of the architect, contractor,
designer or other licensed professional, as a consultant
to the property owner, to determine the suitability of the
As-Built plans prior to construction. Measurements should
be field confirmed before commencing construction. in the
event that an error is found on a plan, PPMS liability is

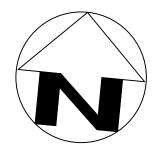

SCALE
/4" = | '-0"


PROJECT I 2345

APPROVED BY CT

DATE

9/18/19 SHEET

7 of 17

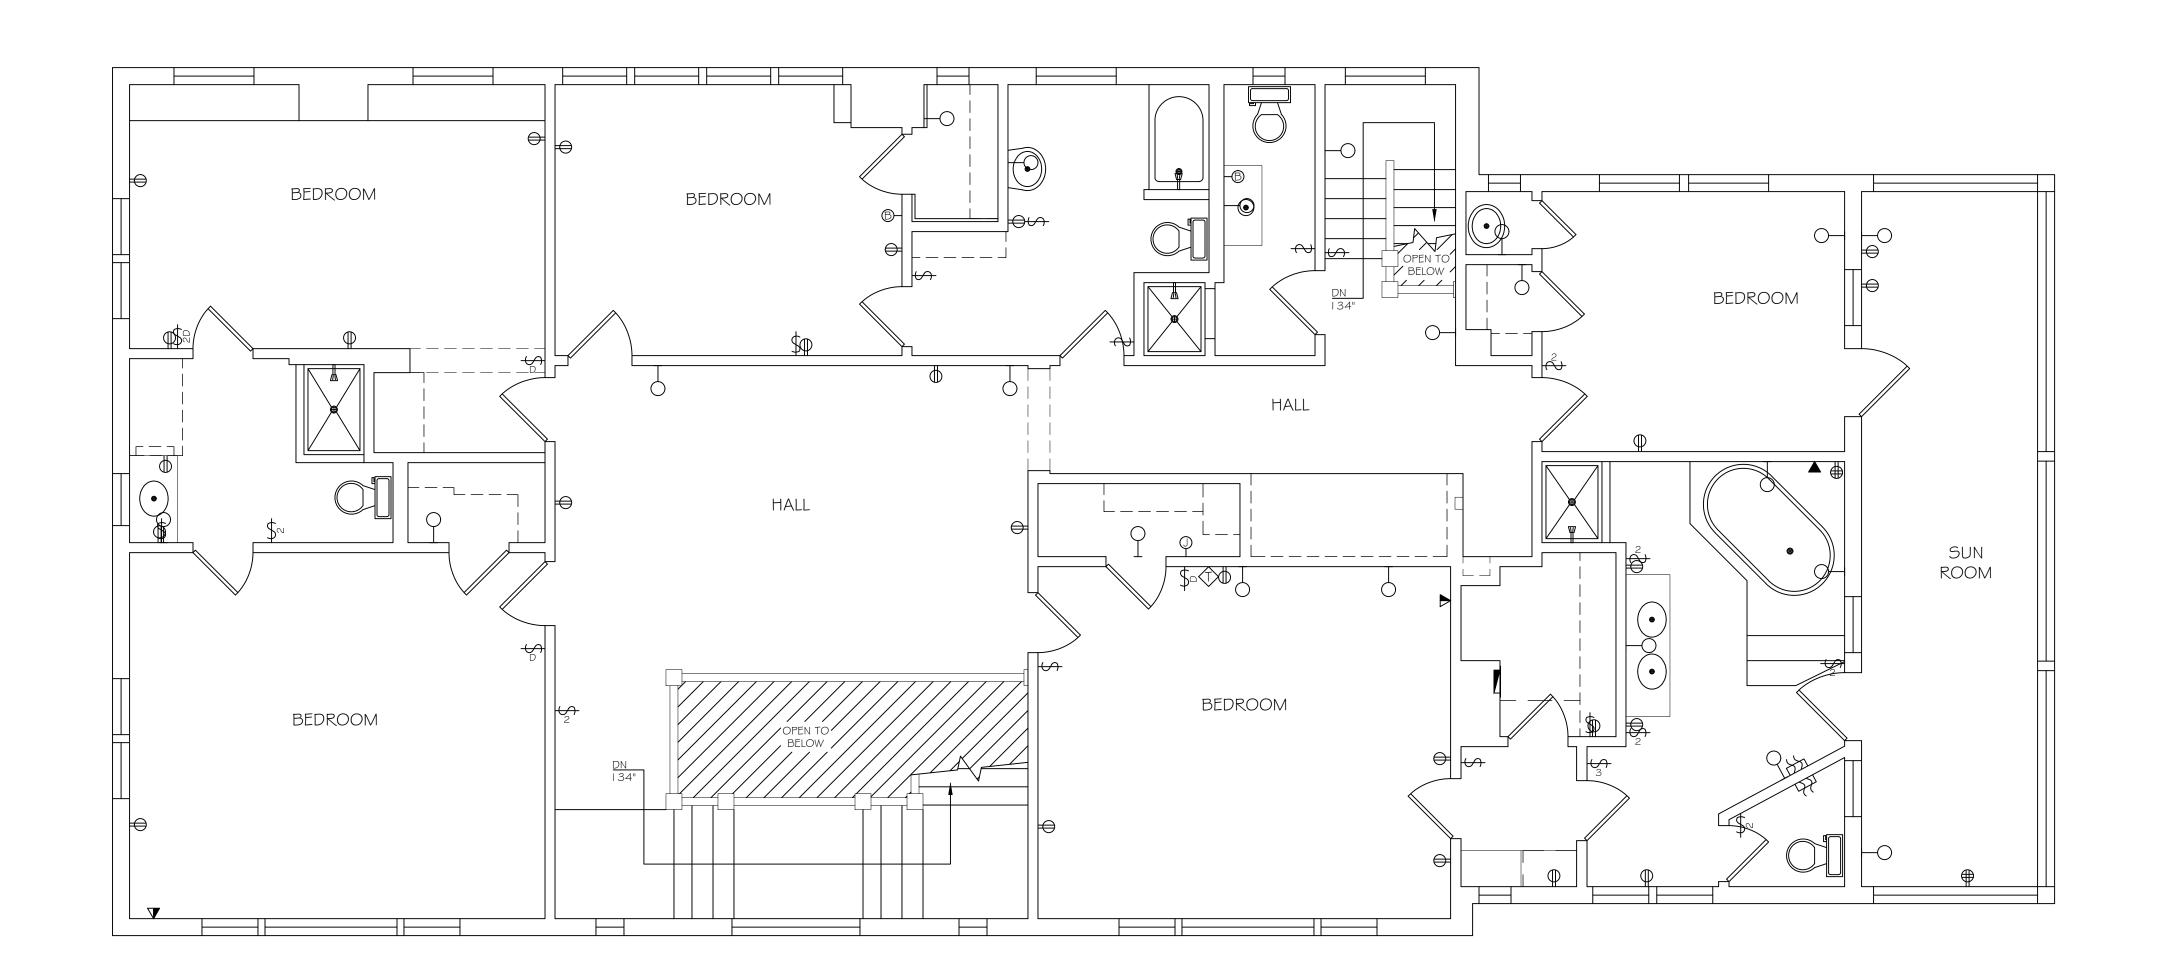

LEGEND

- ← SWITCH
- \rightarrow = SINGLE OUTLET
- ⇒ = DUPLEX OUTLET
- = QUADRUPLEX OUTLET ⇒ = 220V OUTLET
- 😝 = FLOOR DUPLEX OUTLET
- # = FLOOR QUADRUPLEX OUTLET == GFCI DUPLEX OUTLET
- =⊖ = SPECIAL PURPOSE OUTLET
- -□4 = WALL MOUNT CAMERA -⊗= COVER PLATE ON WALL
- $-\bigcirc$ = THERMOSTAT -∅ = AUDIO VOLUME CONTROLS
- $-\bigcirc$ = SPEAKER WALL □¬ = DISCONNECT SWITCH
- ⊢O = WALL-MOUNTED FIXTURE
- == FLUORESCENT LIGHT WALL = ELECTRICAL PANEL - FLUSH
- = ELECTRICAL PANEL MOUNTED ■ TELEPHONE JACK
- DATA/INTERNET JACK -Ø = CABLE TV JACK
- POWER POLE -® = BLANK
- -⊚ = AUDIO / VIDEO
- -® = ROUTER -**⊘** = SECURITY KEY PAD
- -® = REMOTE DOOR RELEASE
- -Ø = SENSOR
- -© = CONDUIT
- **-** = J-BOX



PRECISION PROPERTY **MEASUREMENTS**

3626 E. PACIFIC COAST HIGHWAY | 2ND FLOOR LONG BEACH CA | 90804 T 562.621.9100 F 888.698.2966 WWW.PPMCO.NET



PREPARED FOR

ARCHITECT PLANNING

PROJECT TYPE

ELECTRICAL PLAN


PROJECT NAME

RESIDENCE

PROJECT ADDRESS

1234 CHERRY TREE BOULEVARD LONG BEACH, CA 90000

All plans created by Precision Property
Measurement Ltd "PPM" are made exclusively
for landscaping purposes (Cal. Bus. \$ Prof.
Code §6727). All site plans created by PPM do not
involve the determination of any property line, and as
such do not constitute land surveying
(Cal. Bus. \$ Prof. Code §86726-8727). In
addition, PPM services and plans do not constitute
civil engineering (Cal. Bus. \$ Prof. Code §66727-6704),
and thus should not be used for any studies or activities
defined as civil engineering (Cal. Bus. \$ Prof. Code
§6731). All floor plans created by PPM are intended to
be used as a reference for design and construction and
should not be considered a substitute for the services of
a licensed structural engineer or licensed architect. PPM
makes every reasonable effort to ensure the accuracy of
the information found in our plans. However, every
As-Built drawing inherently contains errors to some
degree. It is the duty of the architect, contractor,
designer or other licensed professional, as a consultant
to the property owner, to determine the suitability of the
As-Built plans prior to construction. Measurements should
be field confirmed before commencing construction. in the
event that an error is found on a plan, PPMS liability is

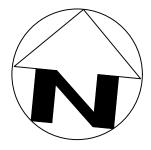

 $\frac{1}{4}$ " = 1'-0" PROJECT


12345

APPROVED BY CT

DATE

9/18/19

8 of 17

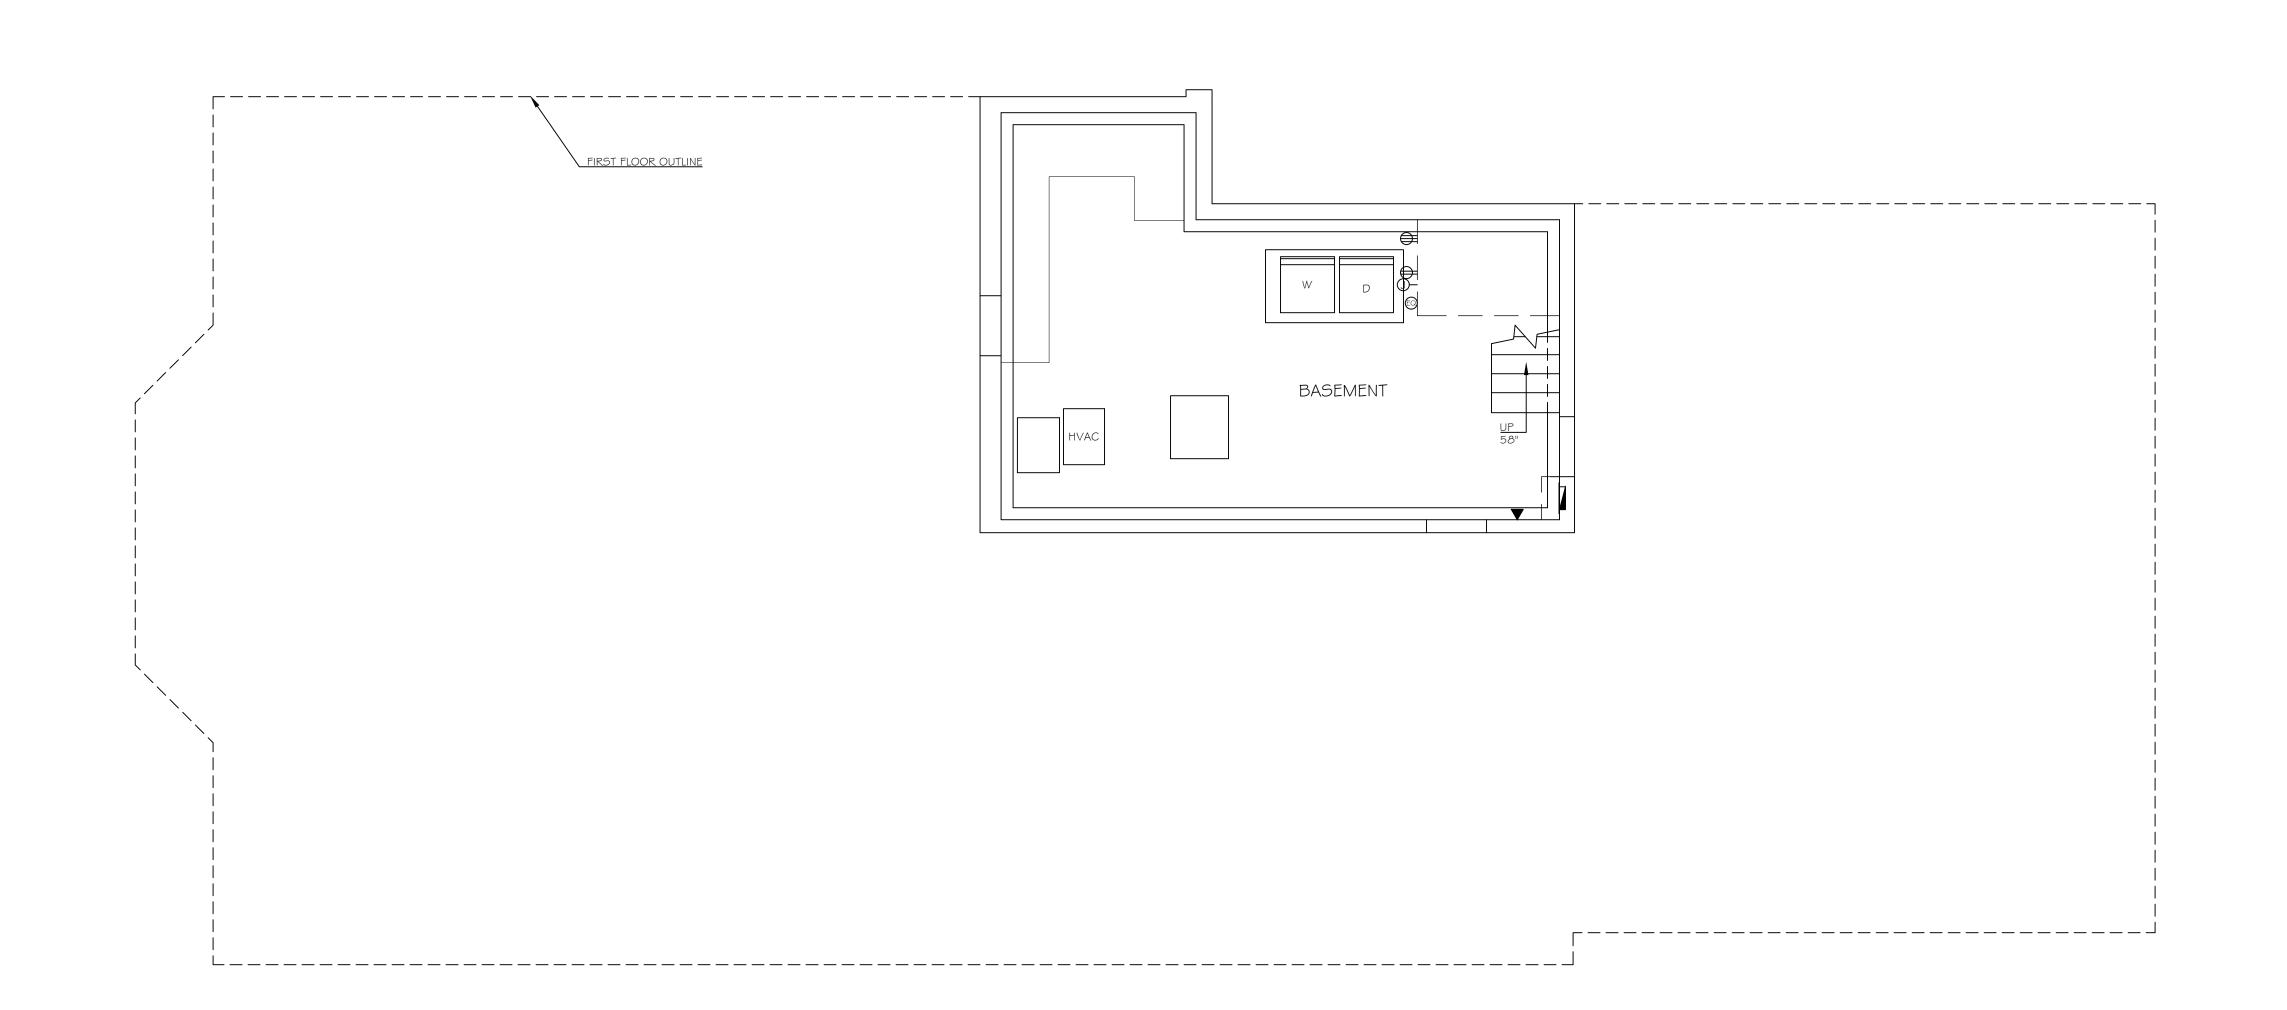

LEGEND

- ← SWITCH
- \rightarrow = SINGLE OUTLET
- ⇒ = DUPLEX OUTLET ■ = QUADRUPLEX OUTLET
- ⇒ = 220V OUTLET
- 😝 = FLOOR DUPLEX OUTLET
- # = FLOOR QUADRUPLEX OUTLET == GFCI DUPLEX OUTLET
- =⊖ = SPECIAL PURPOSE OUTLET -□• = WALL MOUNT CAMERA
- -⊗= COVER PLATE ON WALL $-\bigcirc$ = THERMOSTAT
- -∅ = AUDIO VOLUME CONTROLS $-\bigcirc$ = SPEAKER - WALL
- \Box = DISCONNECT SWITCH ⊢O = WALL-MOUNTED FIXTURE
- == FLUORESCENT LIGHT WALL = ELECTRICAL PANEL - FLUSH
- = ELECTRICAL PANEL MOUNTED ■ TELEPHONE JACK
- -<->
 ← CABLE JACK
- DATA/INTERNET JACK -⊚ = CABLE TV JACK
- -⊕ = POWER POLE
- -® = BLANK
- -⊚ = AUDIO / VIDEO $-\otimes$ = ROUTER
- -**⊘** = SECURITY KEY PAD
- -® = REMOTE DOOR RELEASE
- -Ø = SENSOR
- -© = CONDUIT **-**○ = J-BOX



MEASUREMENTS

3626 E. PACIFIC COAST HIGHWAY | 2ND FLOOR LONG BEACH CA | 90804 T 562.621.9100 F 888.698.2966 WWW.PPMCO.NET



PREPARED FOR

ARCHITECT PLANNING

PROJECT TYPE


ELECTRICAL PLAN

PROJECT NAME

PROJECT ADDRESS

1234 CHERRY TREE BOULEVARD LONG BEACH, CA 90000

All plans created by Precision Property
Measurement Ltd "PPM" are made exclusively
for landscaping purposes (Cal. Bus. 4 Prof.
Code §8727). All site plans created by PPM do not
involve the determination of any property line, and as
such do not constitute land surveying
(Cal. Bus. 4 Prof. Code §§8726-8727). In
addition, PPM services and plans do not constitute
civil engineering (Cal. Bus. 4 Prof. Code §§6702-6704),
and thus should not be used for any studies or activities
defined as civil engineering (Cal. Bus. 4 Prof. Code
§6731). All floor plans created by PPM are intended to
be used as a reference for design and construction and
should not be considered a substitute for the services of
a licensed structural engineer or licensed architect. PPM
makes every reasonable effort to ensure the accuracy of
the information found in our plans. However, every
As-Built drawing inherently contains errors to some
degree. It is the duty of the architect, contractor,
designer or other licensed professional, as a consultant
to the property owner, to determine the suitability of the
As-Built plans prior to construction. Measurements should
be field confirmed before commencing construction, in the
event that an error is found on a plan, PPM's liability is
limited to the amount of the fee paid to PPM.

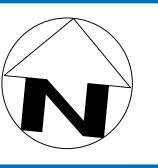

 $\frac{1}{4}$ " = 1'-0" PROJECT

12345 APPROVED BY

CT DATE

9/18/19